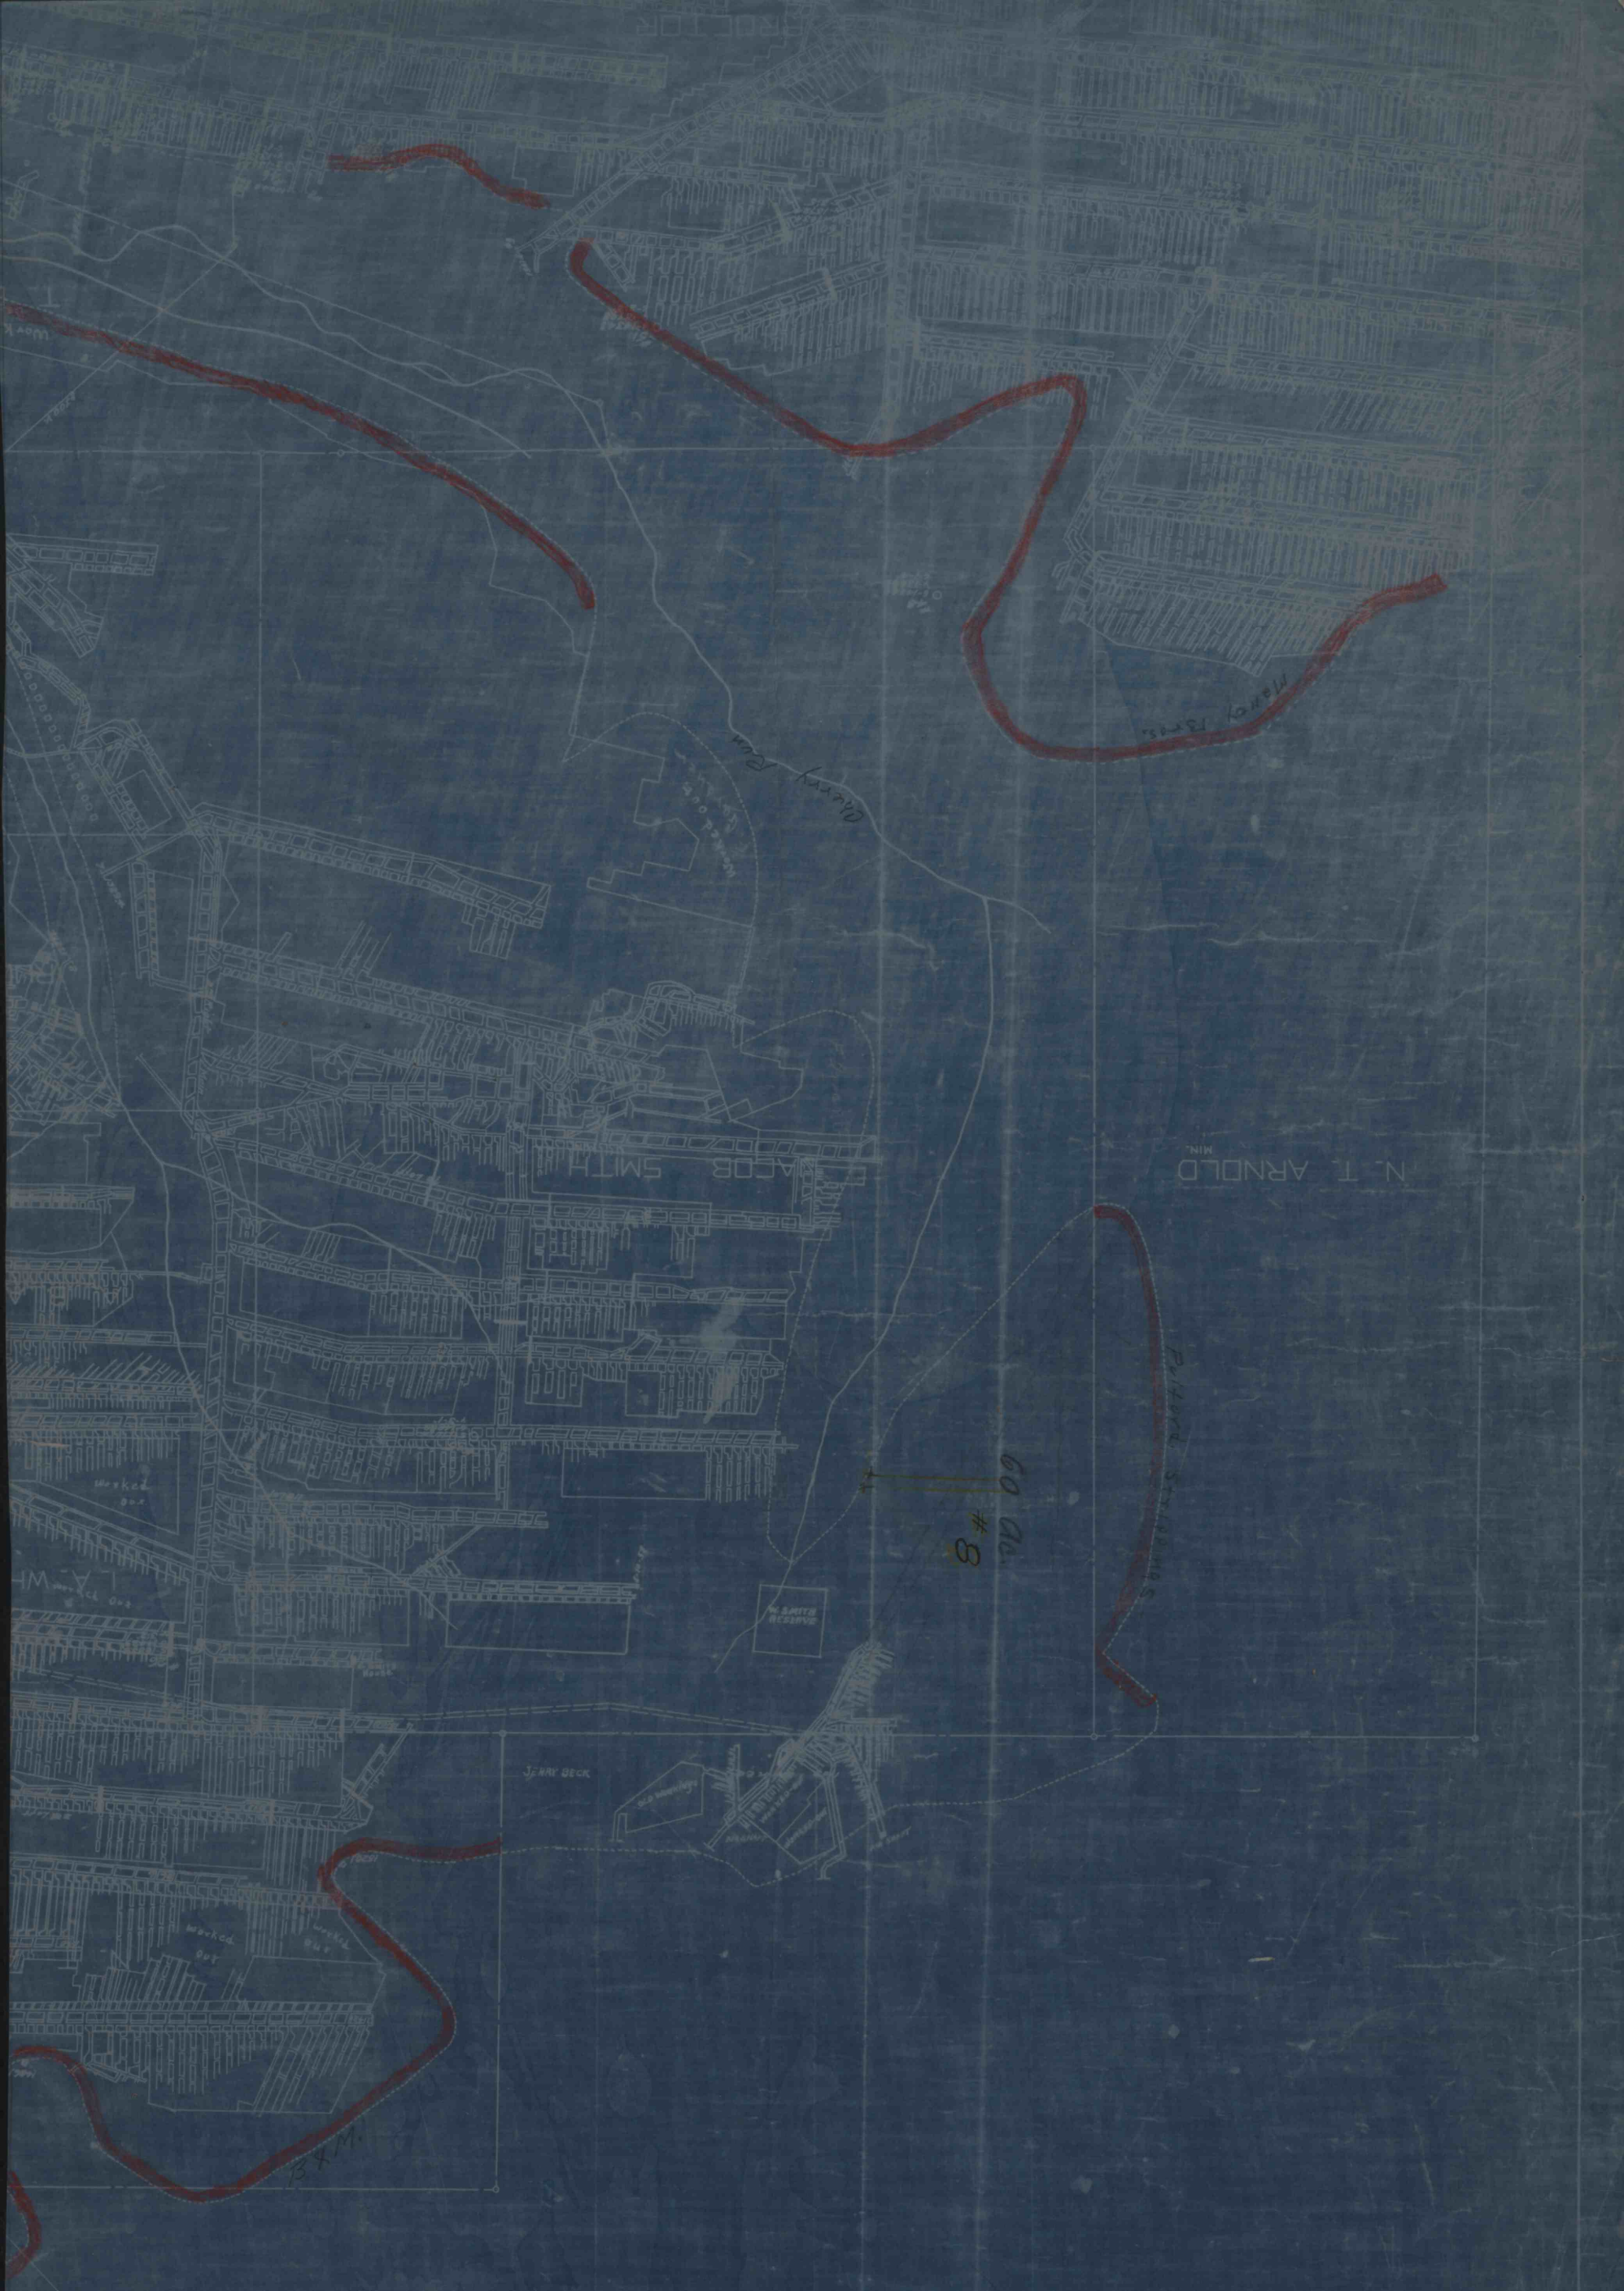
N. T. ARNOLD
MIN.
ACOR SMITH
Worked Out
Worked Out
Worked Out
Worked Out
JENNY BECK
Old Workings
Oakley Run
Many Runs
Southern Portion
69 Dr. #8
3 X M.

I MAPS 16224