


UNDERMINE COAL MINING CO. - CO. HARBOR LINE
HARBOR LINE

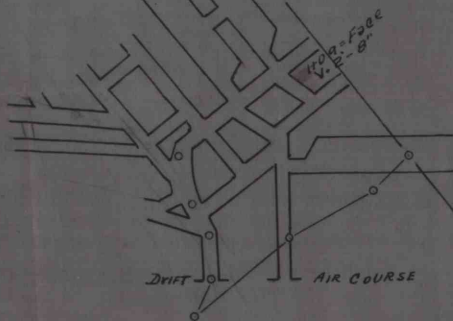

SHERRY MINE.
ELK CO. JAY TWP. FORGE PA.
Scale 1-INCH = 100 FT.
DEC. 24 - 1953

1 MAPS #16231

BOOK #23