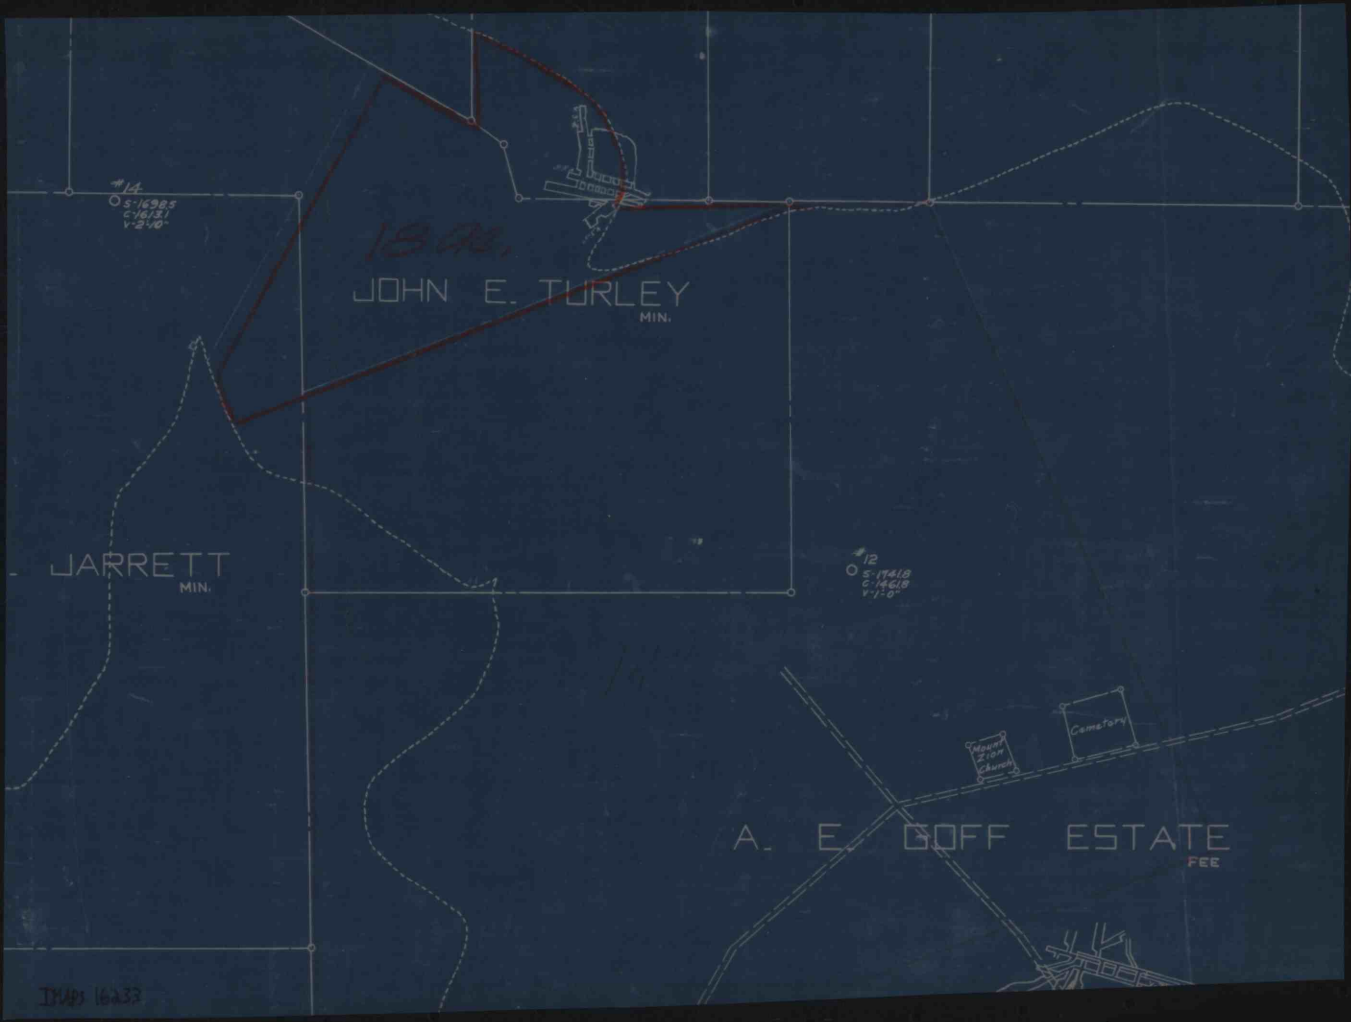
#14
S-16985
C-16131
V-2'-10"
1942
JOHN E. TURLEY
MIN.
JARRETT
MIN.
#12
S-17418
C-14618
V-1'-0"
Mount Zion Church
Cemetery
A. E. GOFF ESTATE
FEE

IMAG 16233