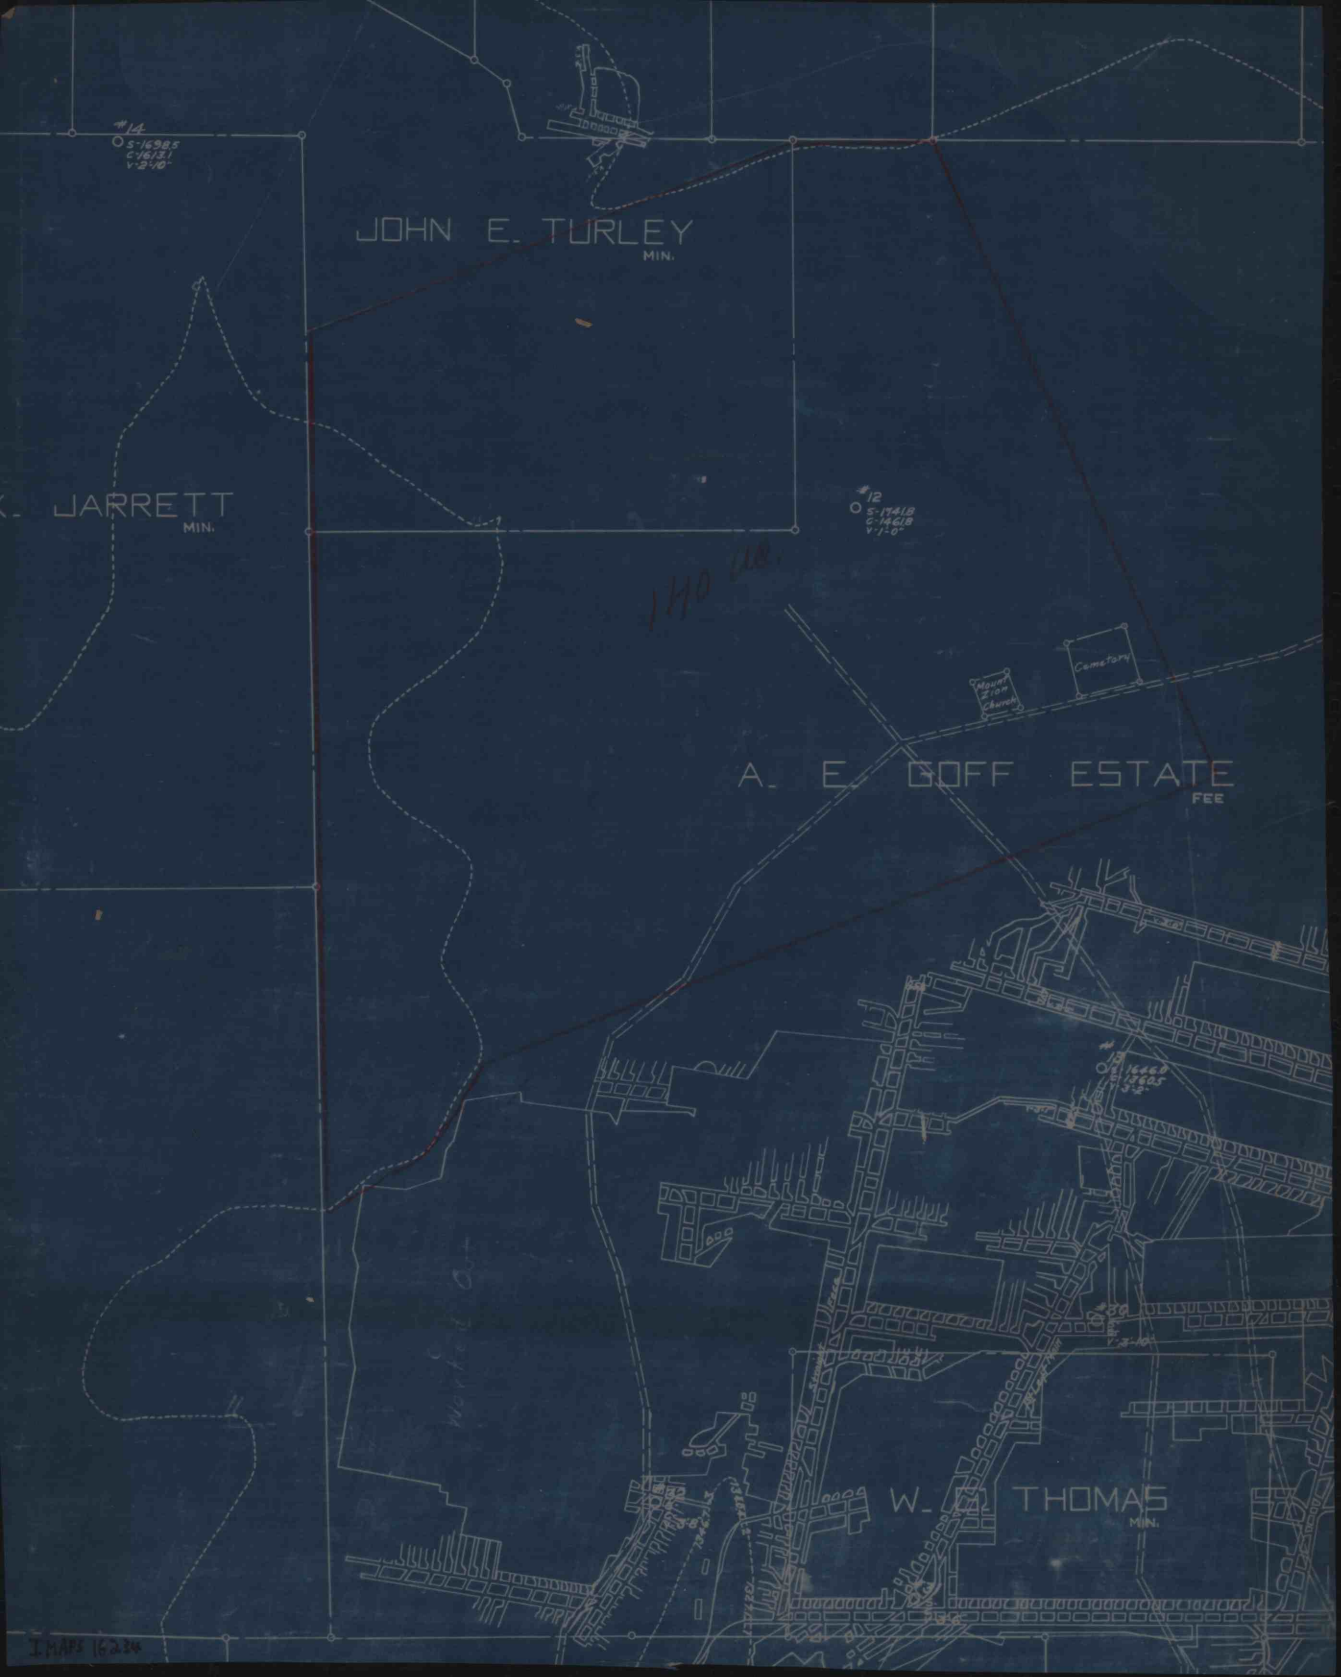
#14
S-16985
C-16131
V-2'10"
JOHN E. TURLEY
MIN.
K. JARRETT
MIN.
#12
S-17418
C-14618
V-1'-0"
140 ac.
Mount Zion Church
Cemetery
A. E. GOFF ESTATE
FEE
#13
S-16660
C-14605
V-2'
W. M. THOMAS
MIN.

IMAPS 16234