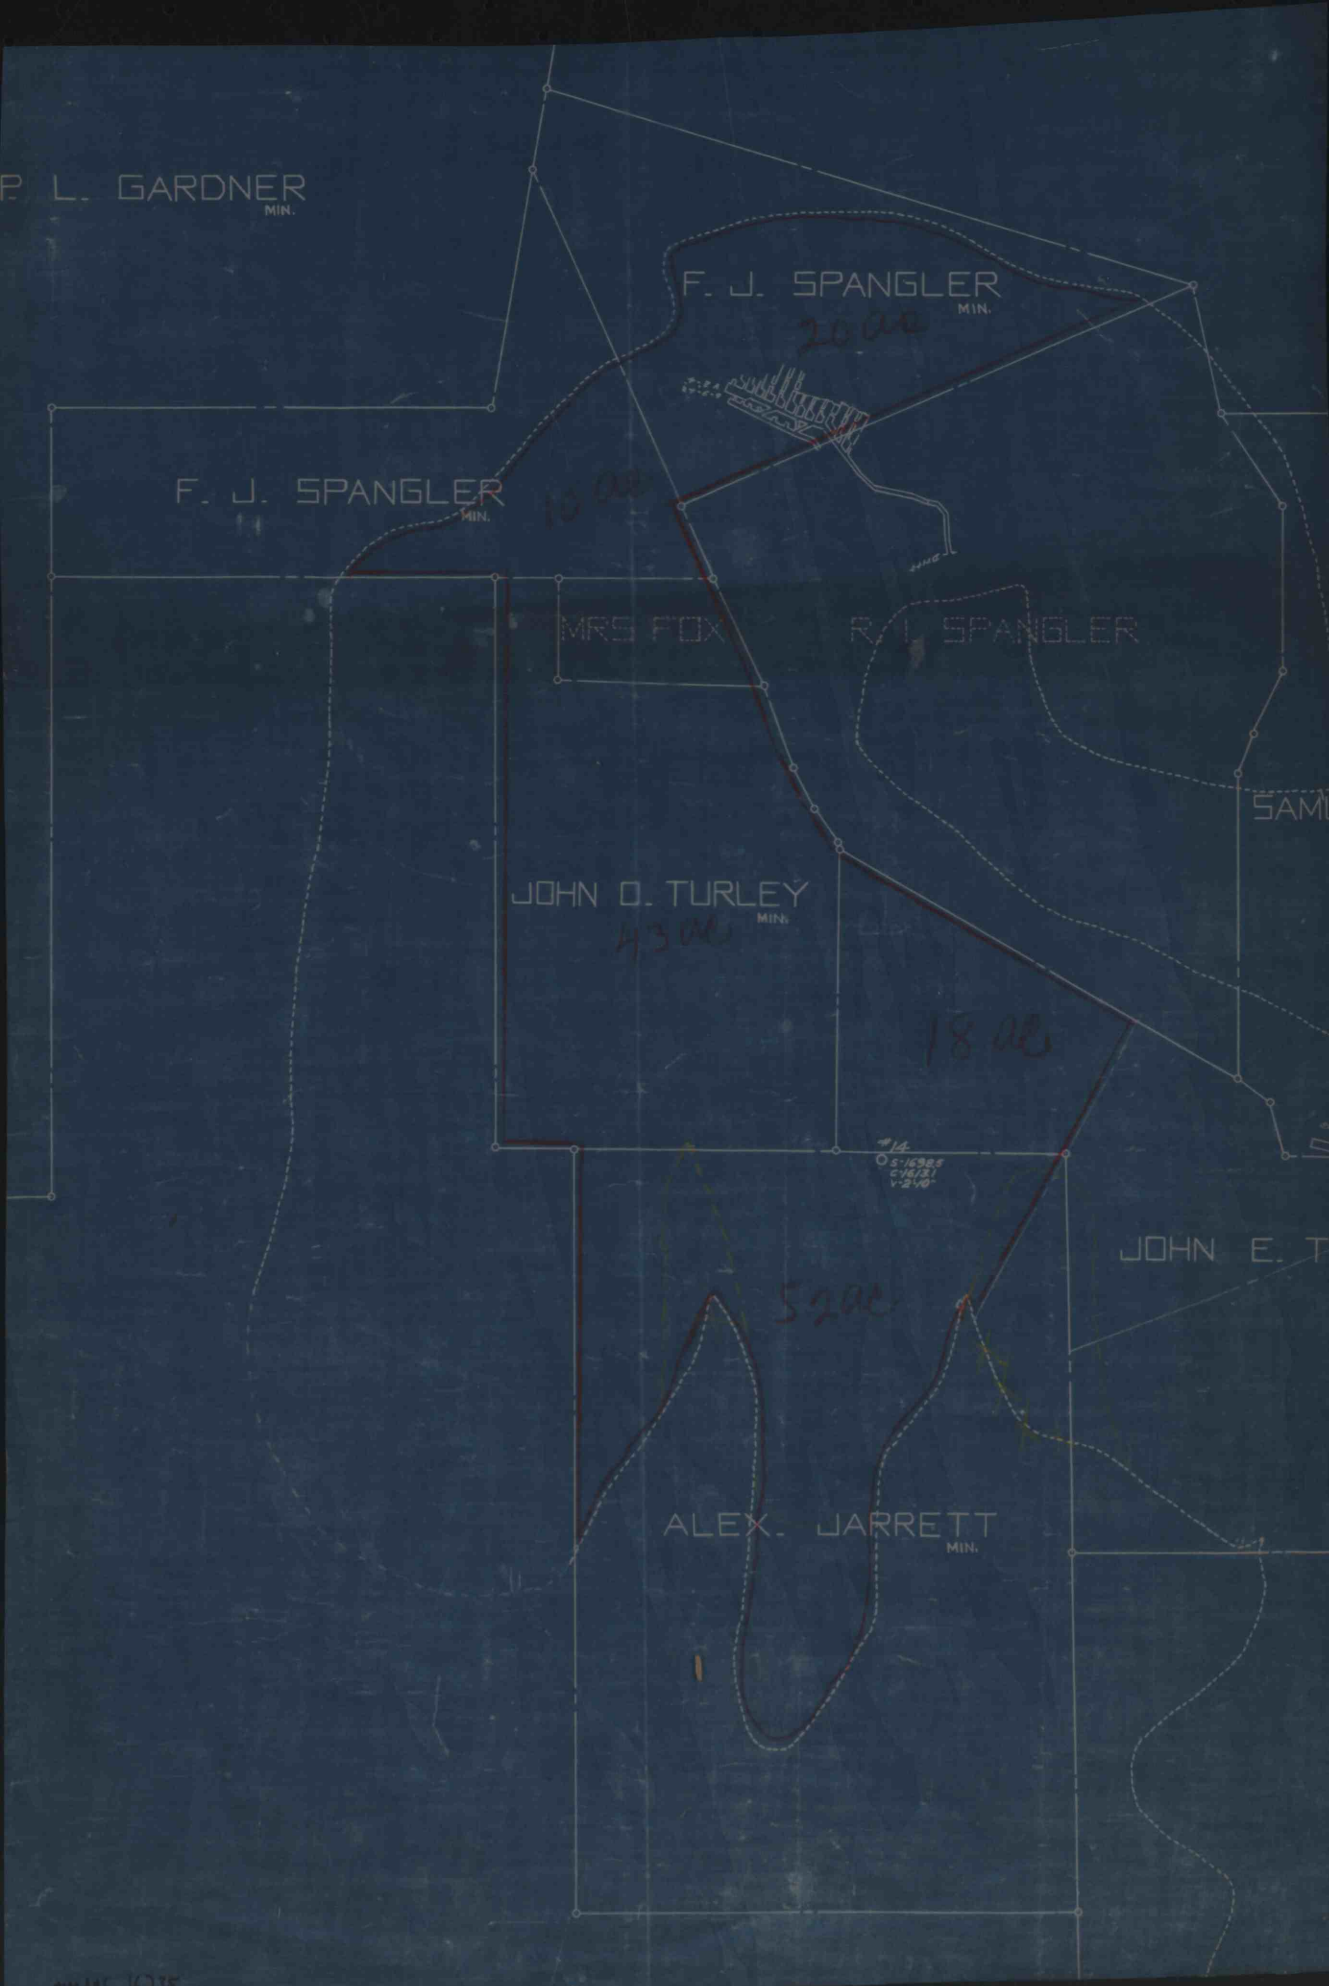
P. L. GARDNER
MIN.
F. J. SPANGLER
MIN.
20 ac
F. J. SPANGLER
MIN.
10 ac
MRS FOX
R. I. SPANGLER
SAM
JOHN O. TURLEY
MIN.
43 ac
18 ac
#14
S-16.985
C-14.131
V-2.140
JOHN E. T
52 ac
ALEX. JARRETT
MIN.

IMAPS 16215