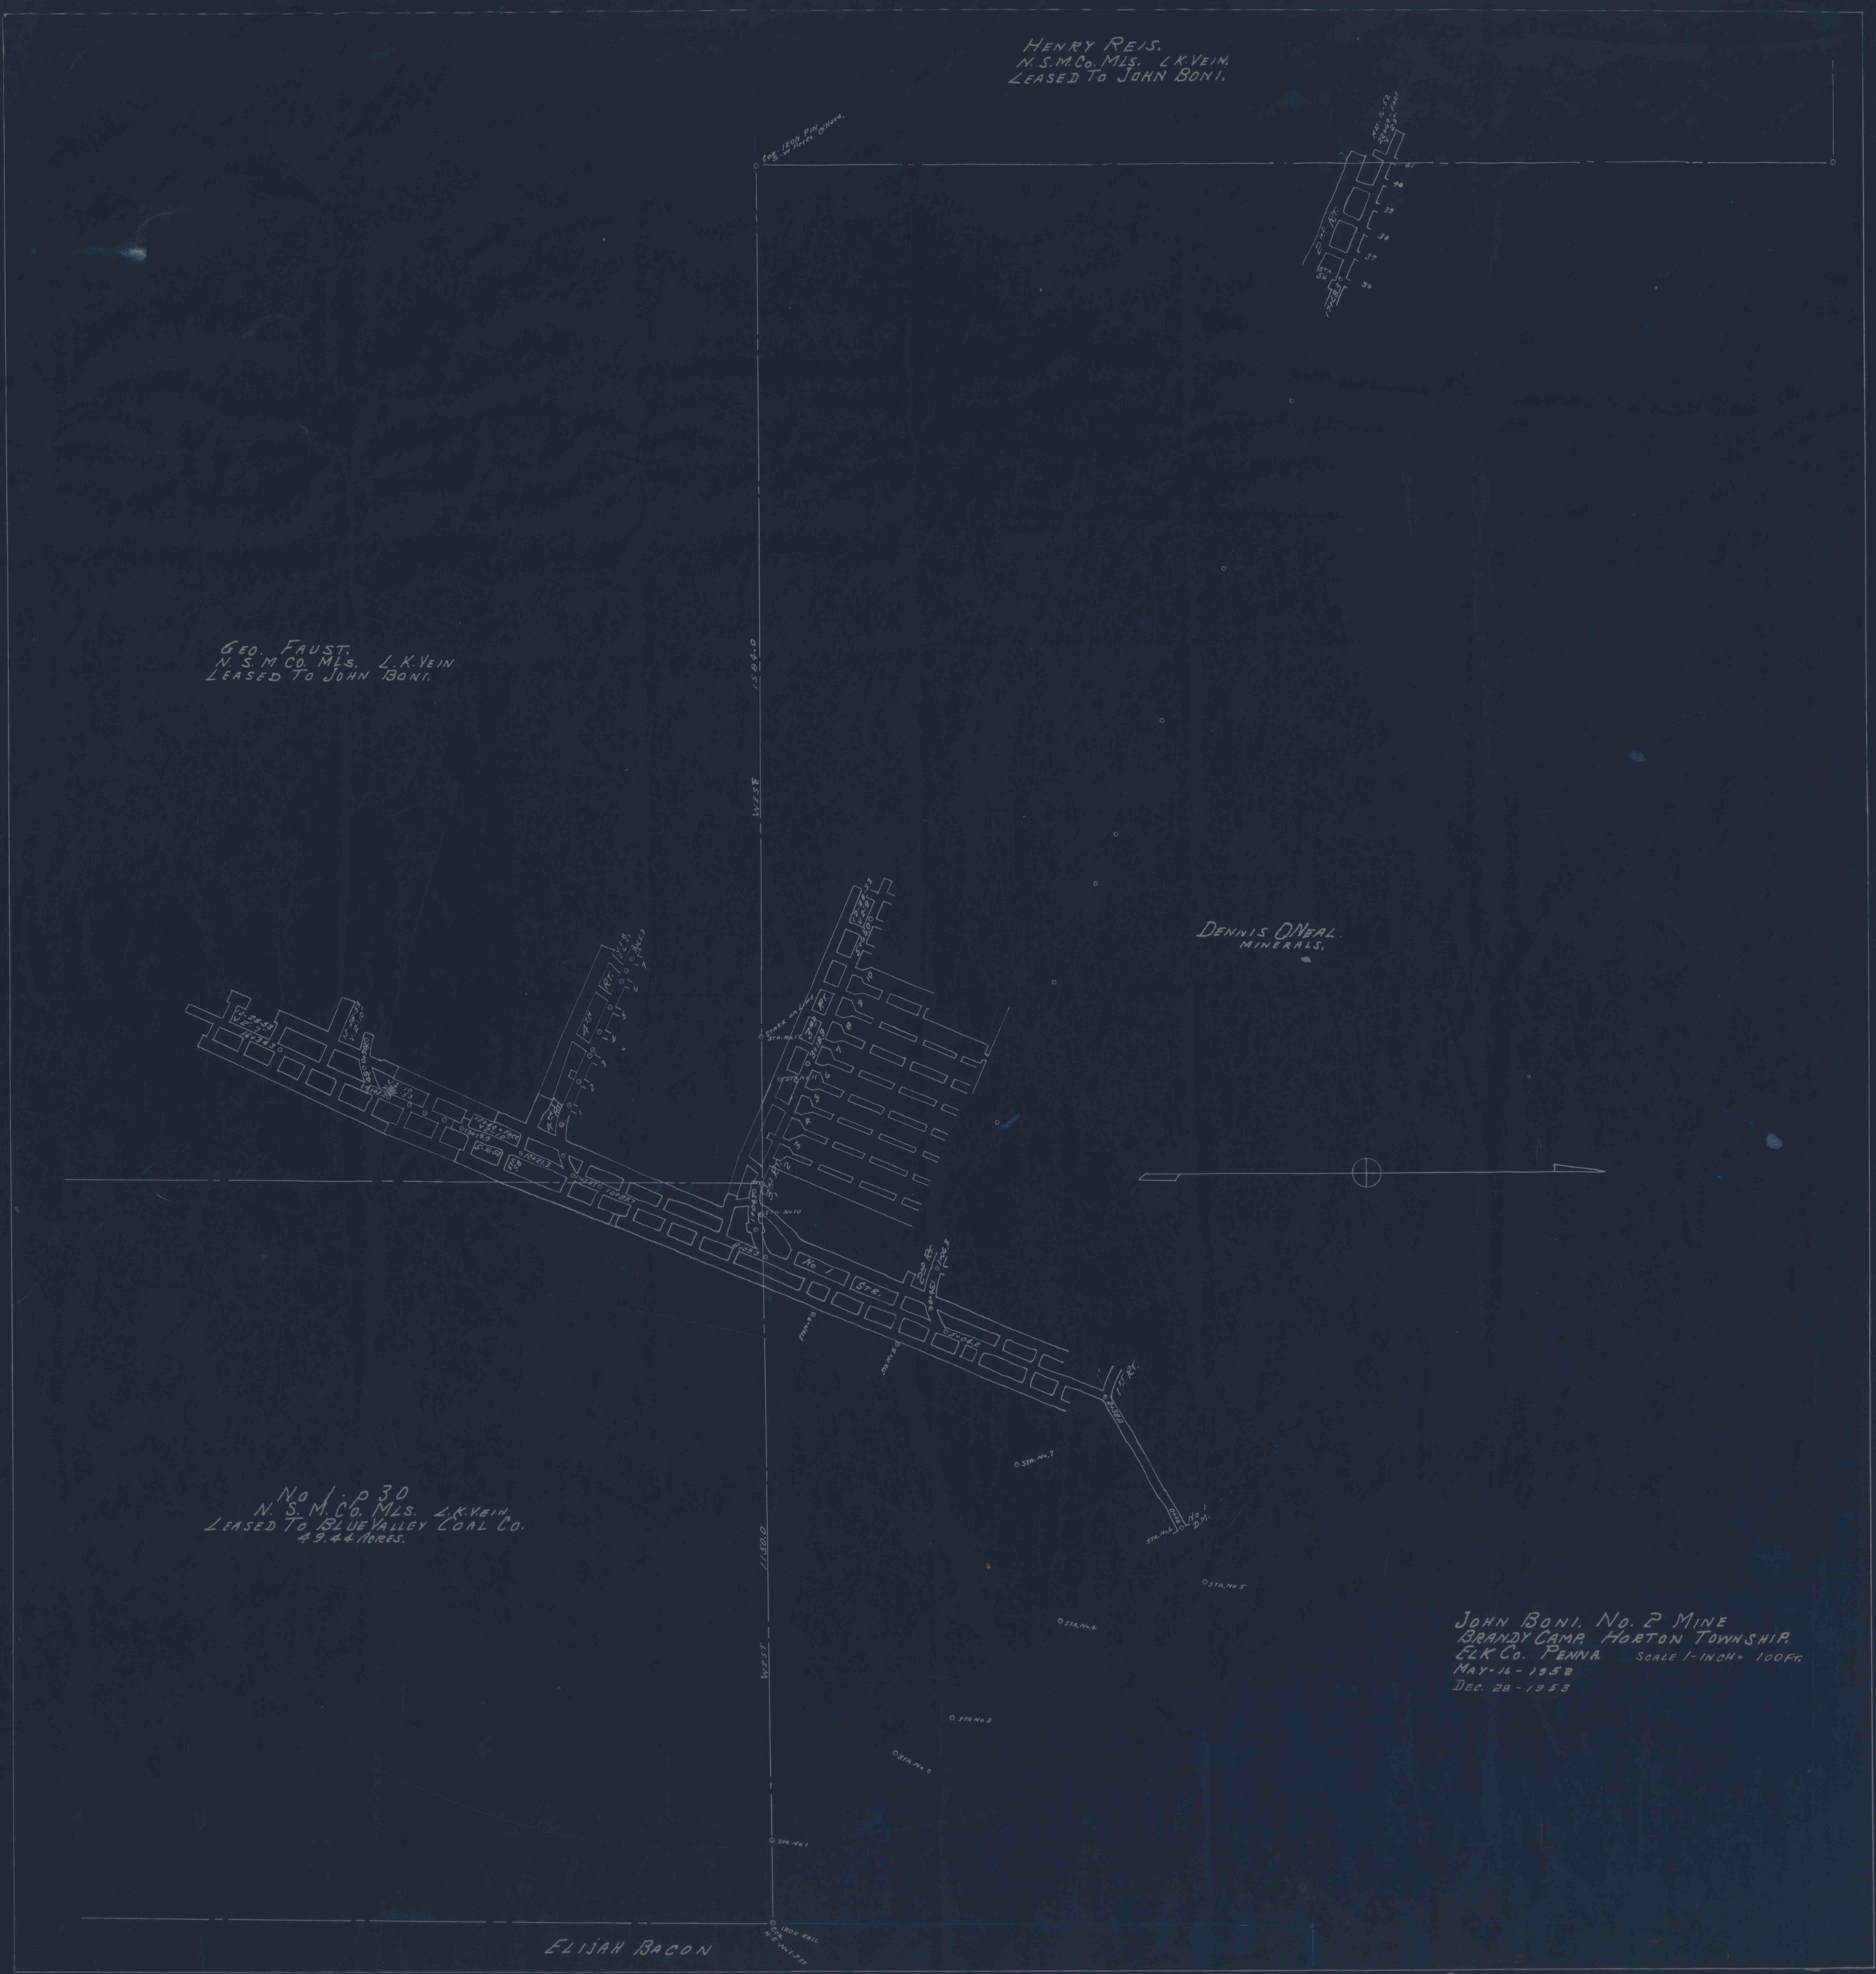
HENRY REIS.
N. S. M. Co. MLS. L. K. VEIN.
LEASED TO JOHN BONI.
DENNIS O'NEAL
MINERALS.
GEO. FAUST.
N. S. M CO. MLS. L. K. VEIN
LEASED TO JOHN BONI.
No 1 : P 30
N. S. M. CO. MLS. L. K. VEIN
LEASED TO BLUE VALLEY COAL CO.
49.44 ACRES.
JOHN BONI. No. 2 MINE
BRANDY CAMP. HORTON TOWNSHIP.
ELK Co. PENNA. SCALE 1-INCH = 100 FT.
MAY-16-1952
DEC. 28-1953
ELIJAH BACON
WEST
STA. No. 1
STA. No. 2
STA. No. 3
STA. No. 4
STA. No. 5
STA. No. 7
No 1
Str.
No 1 D.M.
1 FT. RR.
IRON RAIL