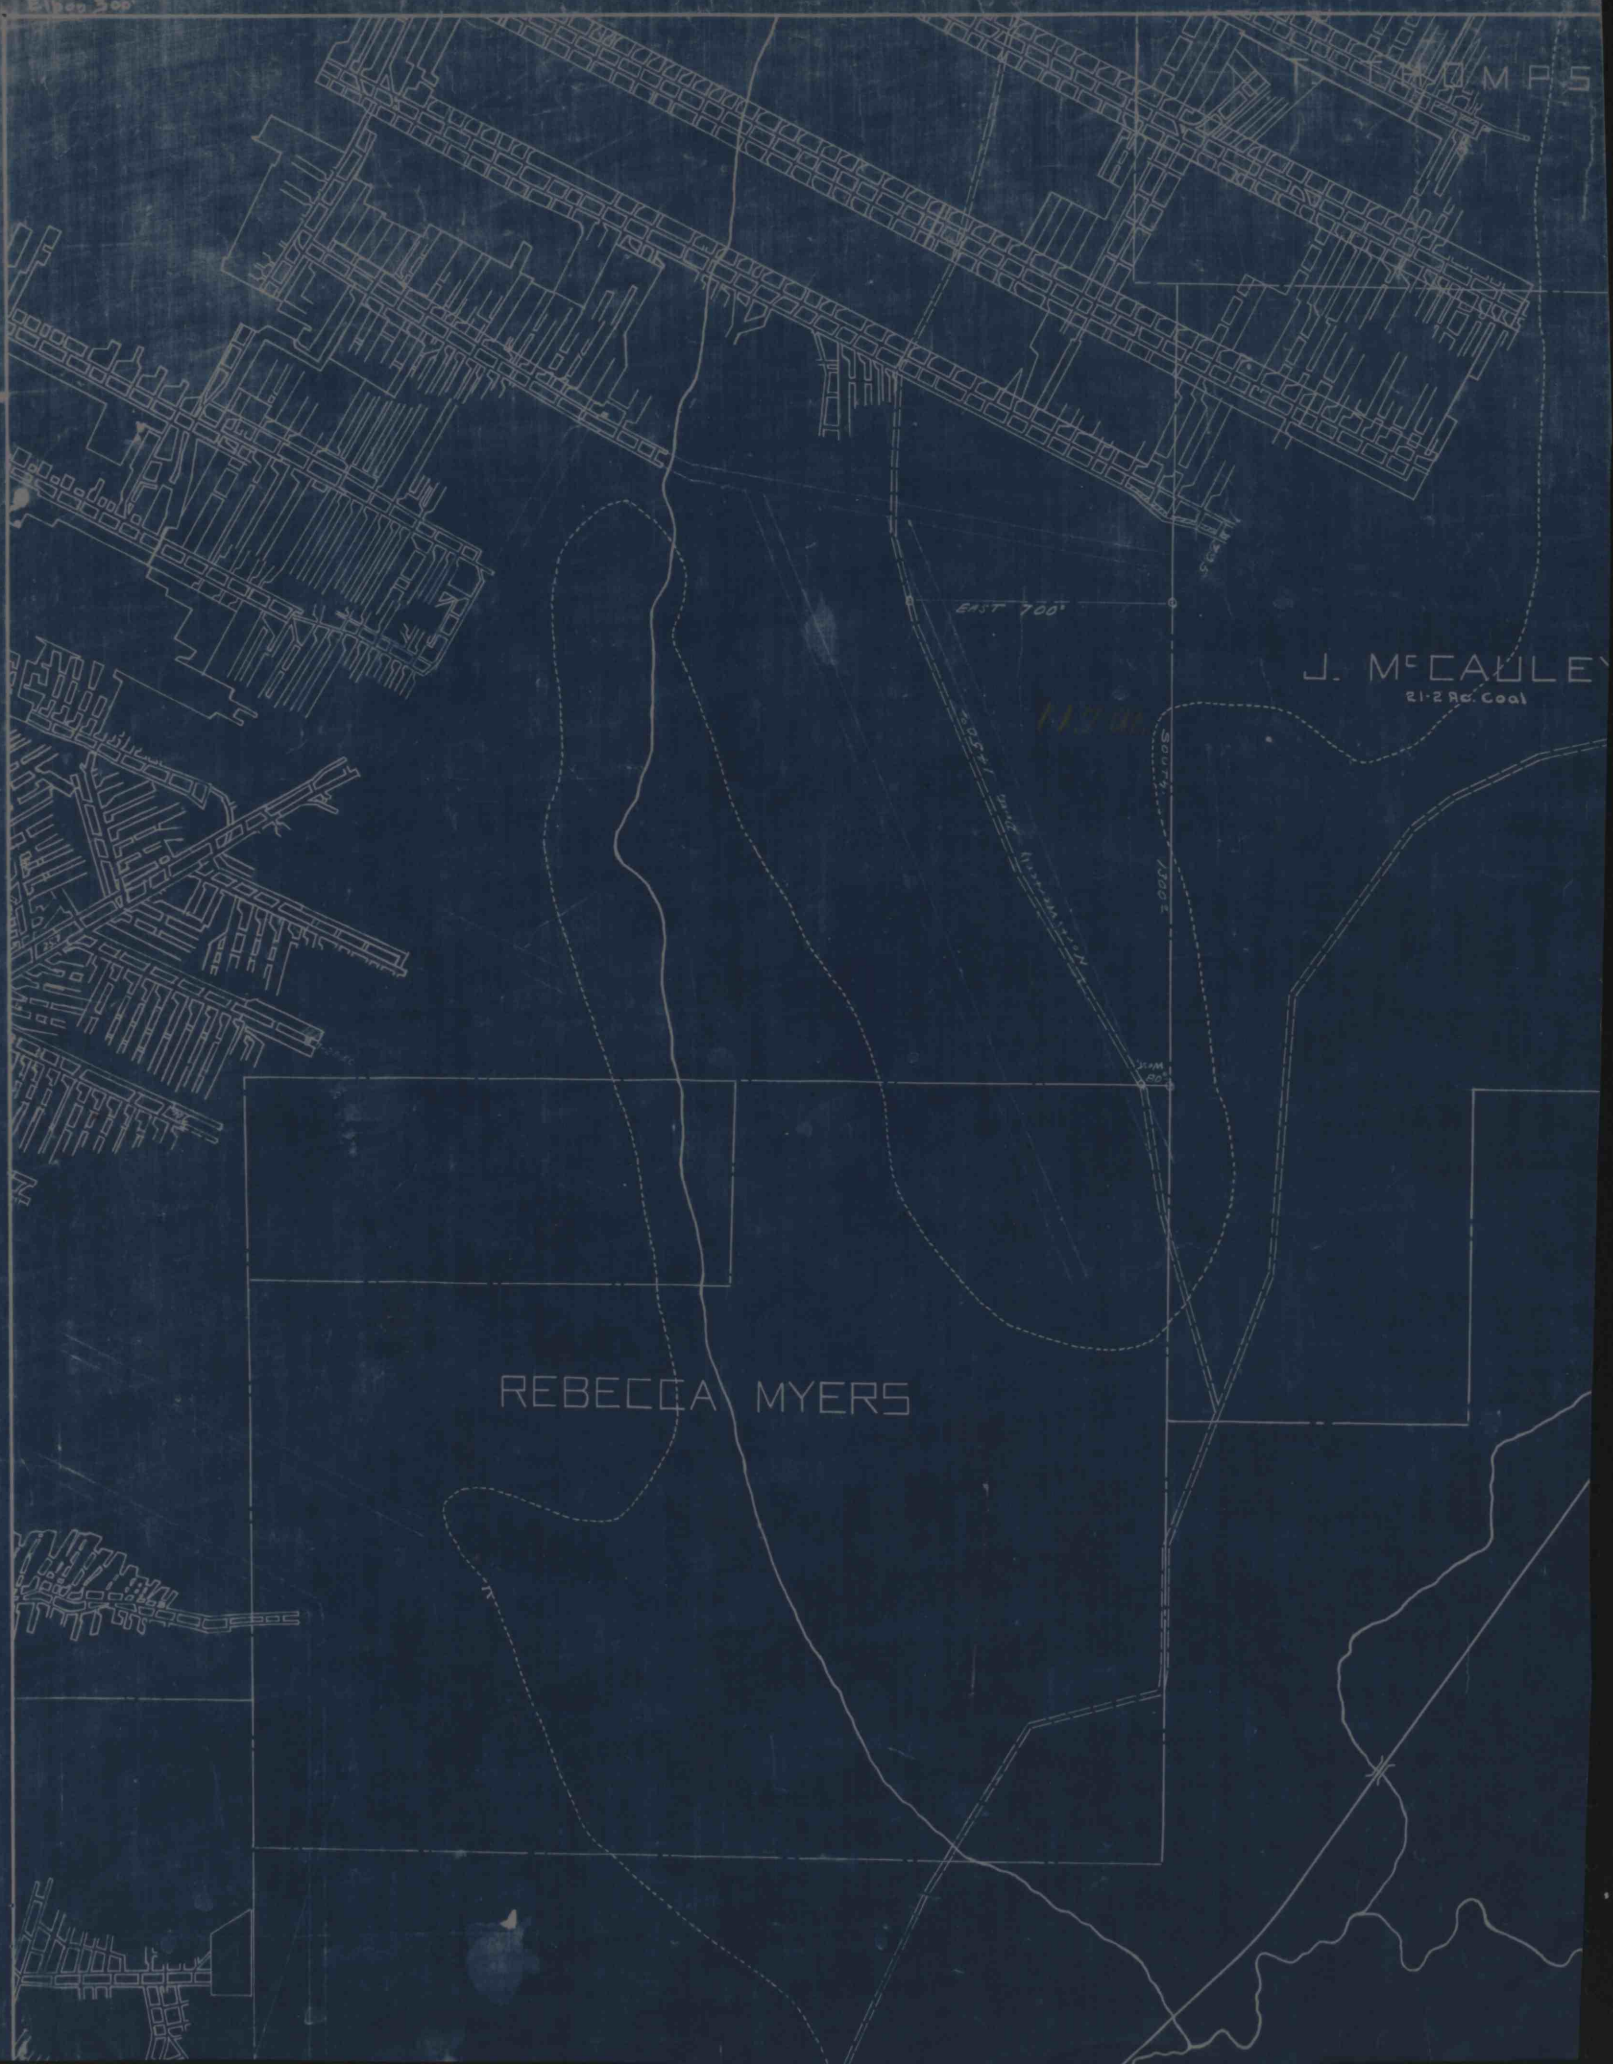IMAPS#16262