


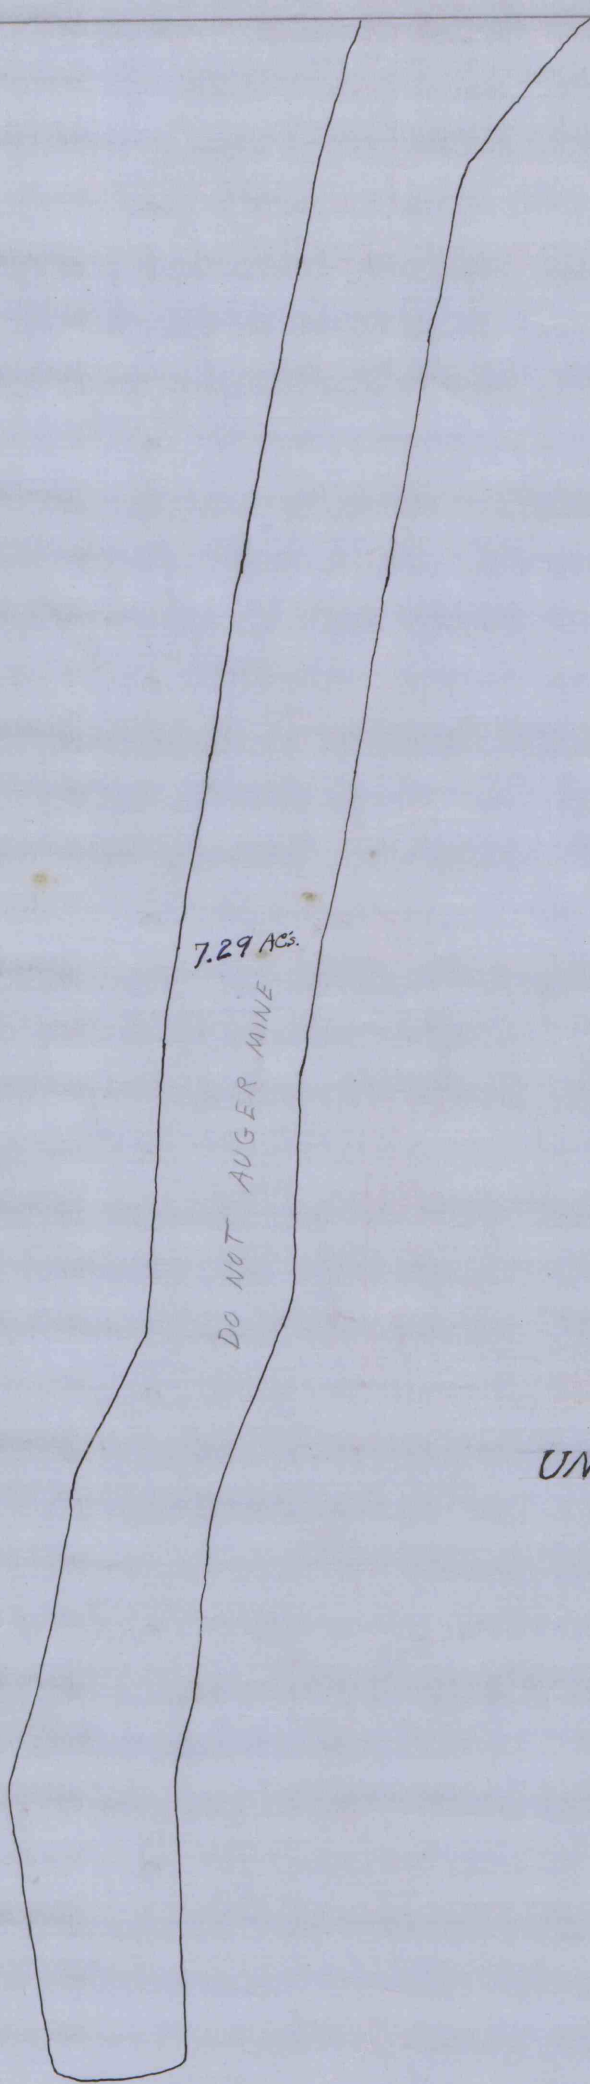

UNDERHILL COAL MINING CO.



WT. LINE

WT. LINE

WT. LINE

UNDERHILL COAL MNG. CO.

6.56 Acres.
235.75A' = 235.75A'

affected areas -
Underhill Coal Mining Co. 7.29 acs.
" " 6.56 acs.
Total 13.85 acs.
for tree planting

UNDERHILL COAL MINING CO.
SR. MAYIS, PA.
STRIP CUT - AREA.
SCALE 1" = 100 FT.
SURVEYED BY - S. BUCH.
APPROVED BY -
DATE - 6-13-58.