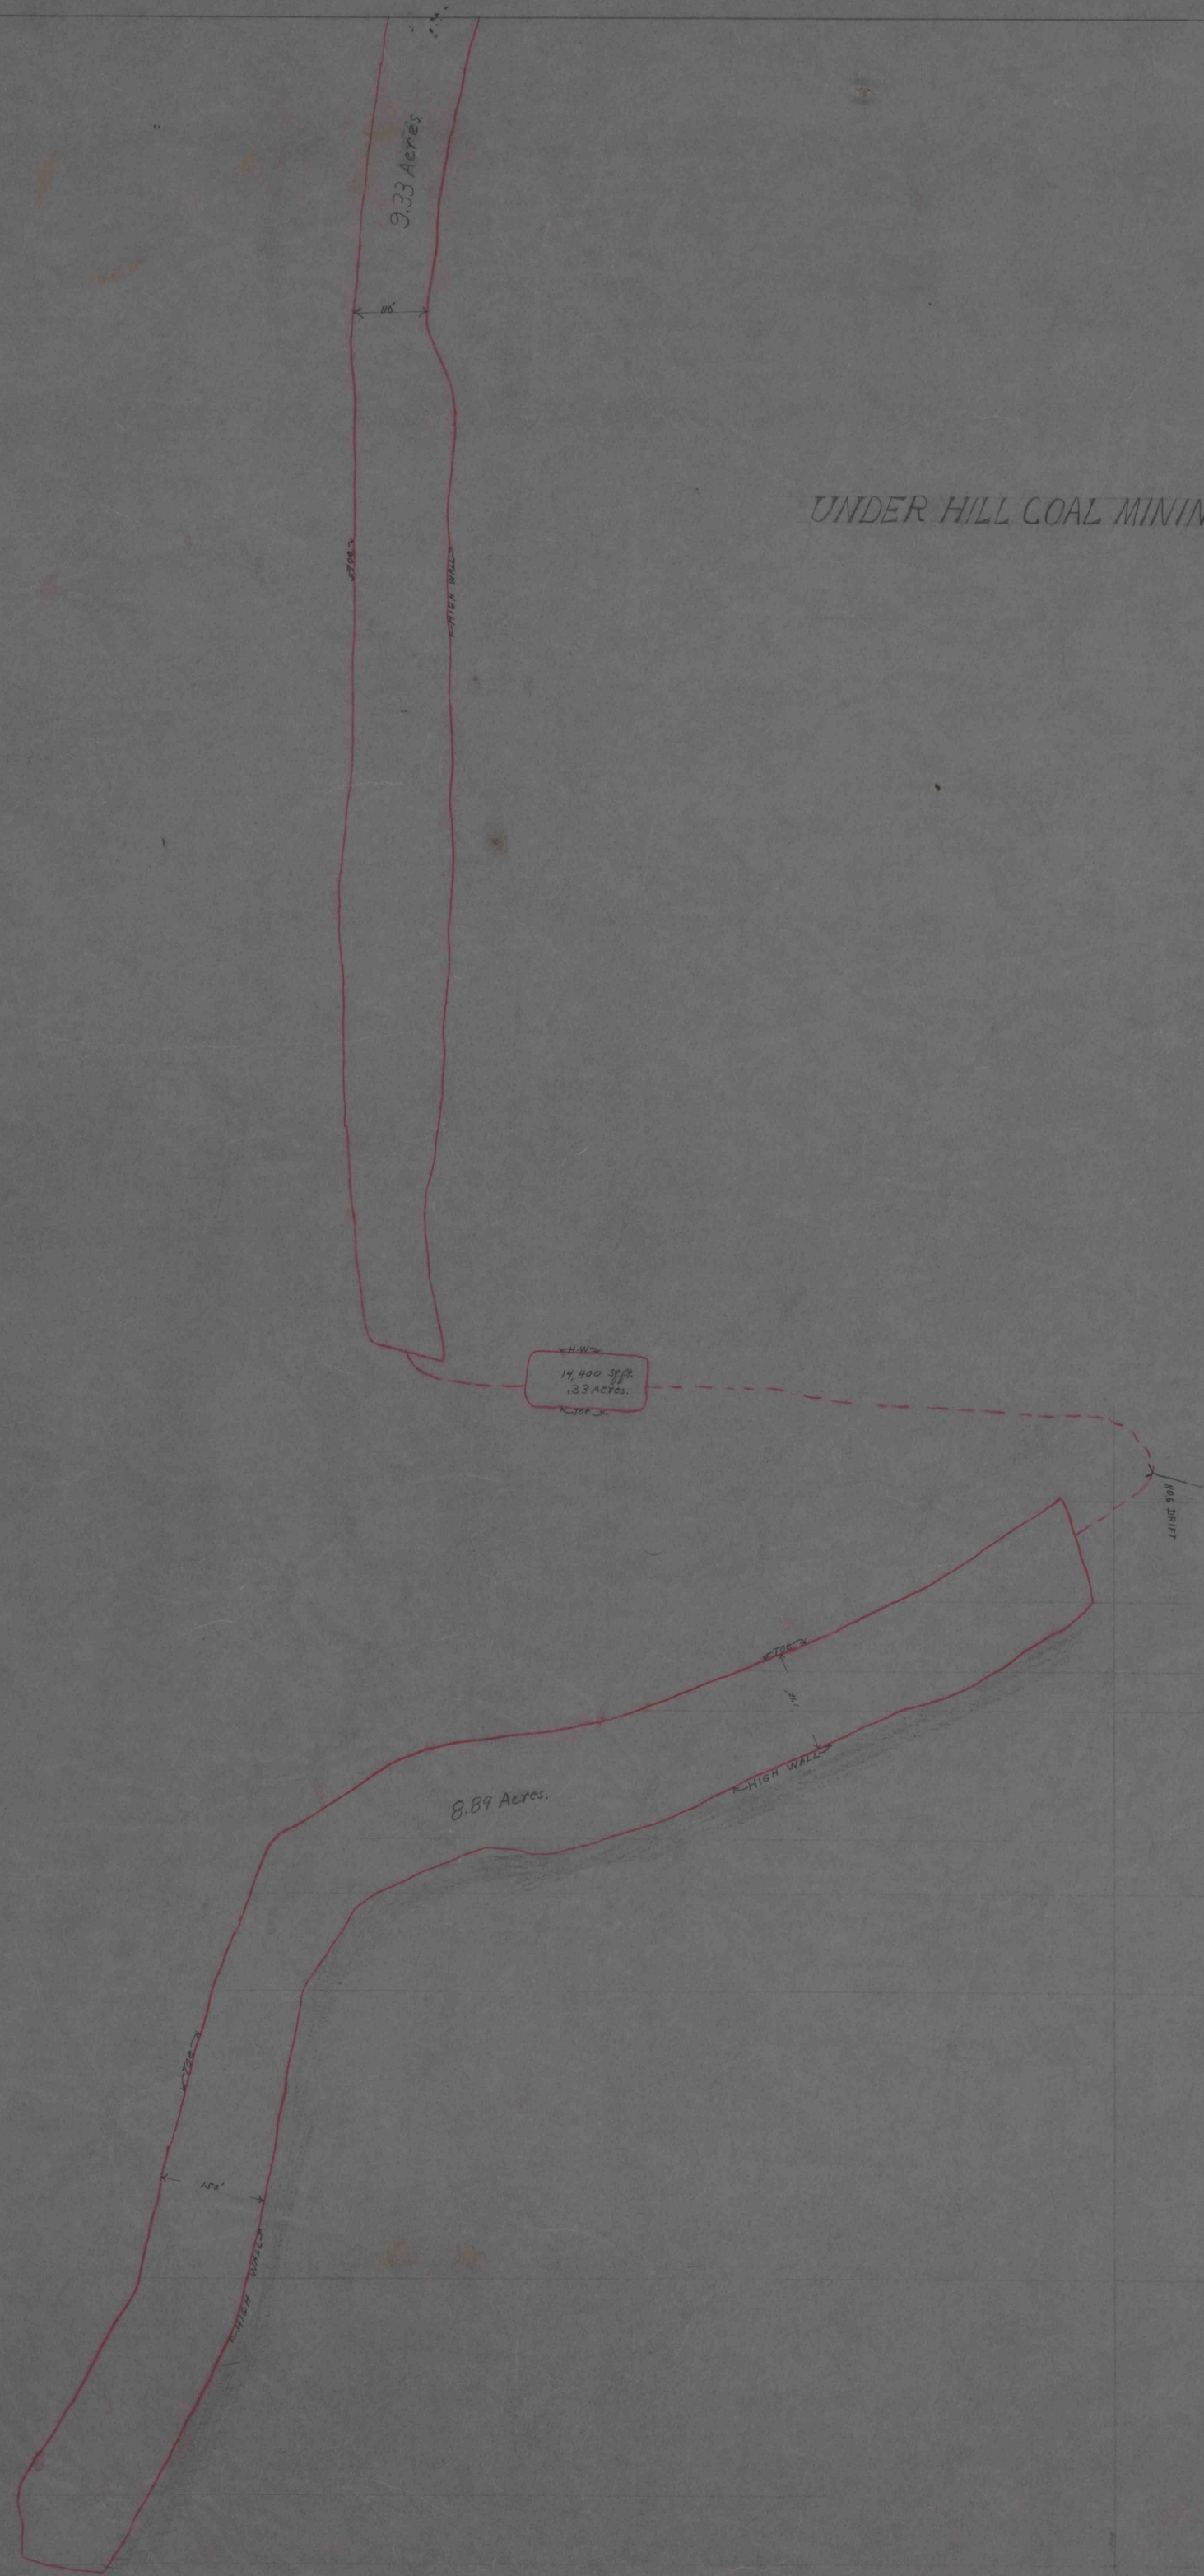

UNDER HILL COAL MINING CO.

Affected area.

Underhill Coal Mining Co — 8.89 Acres
" " " " — 9.33 "
" " " " — 9.29 "
" " " " — 5.52 "
" " " " — .33 "
Total 33.36 "

AUGER MINED 1964-65 & AND BACK FILLED FOR PLANTED

PLANTED - 1958

UNDERHILL COAL MNG. CO.
STRIPMINE AREA
SCALE - 1 INCH = 100 FEET
Surveyed by — J. Burch
Approved by —
DATE OF SURVEY 6-13-58

IMAPS 16267