


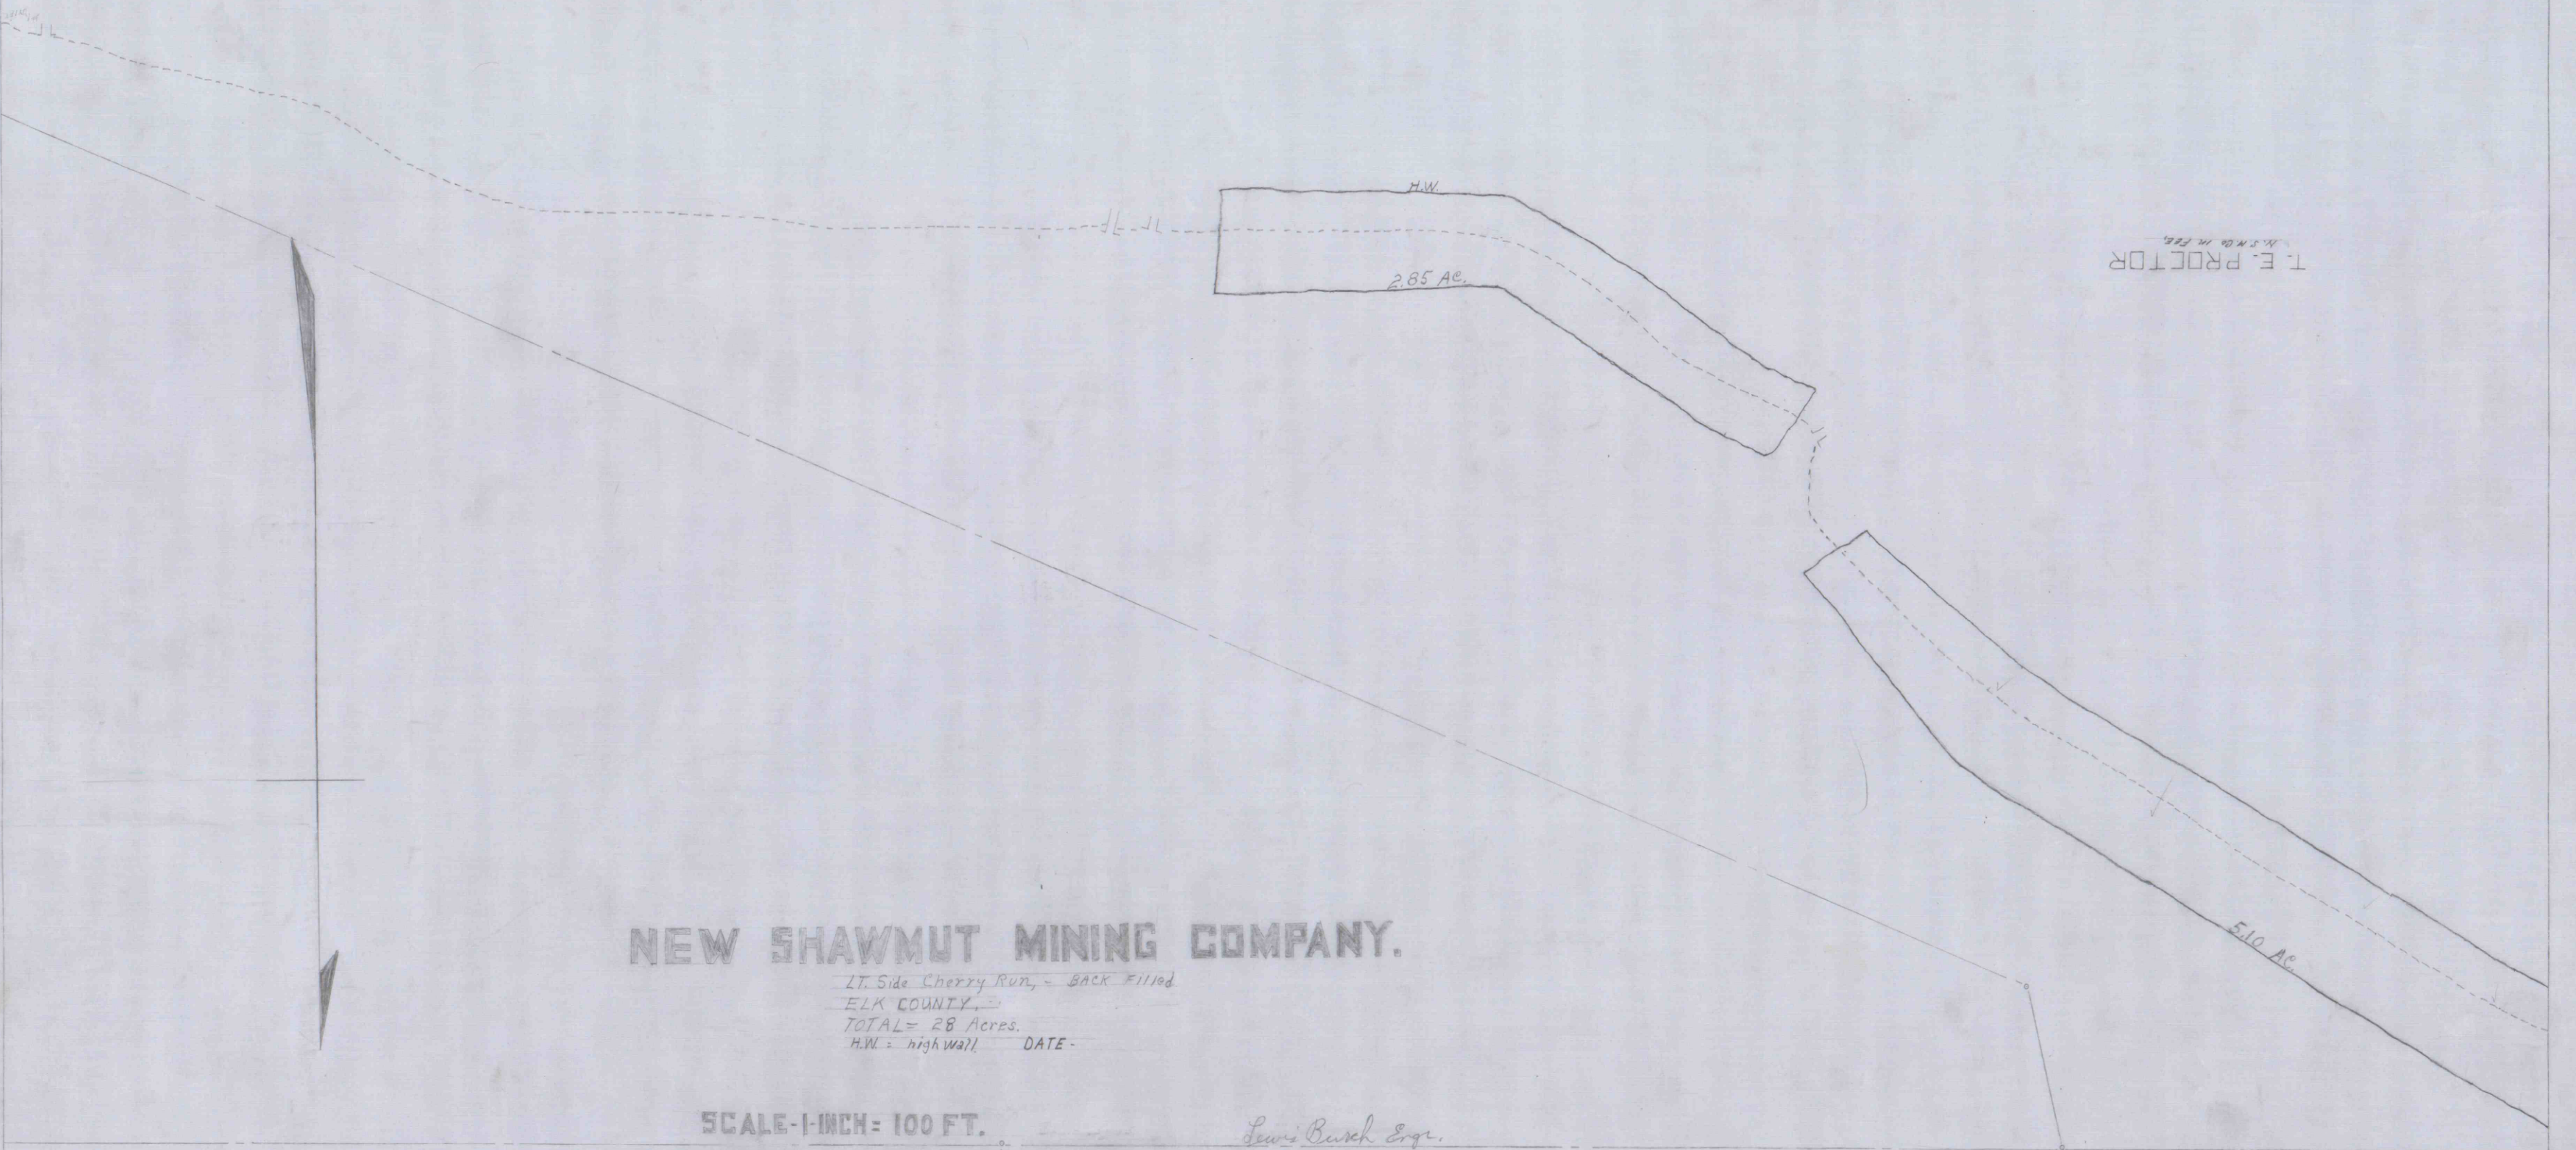

T. E. PROCTOR
N. S. W. 1/4 M. 12 E.

NEW SHAWMUT MINING COMPANY.

LT. Side Cherry Run, - BACK Filled
ELK COUNTY, -
TOTAL = 28 Acres.
H.W. = high wall. DATE -

SCALE - 1-INCH = 100 FT.

Lewis Busch Engr.