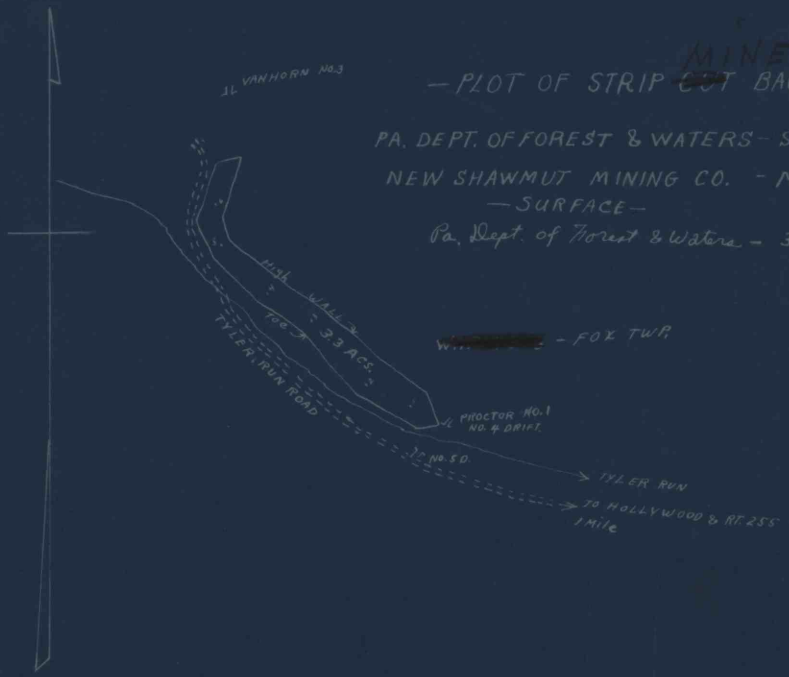

NEW SHAWMUT MNG CO.
ST. MARY, PA.
FOX TWP. - ELK CO
SCALE - 1" = 400'
DATE - 11-30-61
SURVEYED BY L.H.G.

P1

IMAPS # 16272