


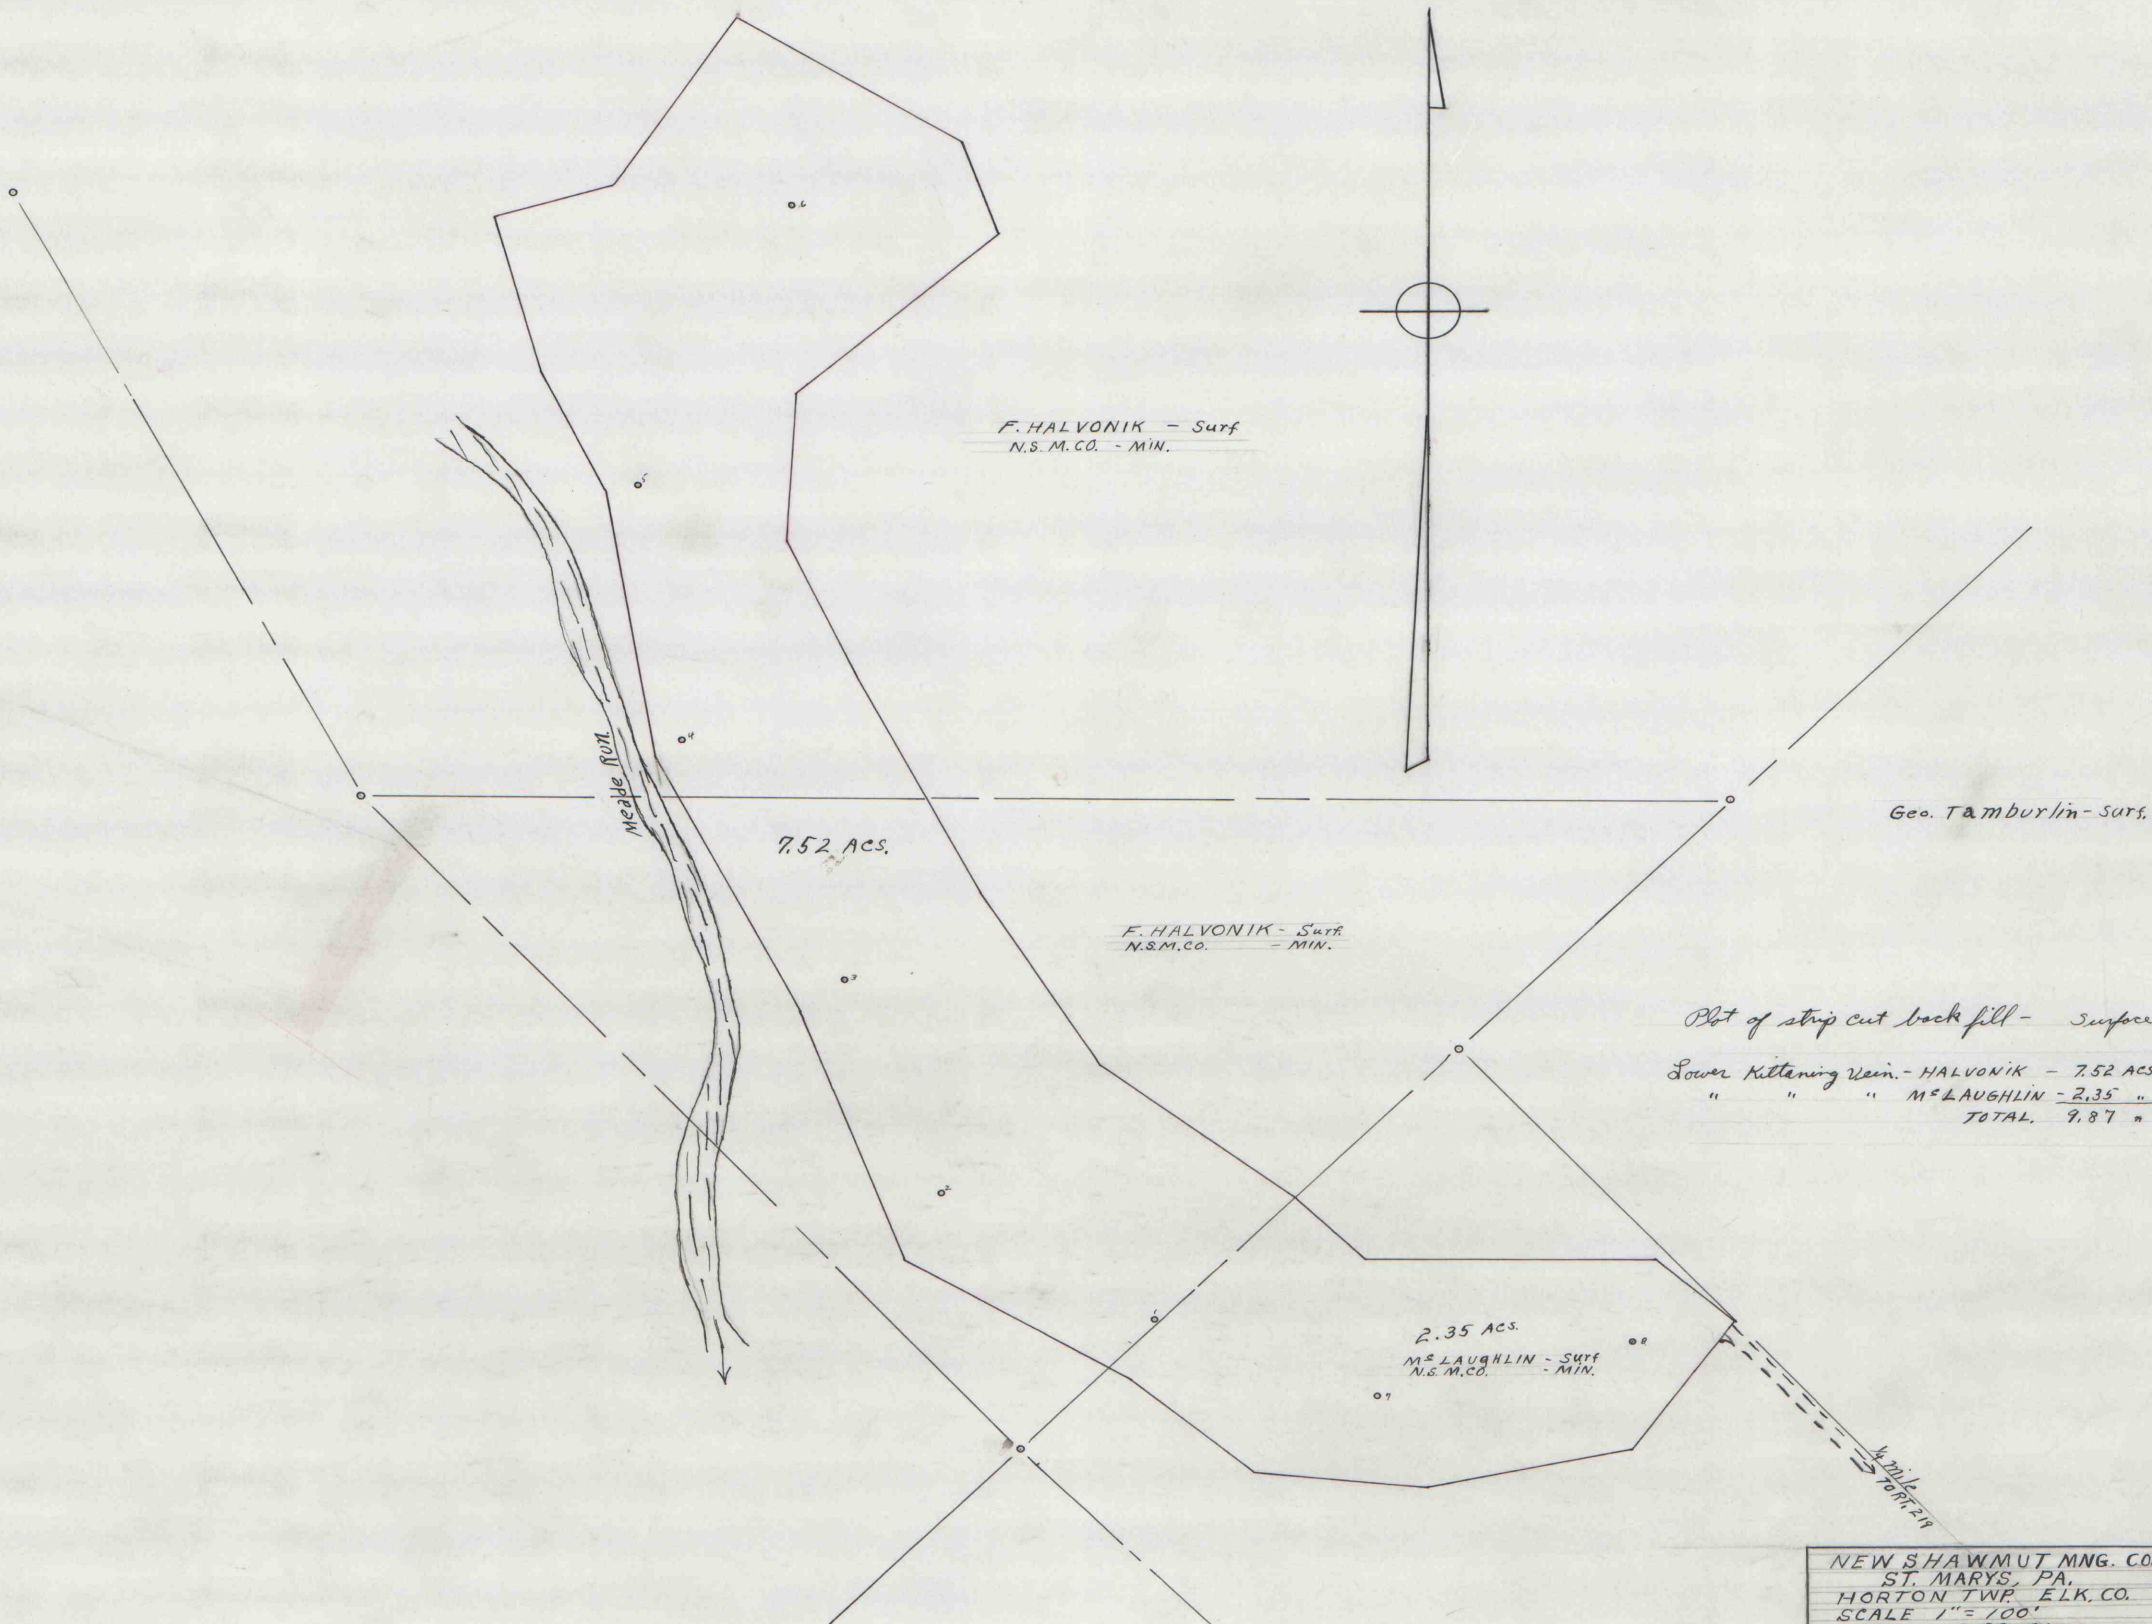

1 MAPS # 16278

P16-1

NEW SHAWMUT MNG. CO.
ST. MARYS, PA.
HORTON TWP. ELK. CO.
SCALE 1" = 100'
DATE 3-29-61
APPROVED BY
SURVEYED BY J.H.D.