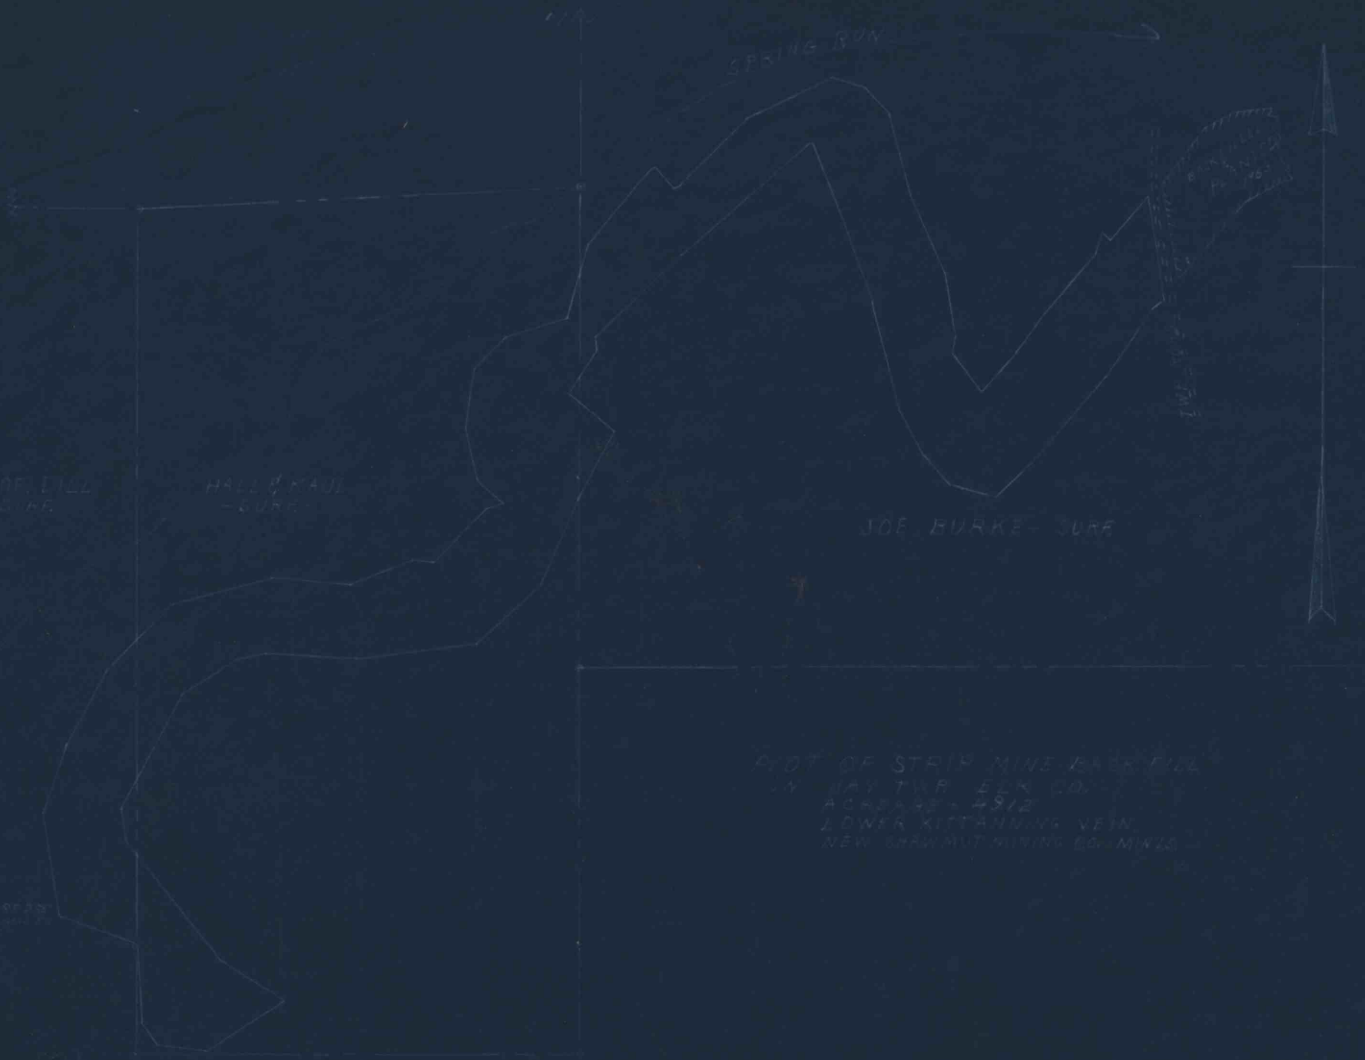
SPRING RUN
JOE BURKE - SURF
PLOT OF STRIP MINE BANK FILL
IN HAY TWP. ELK CO.
ACREAGE - 2.912
LOWER KITTANNING VEIN
NEW SHAWMUT MINING CO. MINES
NEW SHAWMUT MINING CO
ST MARYS, PA.
SCALE - 1 INCH = 400 FT.
DATE - SEPT 29 1965
DRAWN BY L.H. BURKE
APPROVED BY

IMAPS# 16279