


WT. 43 96

N.W.M & EX.CO. - FEE LANDS

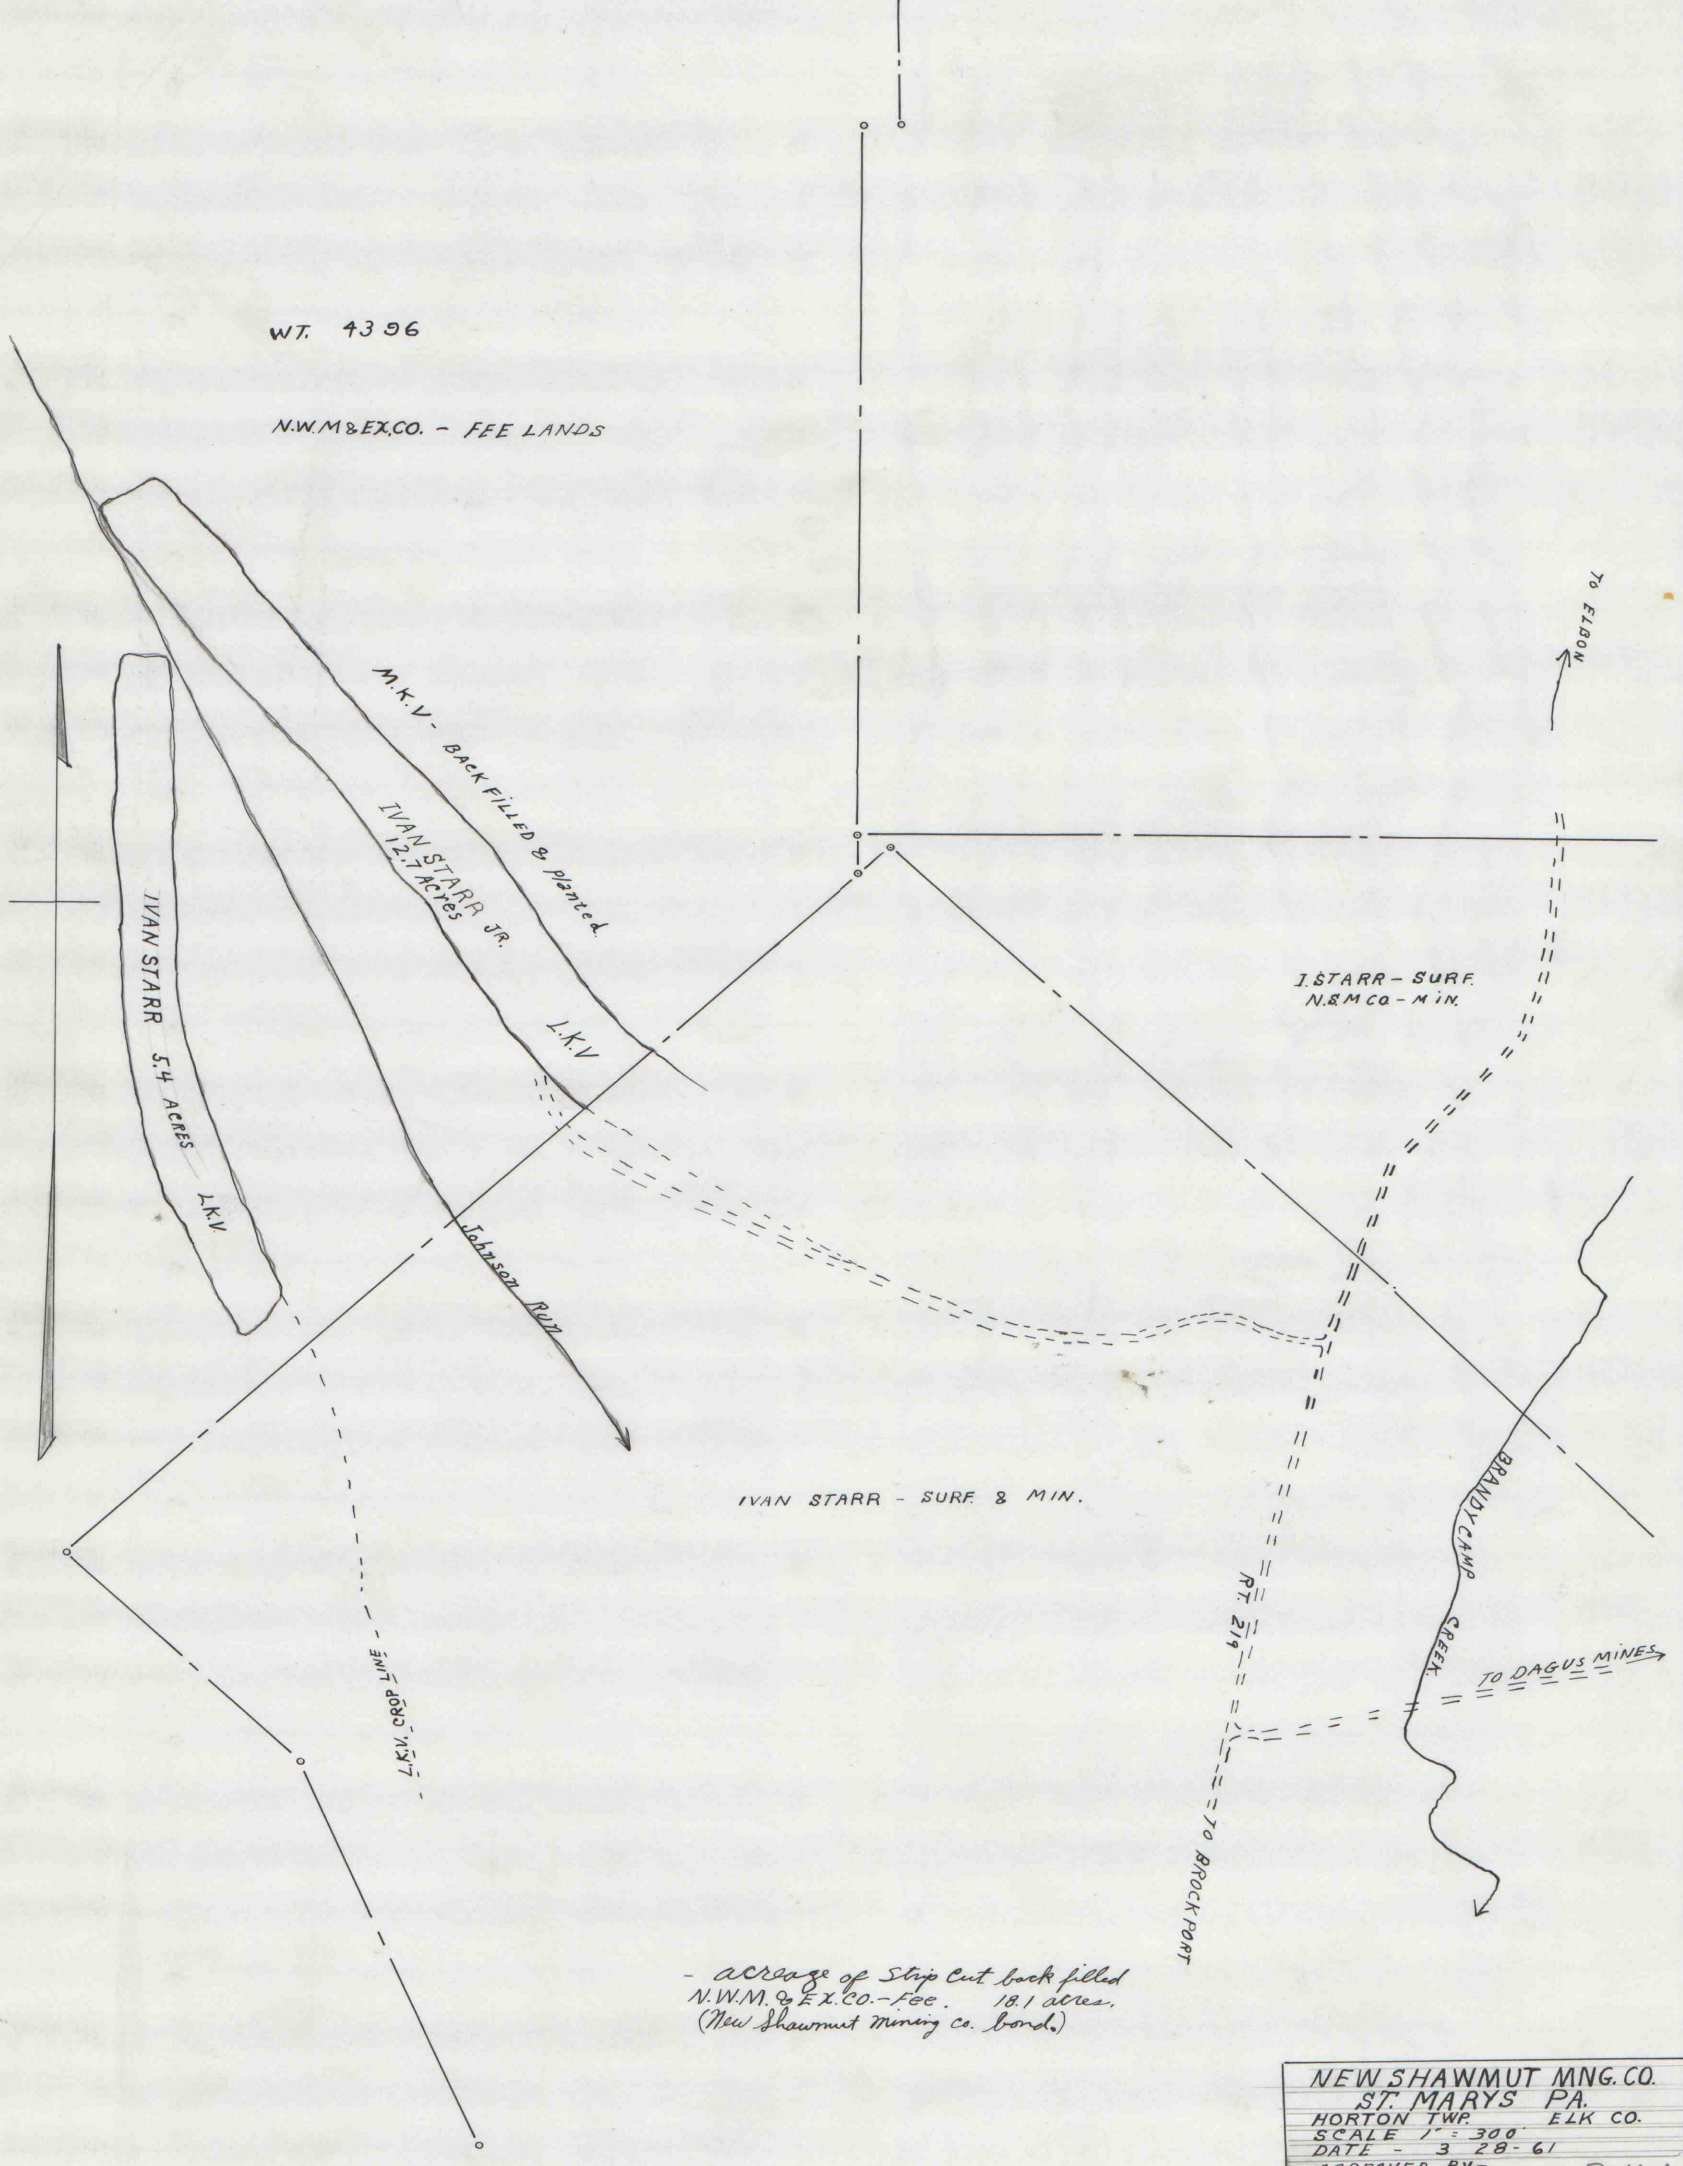

- acreage of Strip Cut back filled
N.W.M. & EX.CO. - Fee. 18.1 acres,
(New Shawmut Mining Co. bonds.)

NEW SHAWMUT MNG. CO.	
ST. MARYS PA.	
HORTON TWP. ELK CO.	
SCALE 1" = 300'	
DATE 3-28-61	
APPROVED BY-	P-16-1