
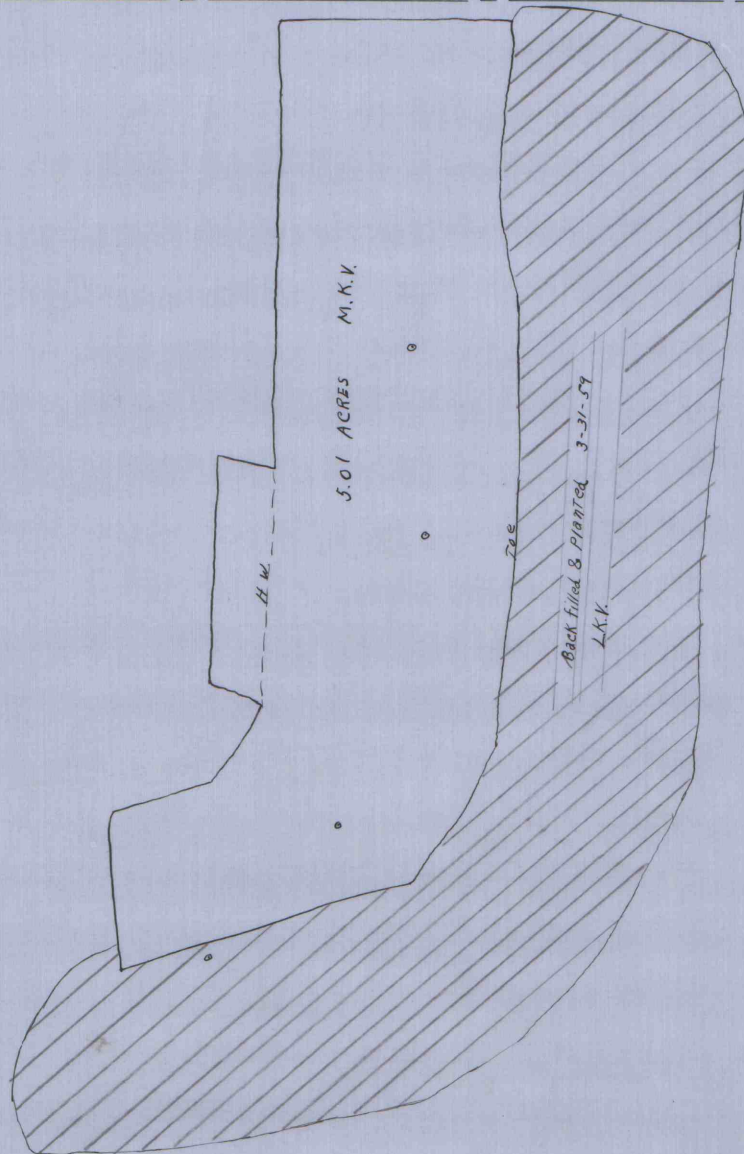


NEW SHAWMUT MNG. CO. - FEE

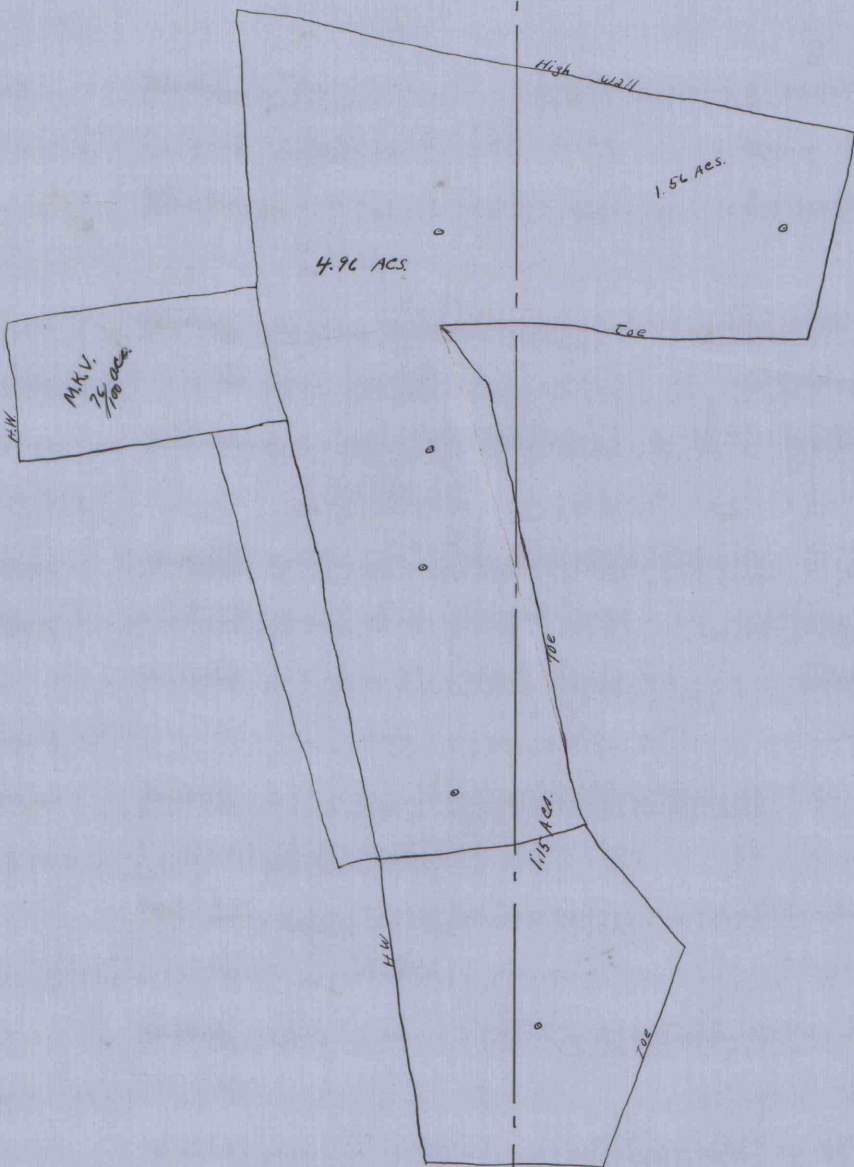

BENTON - Surface
N.S.M.CO. - MIN.

Plot of strip Mine back fill - (surface)

Middle Kittering Ven - New Shawmut Mining Co.	76 acres
" " " - Benton	5.01 "
Lower " " - New Shawmut Mining Co.	4.96 "
" " " - Benton	271 "
Total	13.44 " <i>R.H.B.</i>

NEW SHAWMUT MNG.CO.
ST. MARYS PA
FOX TOWNSHIP - ELK CO.
SCALE 1" = 100'
DATE - 3-28-61
APPROVED BY-