


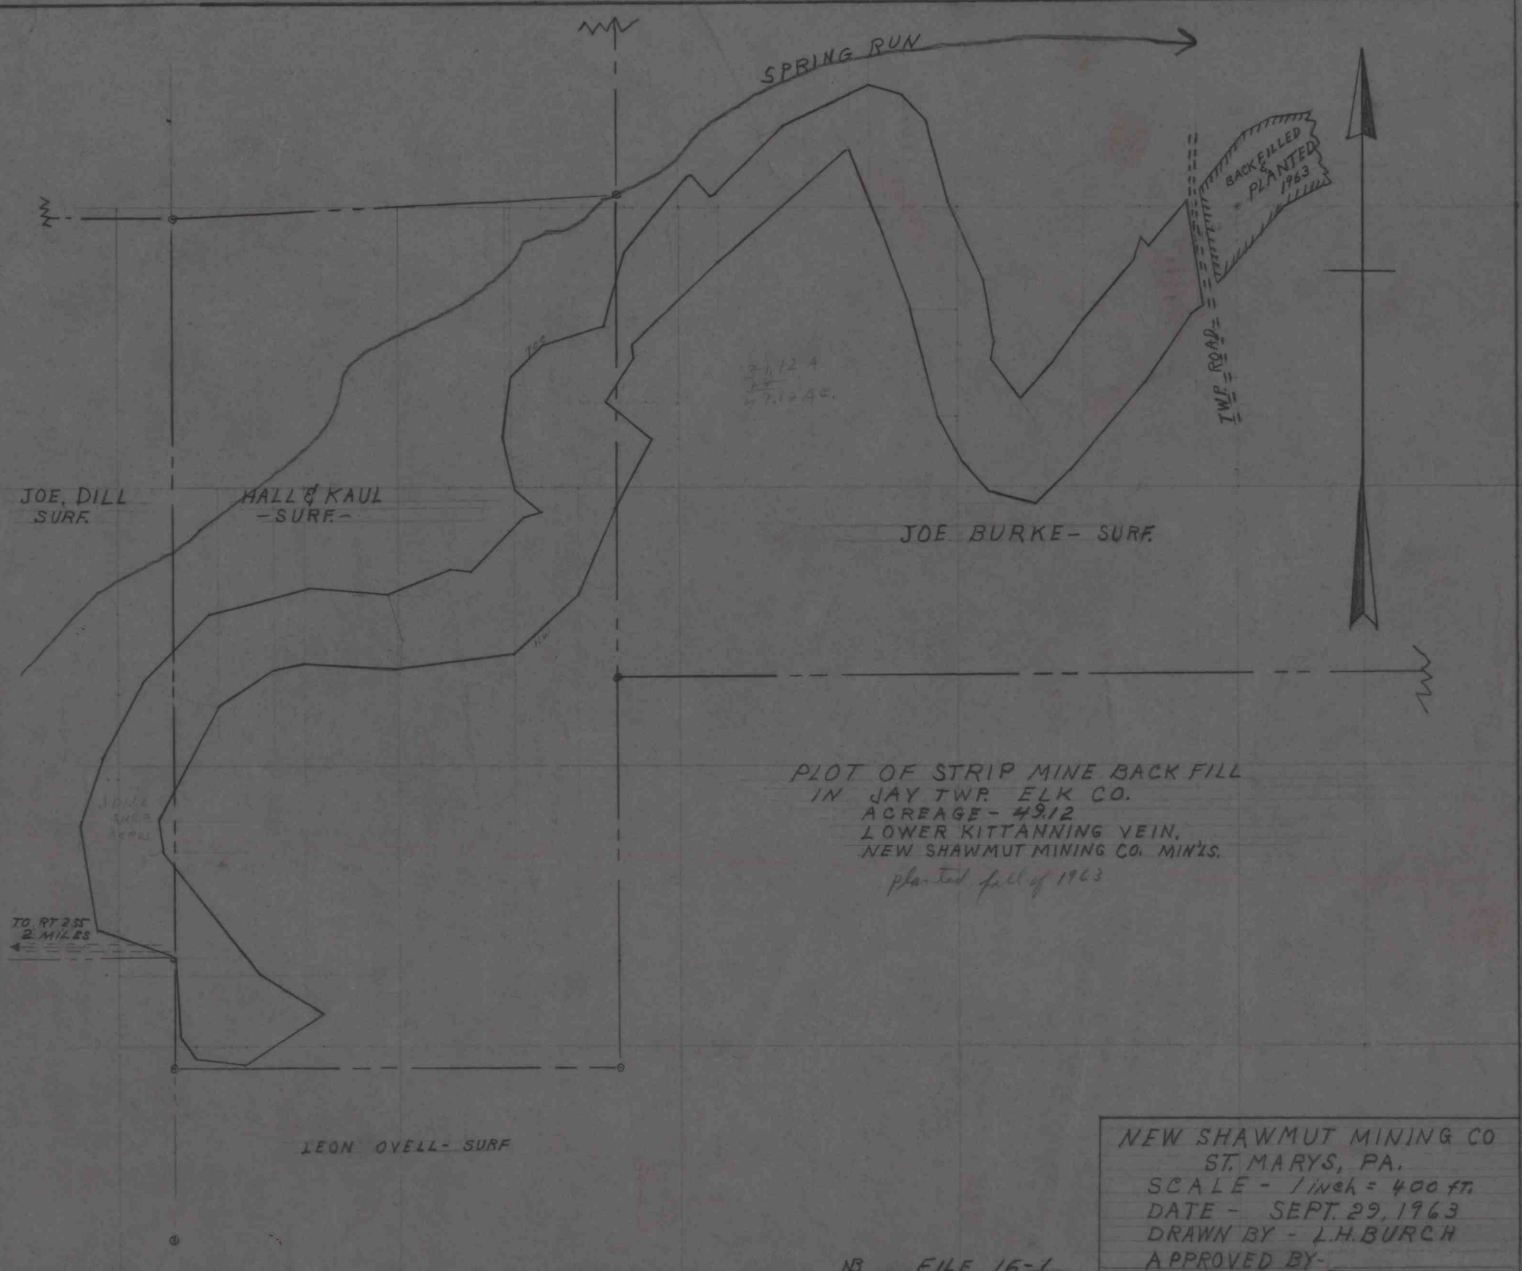

NEW SHAWMUT MINING CO
ST. MARYS, PA.
SCALE - 1 inch = 400 ft.
DATE - SEPT. 29, 1963
DRAWN BY - L.H. BURCH
APPROVED BY -

18 FILE 16-1

IMAPS 16285