


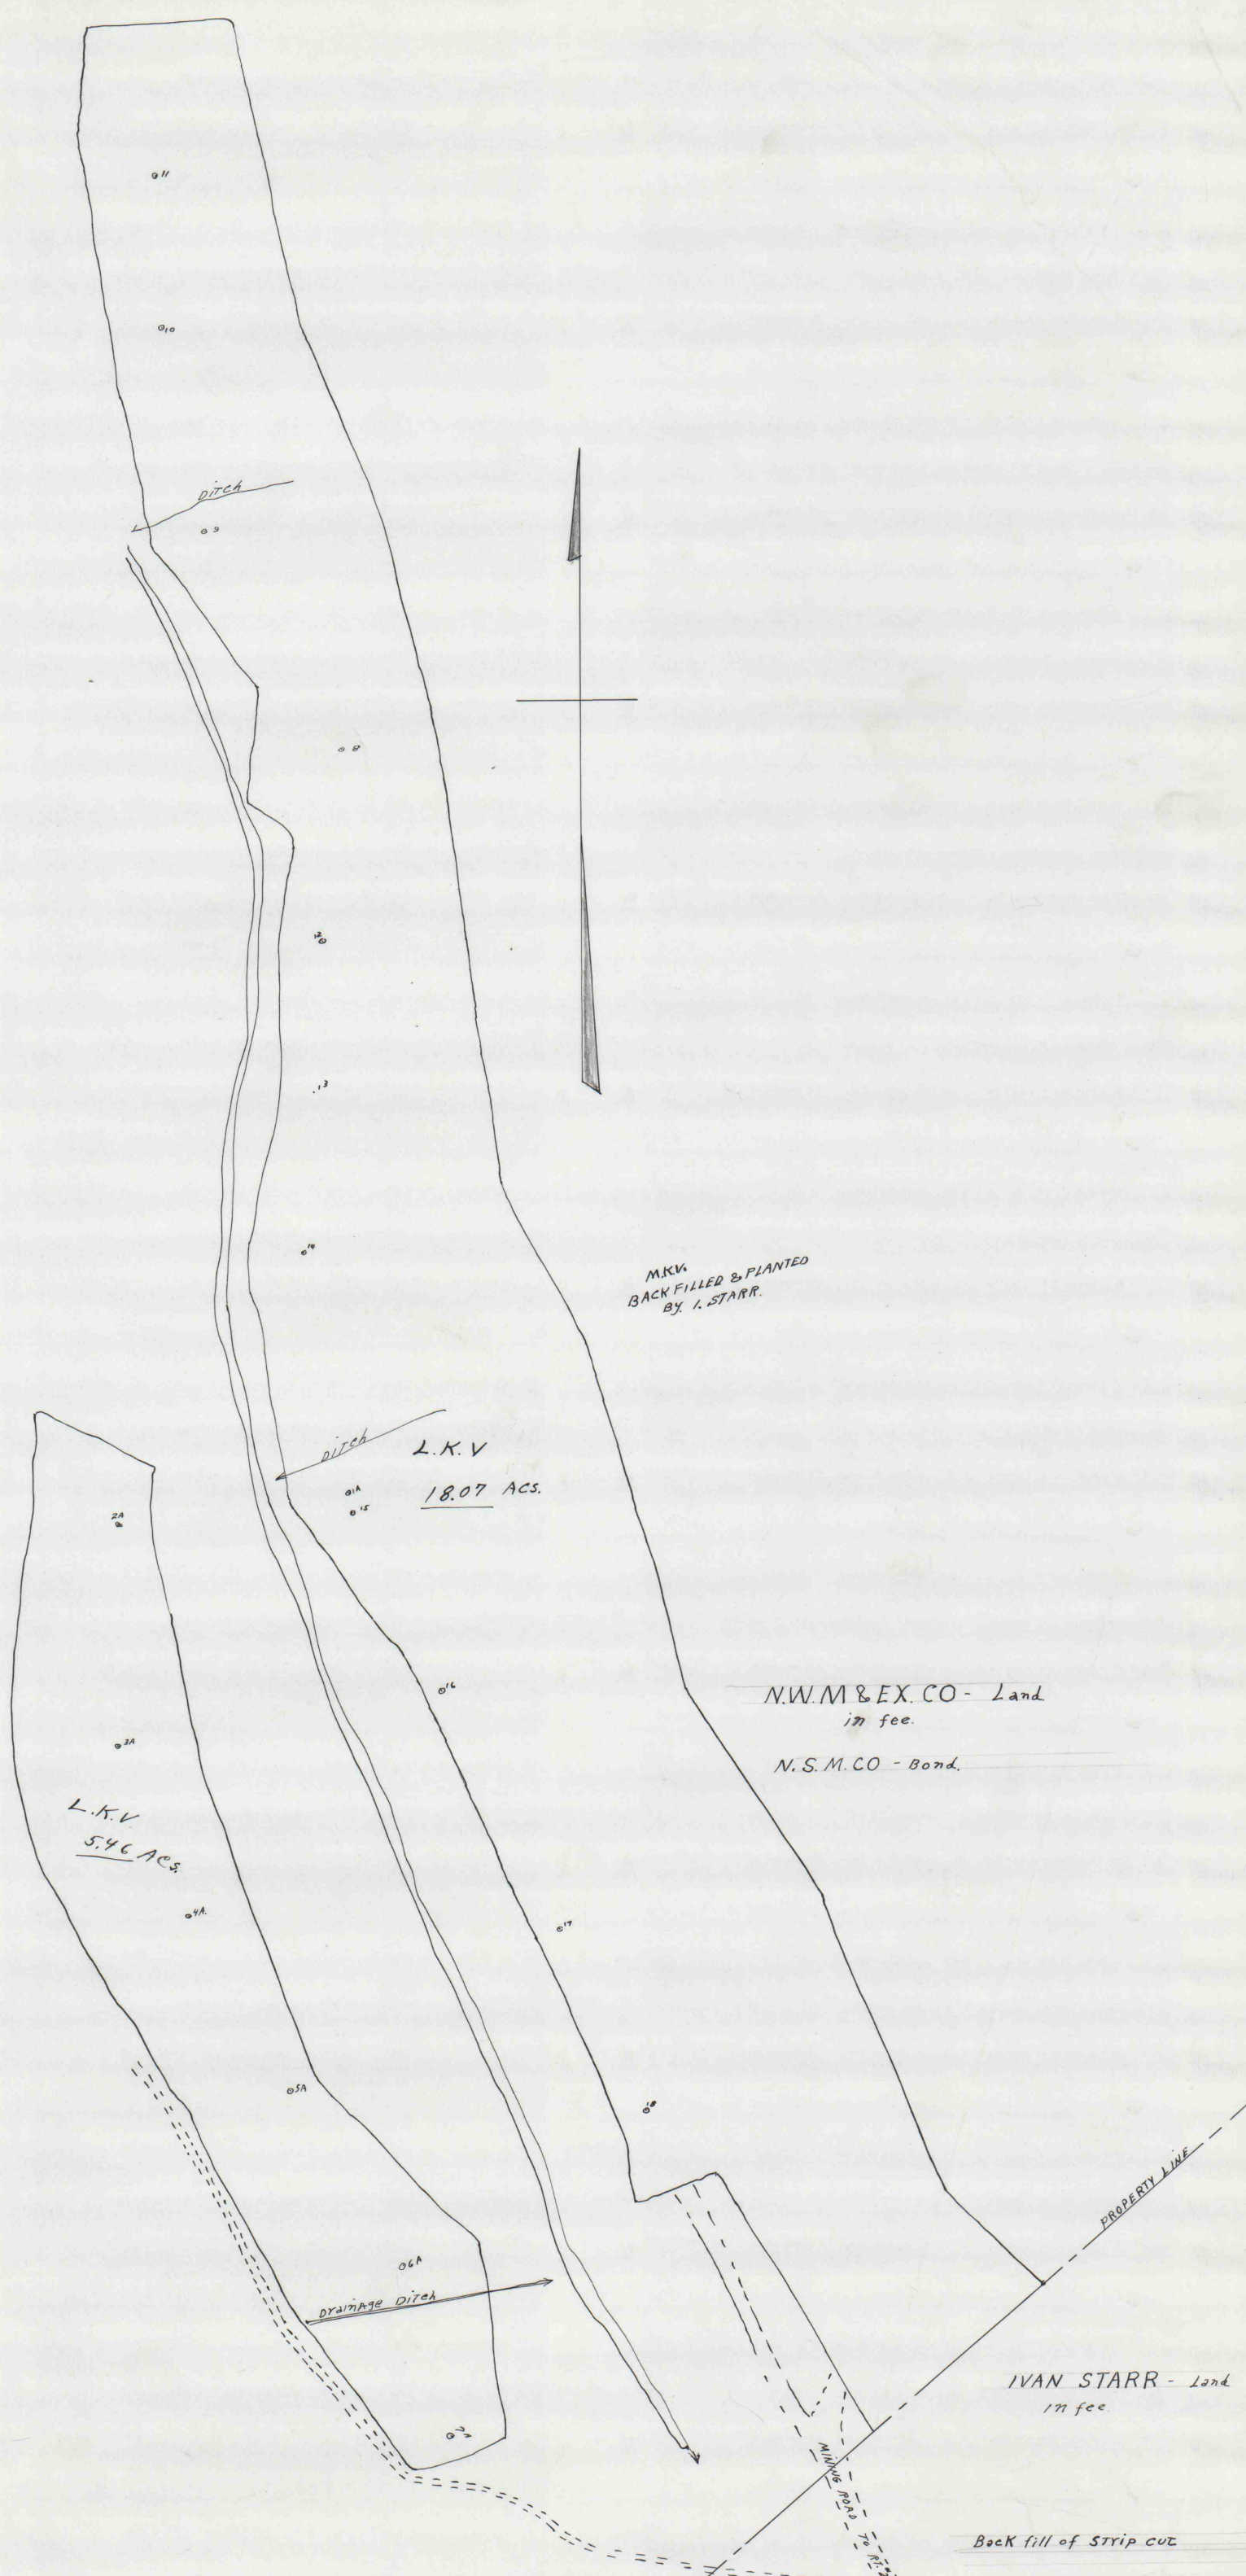

MAK
BACK FILLED & PLANTED
BY I. STARR.

L.K.V

18.07 ACS.

N.W.M & EX. CO - Land
in fee.

N.S.M.CO - Bond.

L.K.V
5.46 ACS.

IVAN STARR - Land
in fee

Back fill of Strip cut

IMAPS # 16286

NEW SHAWMUT MNG. CO.
ST. MARYS PA
SCALE - 1" = 400'
DATE - 4-17-61
HORTON TWP. ELK CO.
SURVEY BY J.H.B.

P16-1