


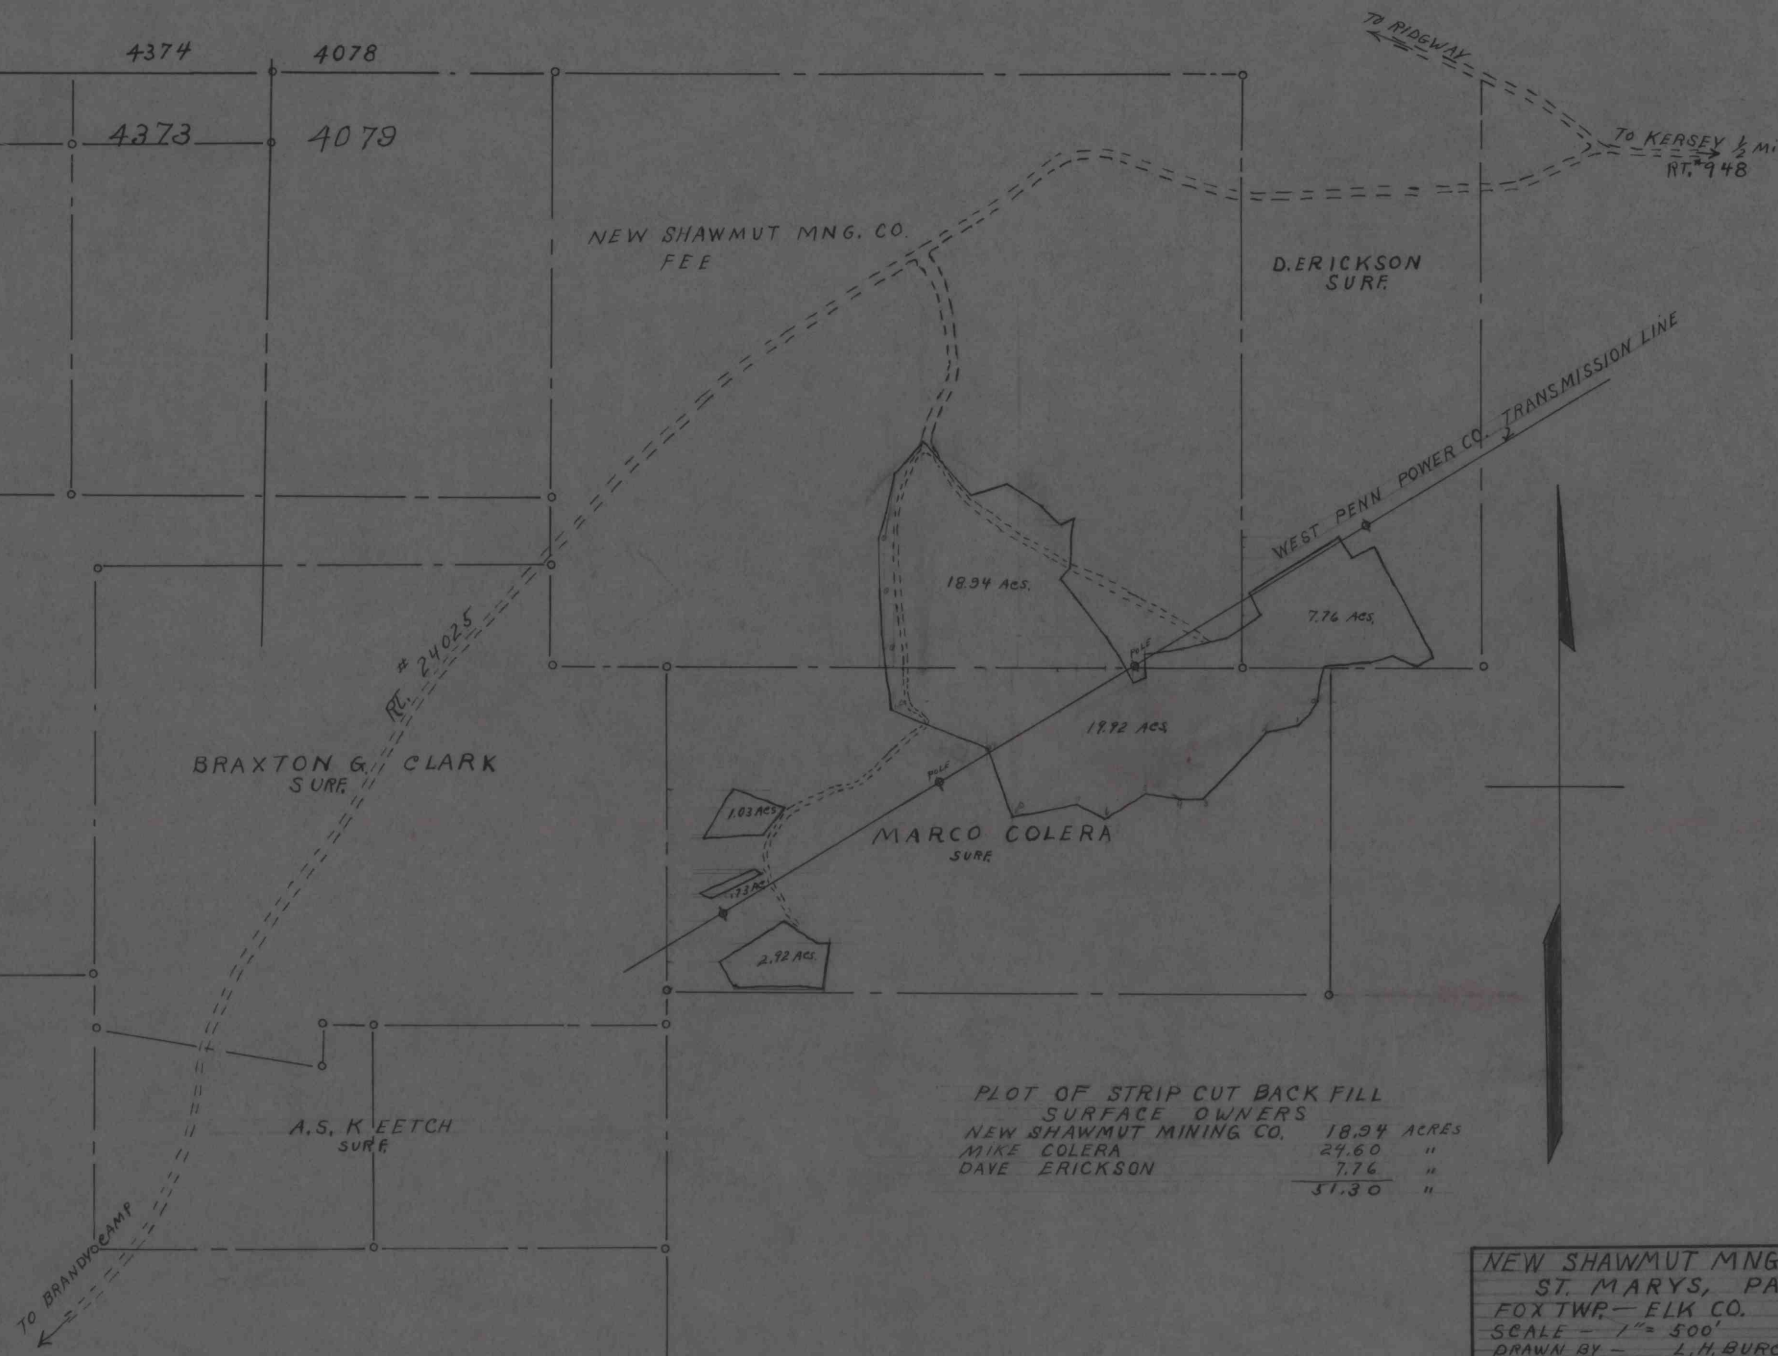

PLOT OF STRIP CUT BACK FILL
 SURFACE OWNERS
 NEW SHAWMUT MINING CO. 18.94 ACRES
 MIKE COLERA 24.60 "
 DAVE ERICKSON 7.76 "
 51.30 "

NEW SHAWMUT MNG. CO.
 ST. MARYS, PA.
 FOX TWP - ELK CO.
 SCALE - 1" = 500'
 DRAWN BY - L.M. BURCH
 APPROVED BY -
 DATE OF BACK FILL - 1962.