


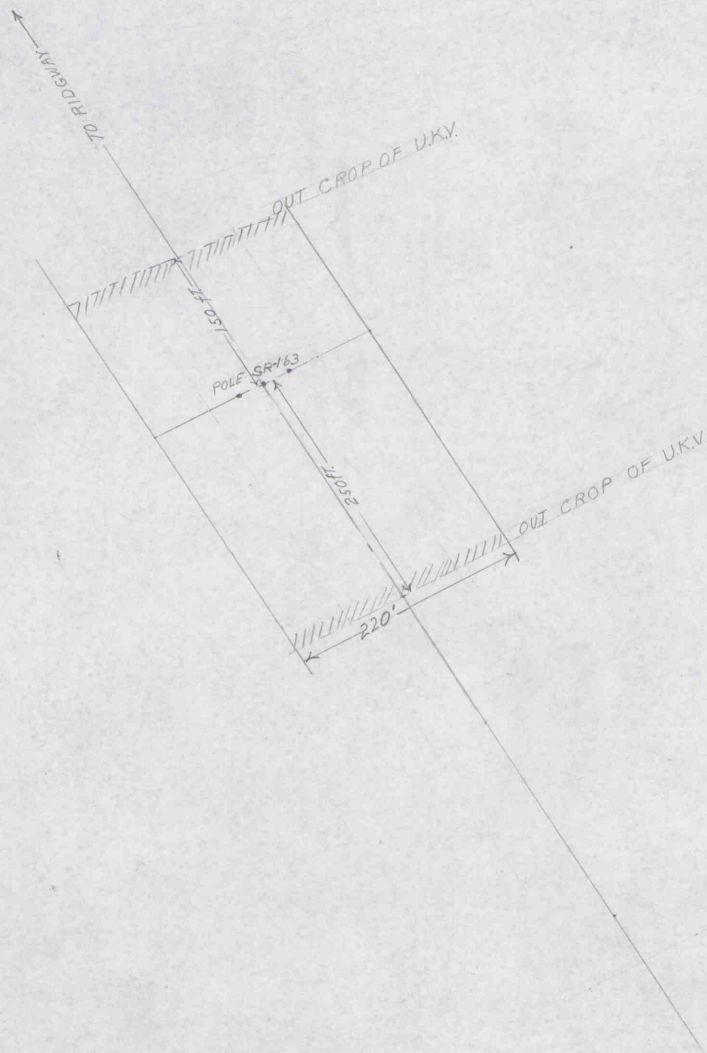

3
10826
4326

10816
4326

165

11095
4326

NEW SHAWMUT MINING CO.
ST. MARYS, PA.
Coal under and adjacent
to PENELEC Trans. line
FOX TWR ELK CO.
SCALE 1" = 100 FT.
DATE 6-25-63. L.H.B.

IMAPS #16288