


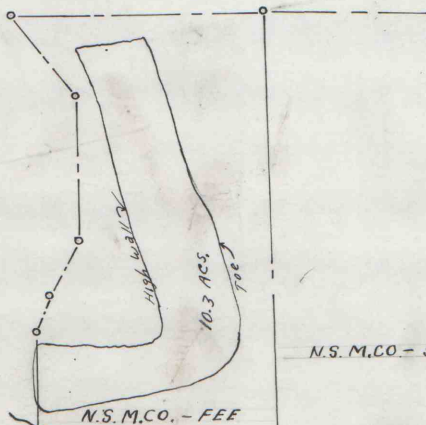

N.S.M.CO. - SURF.

N.S.M.CO. - FEE

SPRING RUN

PLOT OF STRIP CUT BACK FILL

TOTAL SURFACE

New Shawmut Mng. Co. 10.3 ACS.



CHAS. SHUTTERS - SURF.

N.S.M.CO. - FEE

NEW SHAWMUT MNG. CO.
ST. MARYS, PA.
JAY-TWP. ELK CO.
SCALE - 1" = 400'
DATE - 12-1-61
SURVEYED BY L.H.B.

IMAPS #16289