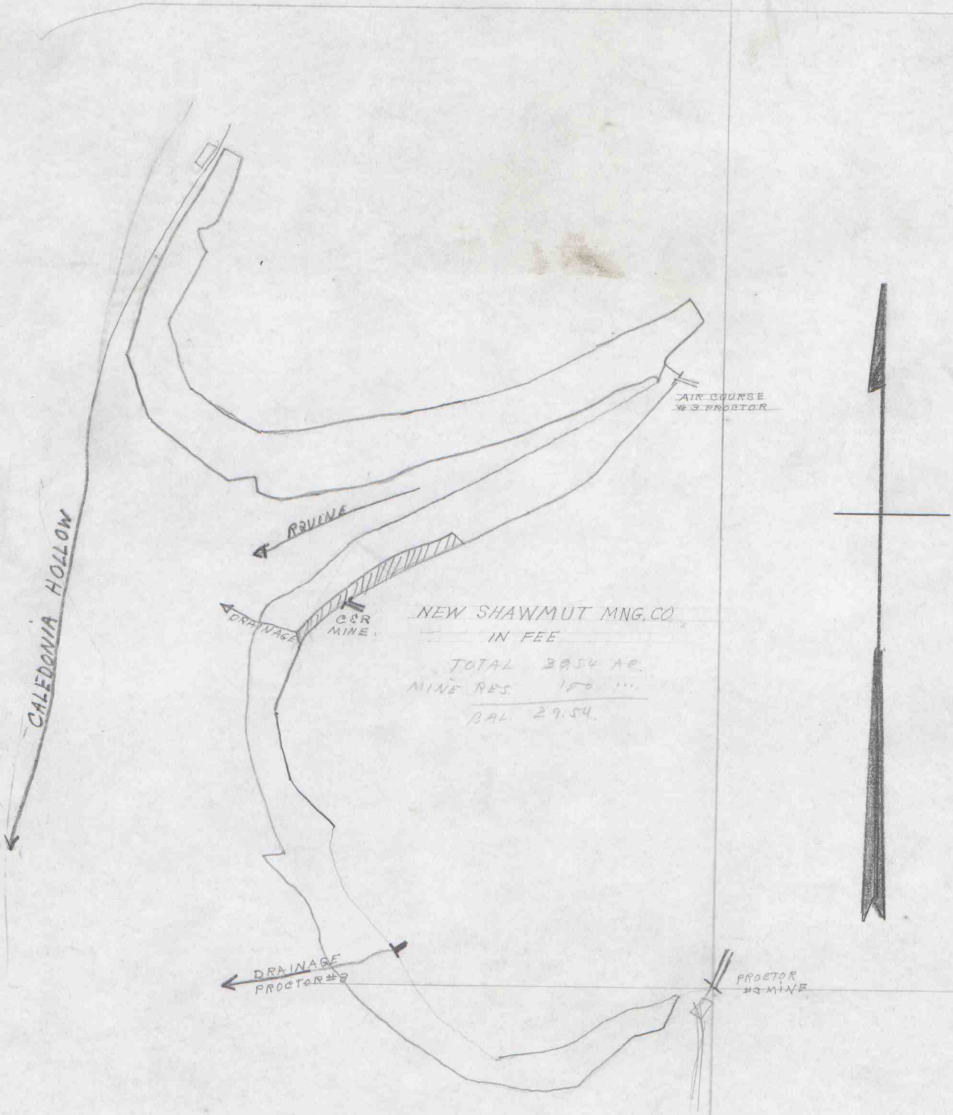
AIR COURSE
#3 PROCTOR
RUINE
CALEDONIA HOLLOW
DRAINAGE
C&R
MINE
NEW SHAWMUT MNG. CO
IN FEE
TOTAL 32.54 AC.
MINE RES. 1.00 ...
BAL. 29.54.
DRAINAGE
PROCTOR #2
PROCTOR
#3 MINE

IMAPS #16291