


CLIFFORD BECK - SURF -

CHARLES SHUTTERS - SURF -

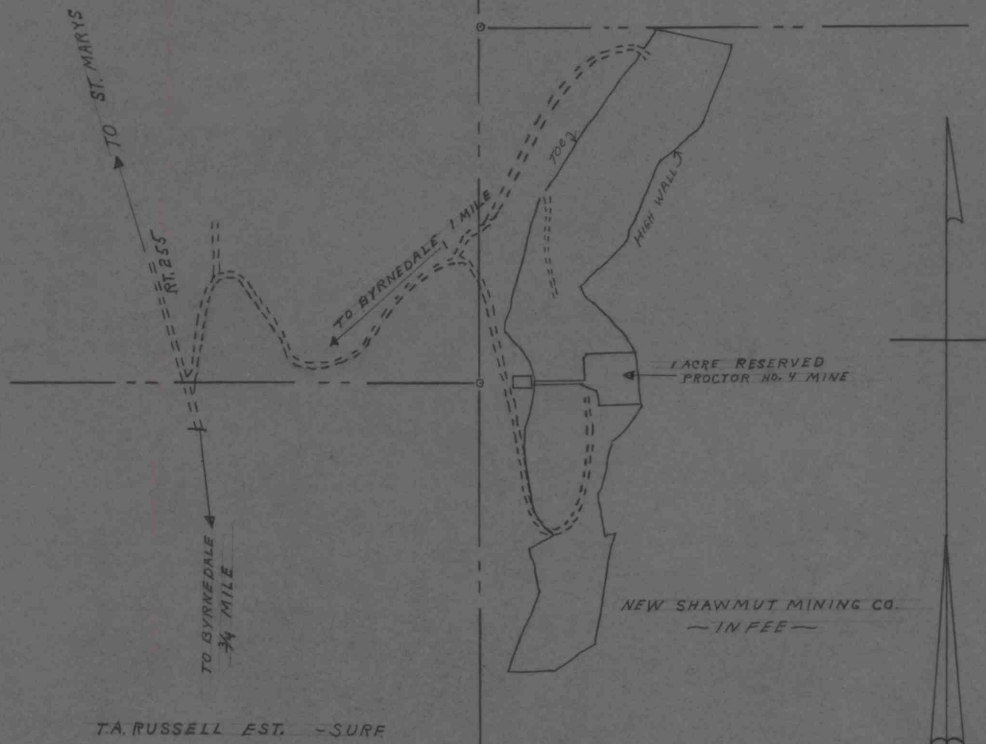

T.A. RUSSELL EST. - SURF -

PLOT OF STRIP MINE BACK FILL
IN JAYTWR. ELK CO.
15.5 ACRES
LOWER KITTANNING VEIN.

VILLAGE OF
BYRNEDALE

NEW SHAWMUT MINING CO
ST. MARYS, PA.
SCALE - 1/4 inch = 400 ft.
DATE - OCT. 15, 1963
DRAWN BY - L.H. BURCH
APPROVED BY - J.D. BROWN

1824 F-16-1

IMAPS 16293