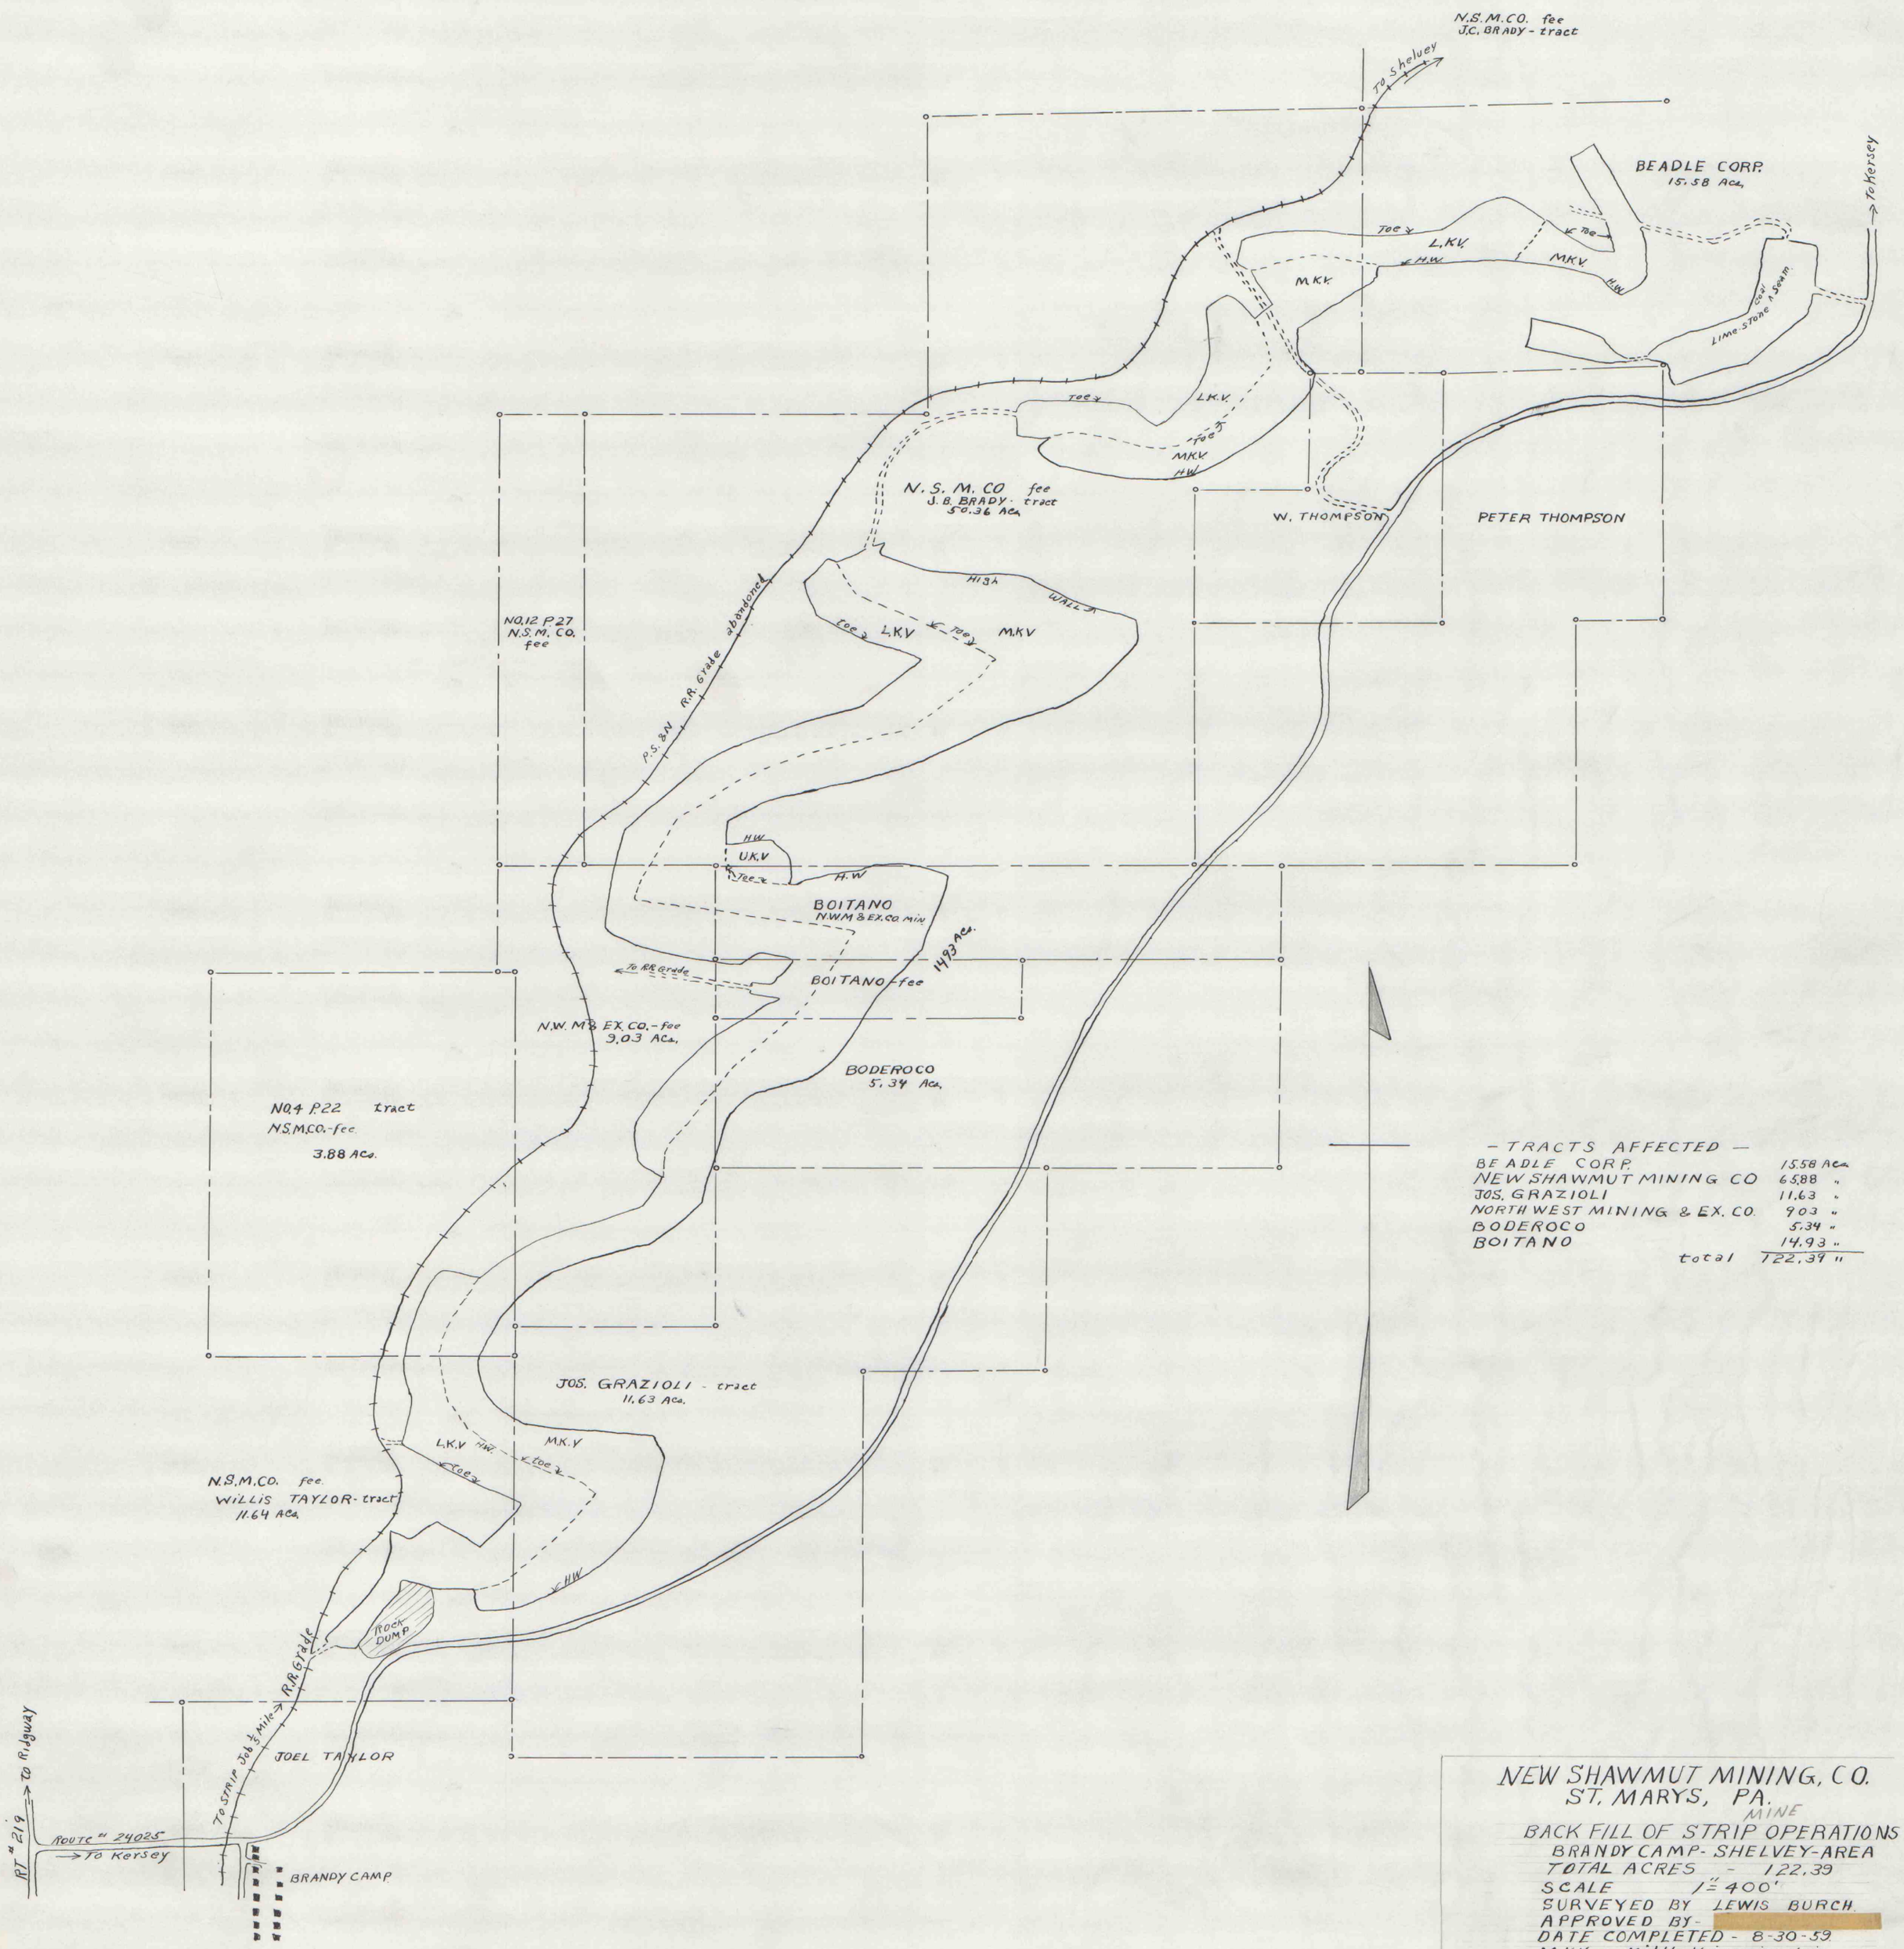

— TRACTS AFFECTED —

BEADLE CORP.	15.58 Acs.
NEW SHAWMUT MINING CO	65.88 "
JOS. GRAZIOLI	11.63 "
NORTH WEST MINING & EX. CO.	9.03 "
BODEROCO	5.34 "
BOITANO	14.93 "
total	122.39 "

NEW SHAWMUT MINING, CO.
ST. MARYS, PA.

BACK FILL OF STRIP OPERATIONS
BRANDY CAMP - SHELVEY - AREA
TOTAL ACRES - 122.39
SCALE 1" = 400'
SURVEYED BY LEWIS BURCH
APPROVED BY -
DATE COMPLETED - 8-30-59
M.K.V. = Middle Kitanning Vein
L.K.V. = Lower " "
U.K.V = Upper " "

IMAPS # 16294