


TWP. Road → TO ROUTE 24025 .6 Mile

Cuneo - tract

M.K.V 5.50 ACs

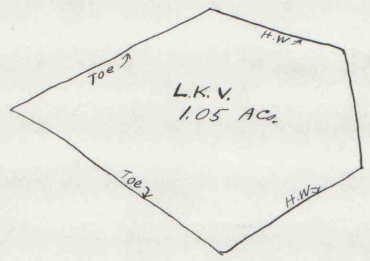

← TO TWP Road 1/5 MILE FROM HERE

F. Coppello - tract

Daumbacher & Cartwright - tract
M.K.V. 11.76

L.K.V 4.02 ACs

M.K.V 3.22

OLD R.R. GRADE

TRACTS AFFECTED & AREA.
CUNEO { L.K.V. 1.05 ACRES
 M.K.V. 5.50 " }

DAUMBACHER & CARTWRIGHT
 L.K.V. 6.46 "
 M.K.V. 11.76 "

FRANCISCO COPPELLO
 L.K.V. 4.02 "
 M.K.V. 3.22 "
TOTAL 32.01

NEW SHAWMUT MINING CO.
ST. MARYS PA.
BACK FILL OF STRIP OPERATIONS IN
BRANDY CAMP SHELVEY AREA
TOTAL ACRES 32.01
SCALE 1" = 100'
SURVEYED BY LEWIS BURCH
APPROVED BY
DATE COMPLETED 8-30-59
M.K.V. = MIDDLE KITTANNING VEIN
L.K.V. = LOWER " "