


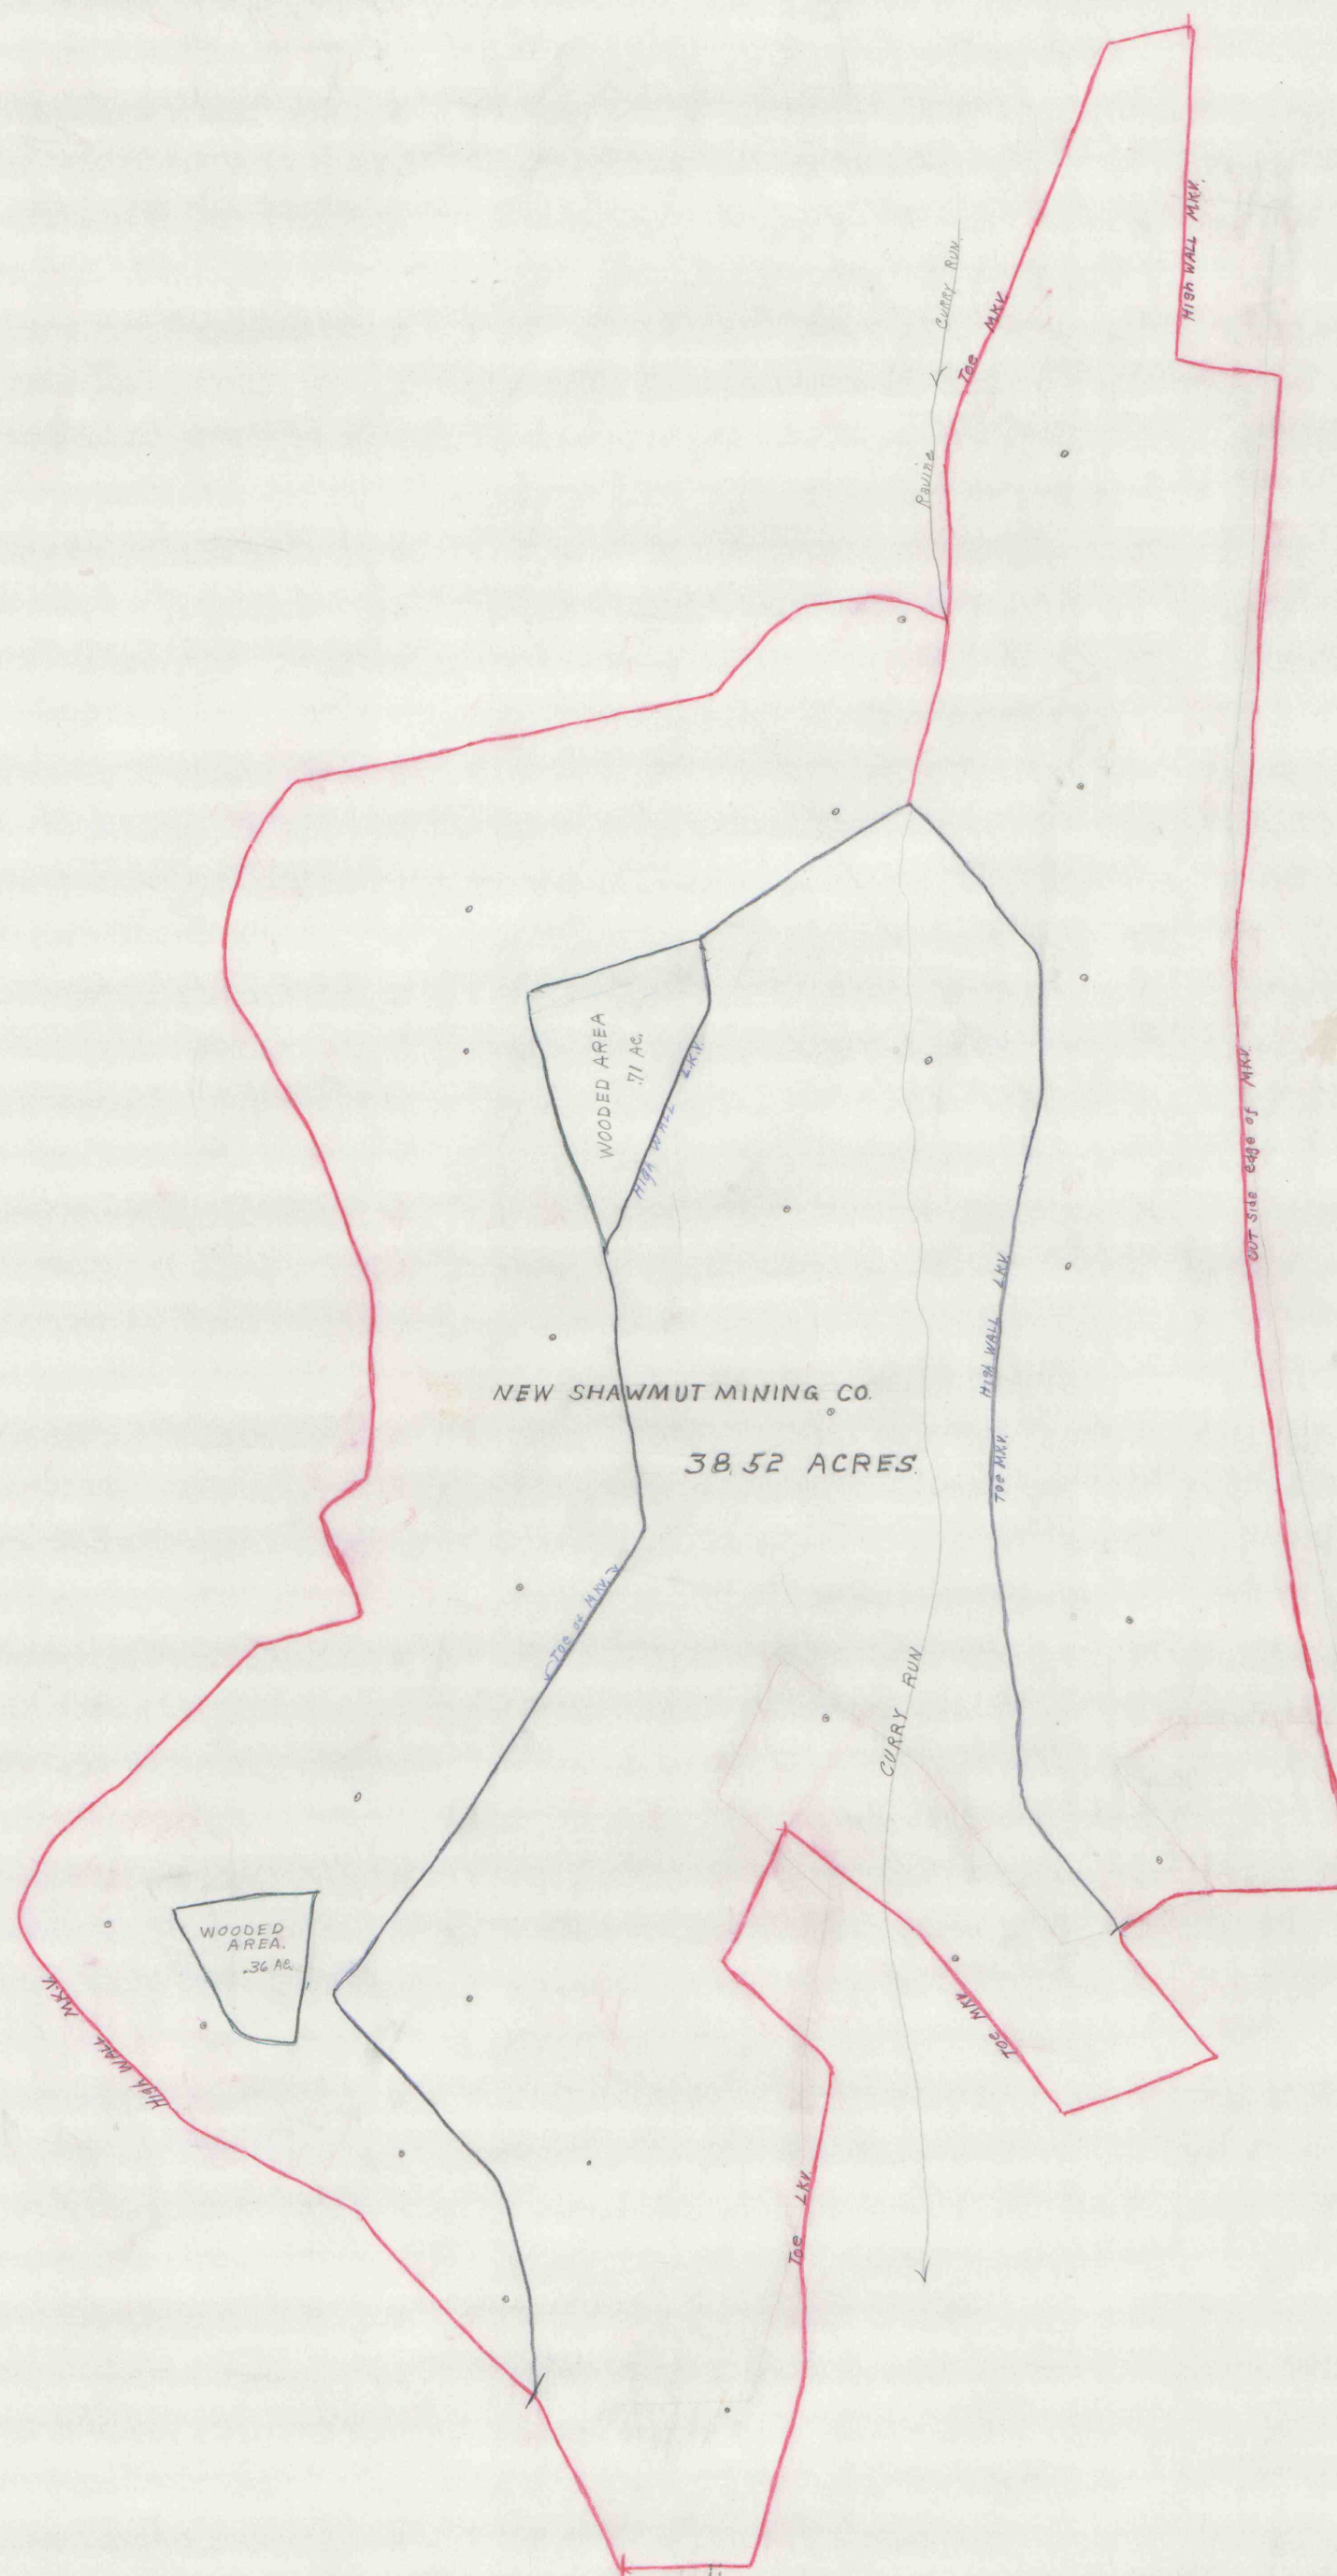

38.52 ACRES.

WOODED AREA
71 AC.

WOODED
AREA.
.36 AC.

EAST	1320.0
------	--------

JAMES BROS. attract in fee

1/2 MILE TO Toby Road

NEW SHAWMUT MINING CO.
ST. MARYS, PA.
PLAN OF STRIP CUT-BACK FILL
FOX TOWNSHIP, ELK CO.
SCALE - 1" = 100'
DATE - SEPT. 25, 1958
APPROVED BY- [REDACTED]