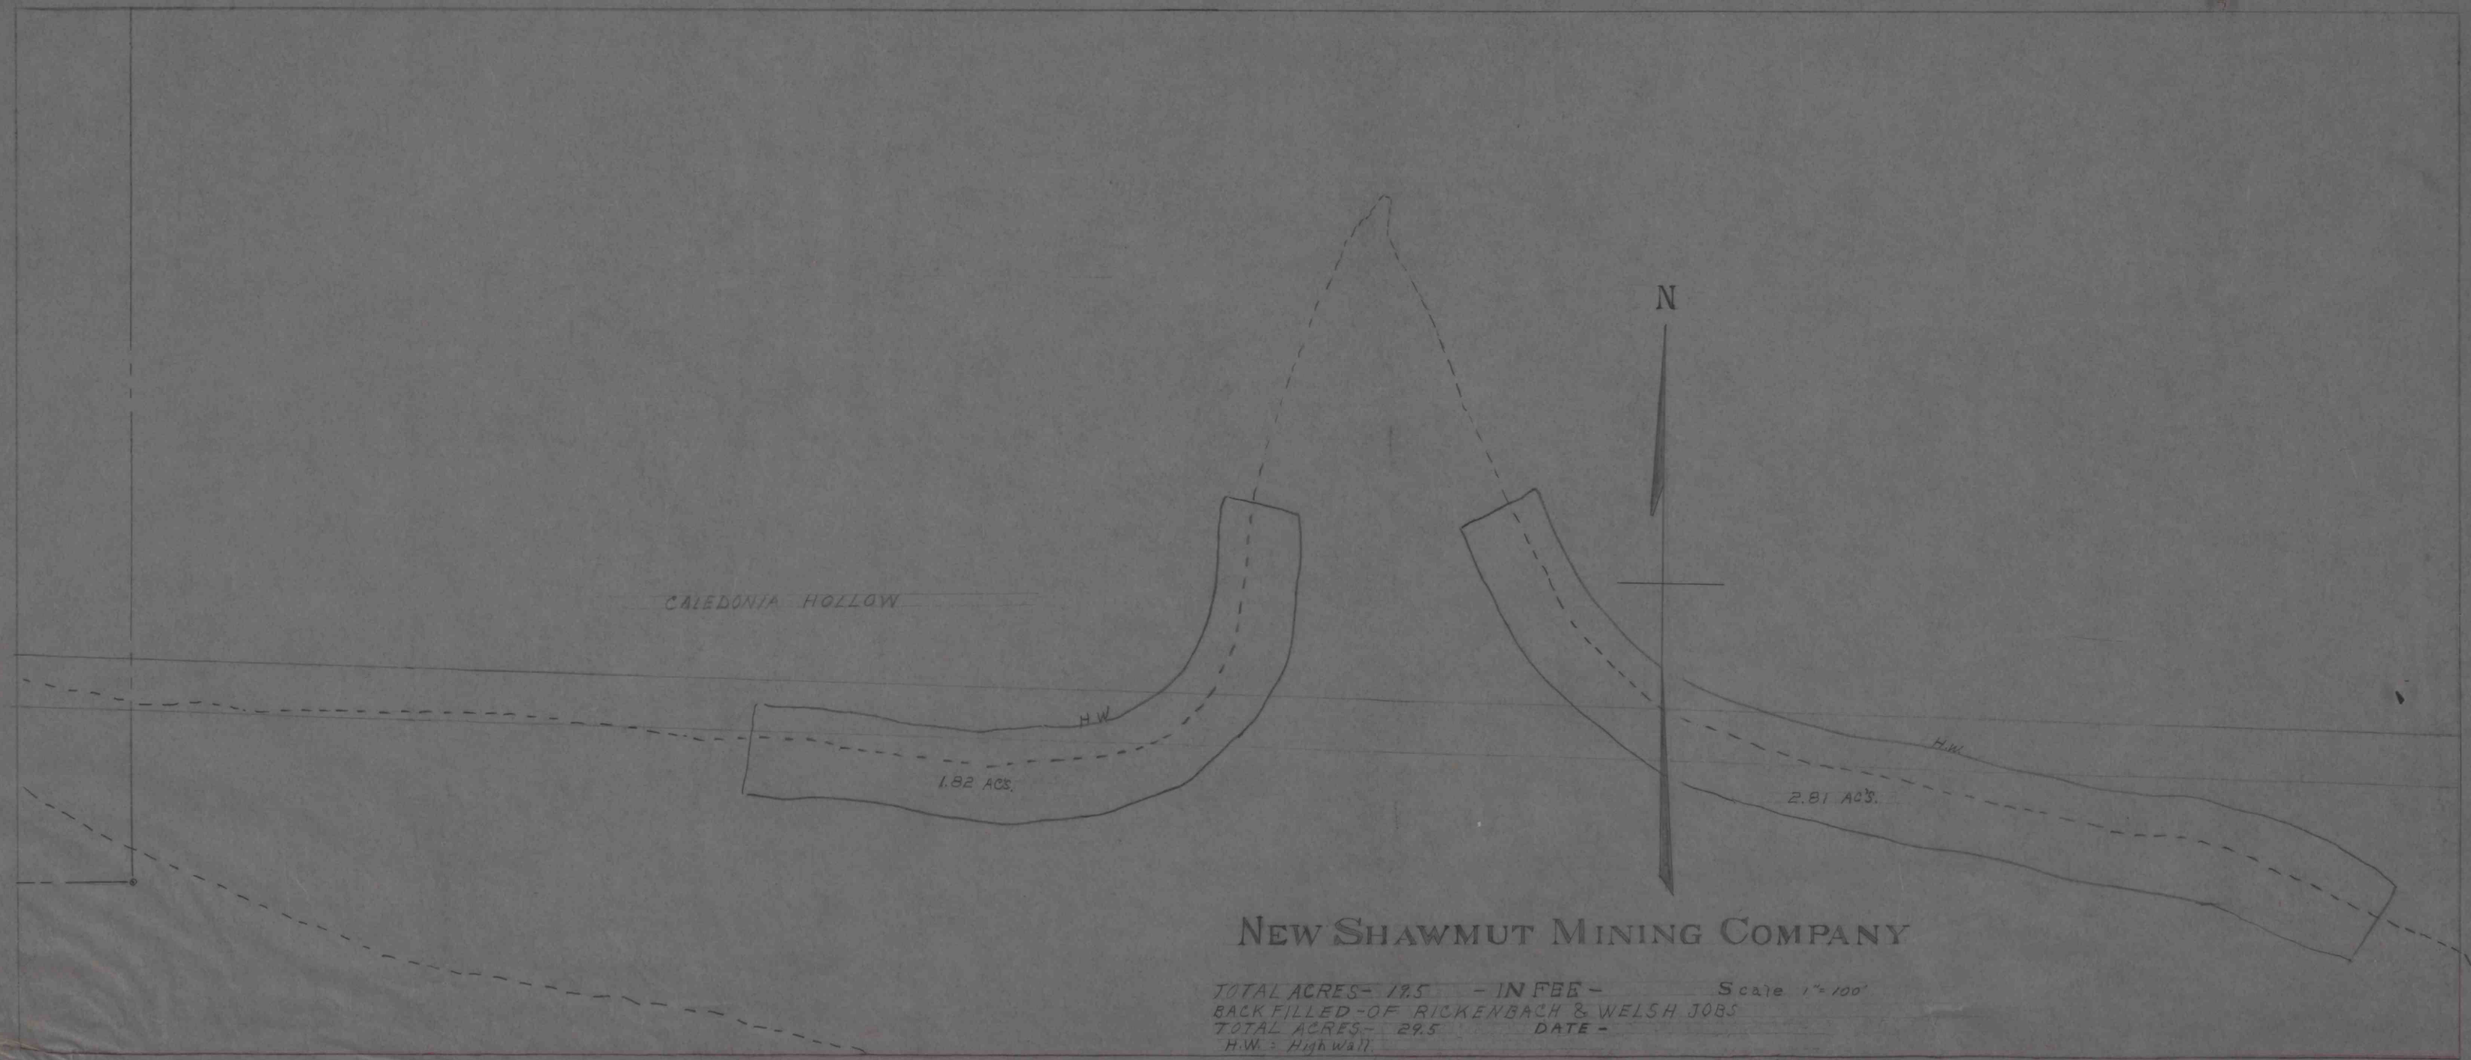
N
CALEDONIA HOLLOW
H.W.
1.82 ACS.
H.W.
2.81 ACS.
NEW SHAWMUT MINING COMPANY
TOTAL ACRES- 17.5 - IN FEE -
Scale 1" = 100'
BACK FILLED - OF RICKENBACH & WELSH JOBS
TOTAL ACRES- 29.5
DATE -
H.W. = High Wall

IMAPS# 16305