


AREA NO. 3
2.5 AC.

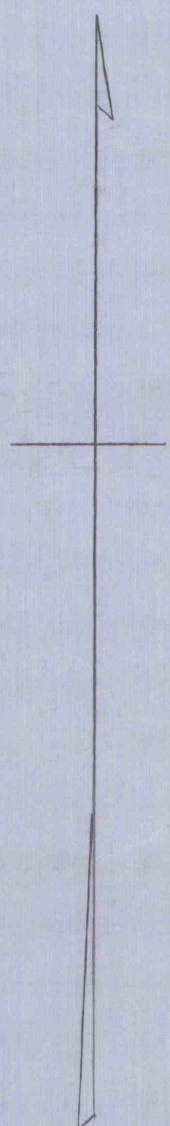

JOS. J. GRAZIOLA.
SURFACE

AREA NO. 4
8.14 ACRES

PROPERTY LINE

PROPERTY LINE

AREA NO. 1 36.34 ACRES

NEW SHAWMUT MINING CO.

WOODED AREA

NOT STRIPPED
WOODED AREA

Area No 1 - 36.34 acres
" " 2 - 6.50 "
" " 3 - .25 "
" " 4 - 8.14 "
Total - 51.23 "

Area No. 1 New Shawmut Mining Co. 35.08
" " Jos. J. Graziola 1.26
Total acres - 36.34

Area No. 4 New Shawmut Mining Co. 3.62
" " Jos. J. Graziola 4.52
Total acres 8.14

Area No. 2 New Shawmut Mining Co. 6.50
Area No. 3 New Shawmut Mining Co. .25

NEW SHAWMUT MINING CO.
ST. MARYS, PA.
BACKFILL STRIP: NOT COMPLETED
BRANDY CAMP - AREA A
SCALE - 1" = 100'
DATE COMPLETED - 7-20-58
SURVEYED by J. Bunch
APPROVED by