


VEIN

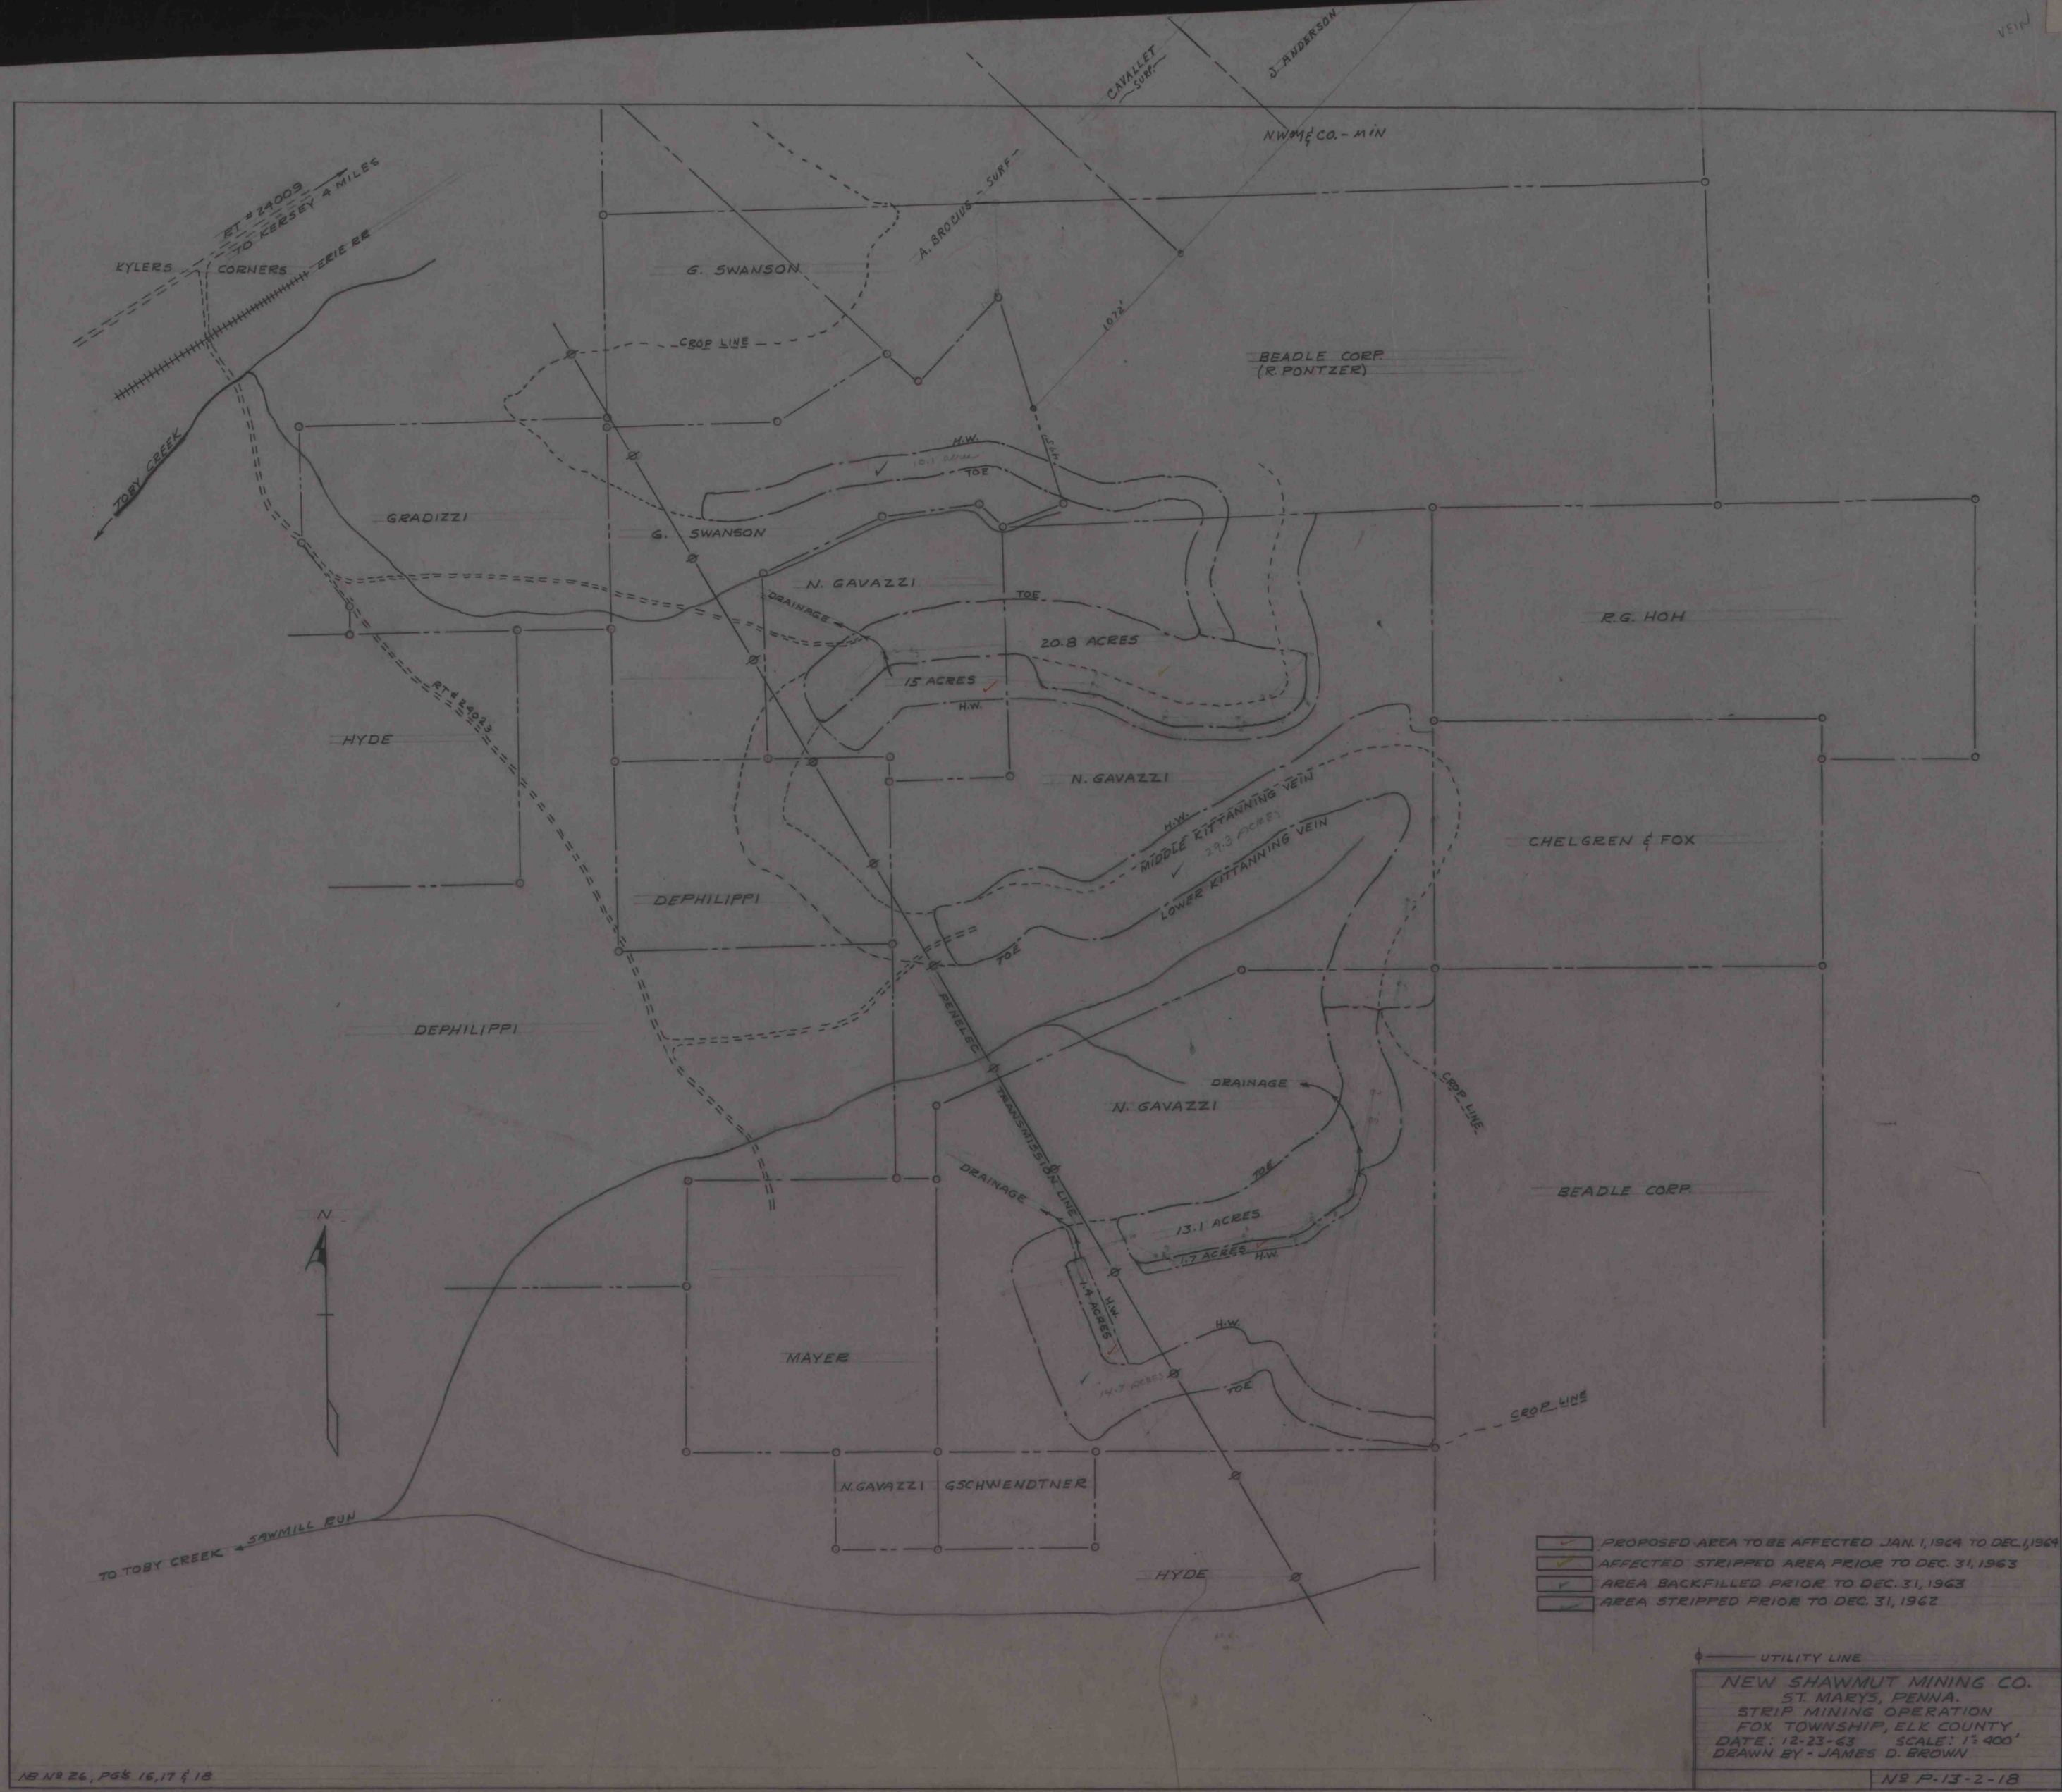

- PROPOSED AREA TO BE AFFECTED JAN. 1, 1964 TO DEC. 1, 1964
- AFFECTED STRIPPED AREA PRIOR TO DEC. 31, 1963
- AREA BACKFILLED PRIOR TO DEC. 31, 1963
- AREA STRIPPED PRIOR TO DEC. 31, 1962

UTILITY LINE
NEW SHAWMUT MINING CO.
ST. MARYS, PENNA.
STRIP MINING OPERATION
FOX TOWNSHIP, ELK COUNTY
DATE: 12-23-63 SCALE: 1" = 400'
DRAWN BY - JAMES D. BROWN
NS P-13-2-18