


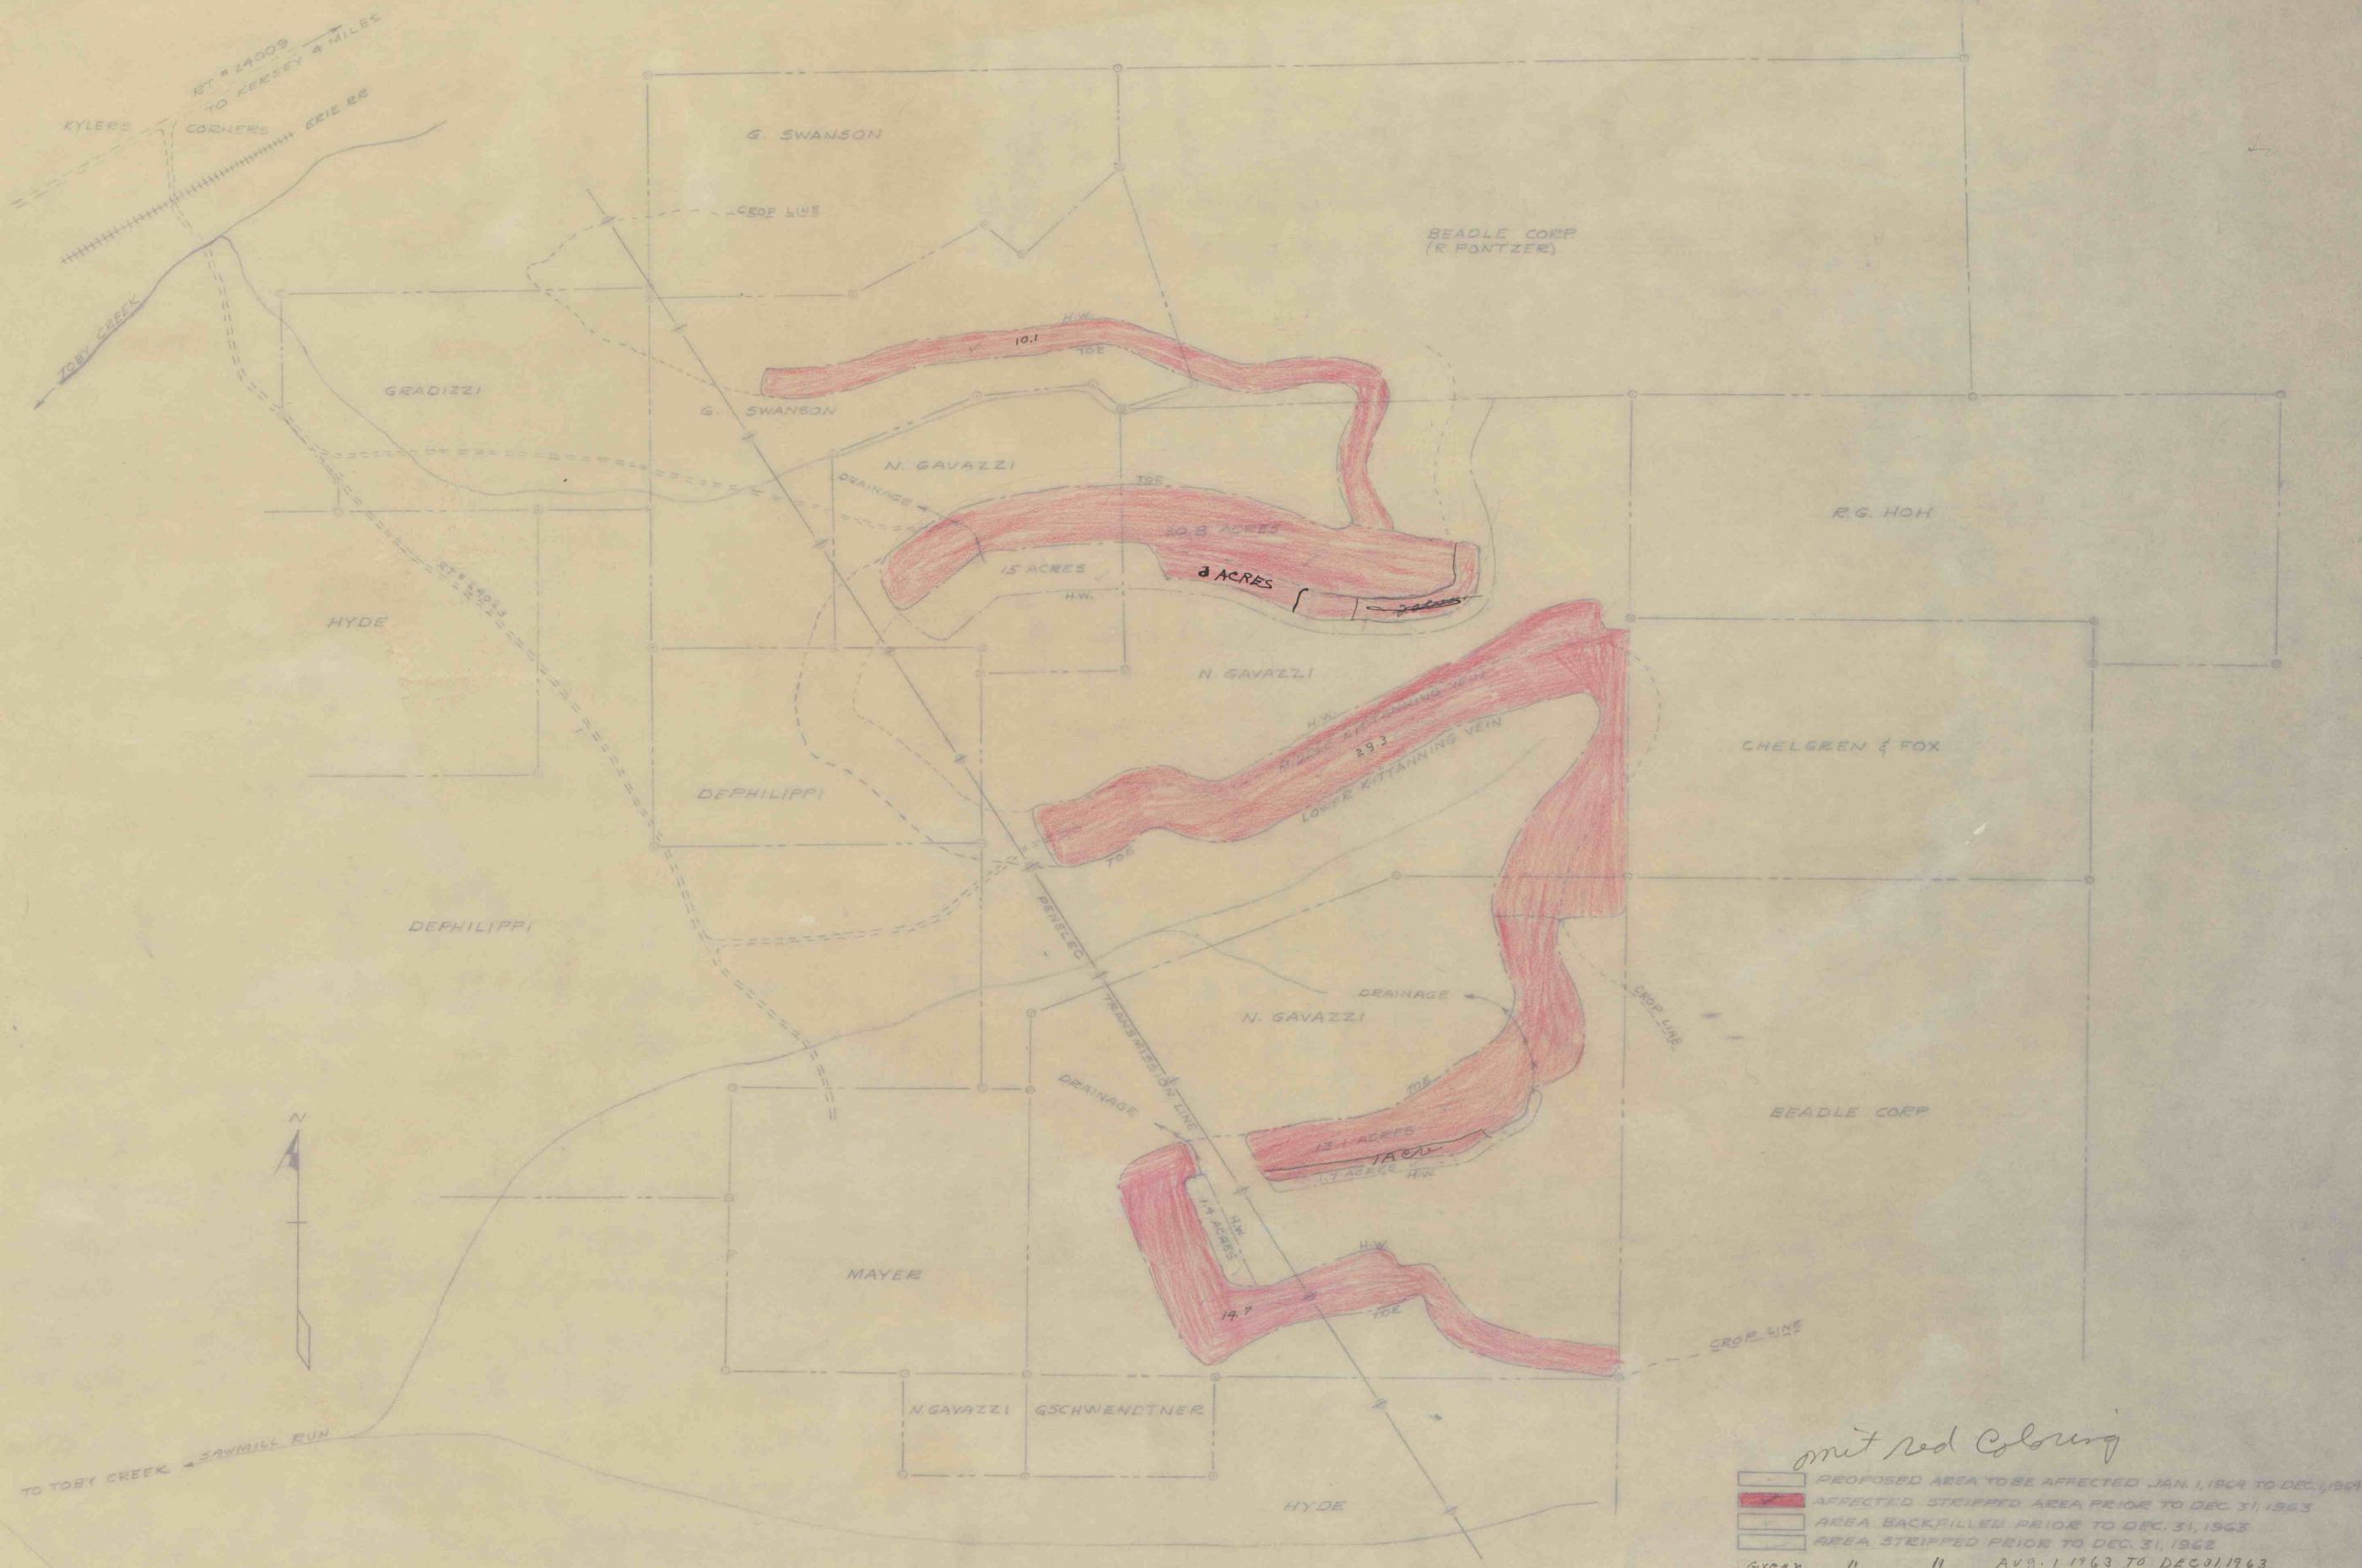

mit Red Colouring

Green	PROPOSED AREA TO BE AFFECTED JAN. 1, 1964 TO DEC. 31, 1964
Red	AFFECTED STRIPPED AREA PRIOR TO DEC. 31, 1963
Yellow	AREA BACKFILLED PRIOR TO DEC. 31, 1963
Yellow	AREA STRIPPED PRIOR TO DEC. 31, 1962
Green	AUG. 1, 1963 TO DEC. 31, 1963

UTILITY LINE

NEW SHAWMUT MINING CO.
ST. MARYS, PENNA.
STRIP MINING OPERATION
FOX TOWNSHIP, ELK COUNTY
DATE: 12-23-63 SCALE: 1" = 400'
DRAWN BY: JAMES D. BROWN

N2 P-13-2-18