


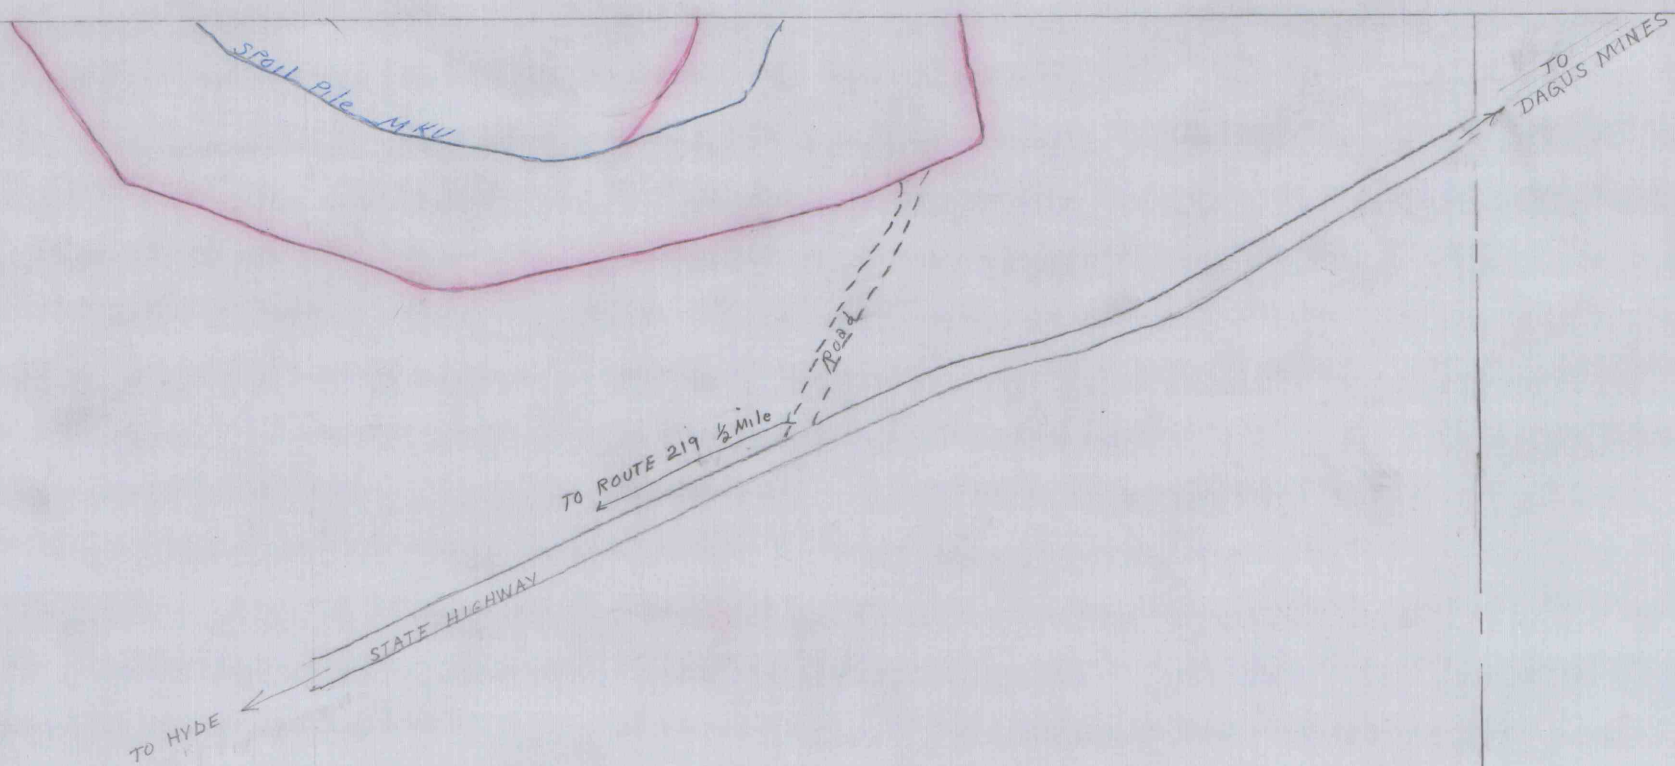

NEW SHAWMUT MINING CO  
STRIP MINING BACK-FILL  
SCALE - 1 INCH = 100 FEET  
HORTON & FOX TOWNSHIPS  
DATE - MAR. 26 1958  
DRAWN BY - J.S.  
APPROVED BY - [REDACTED]  
TOTAL ACRES - 74.88