


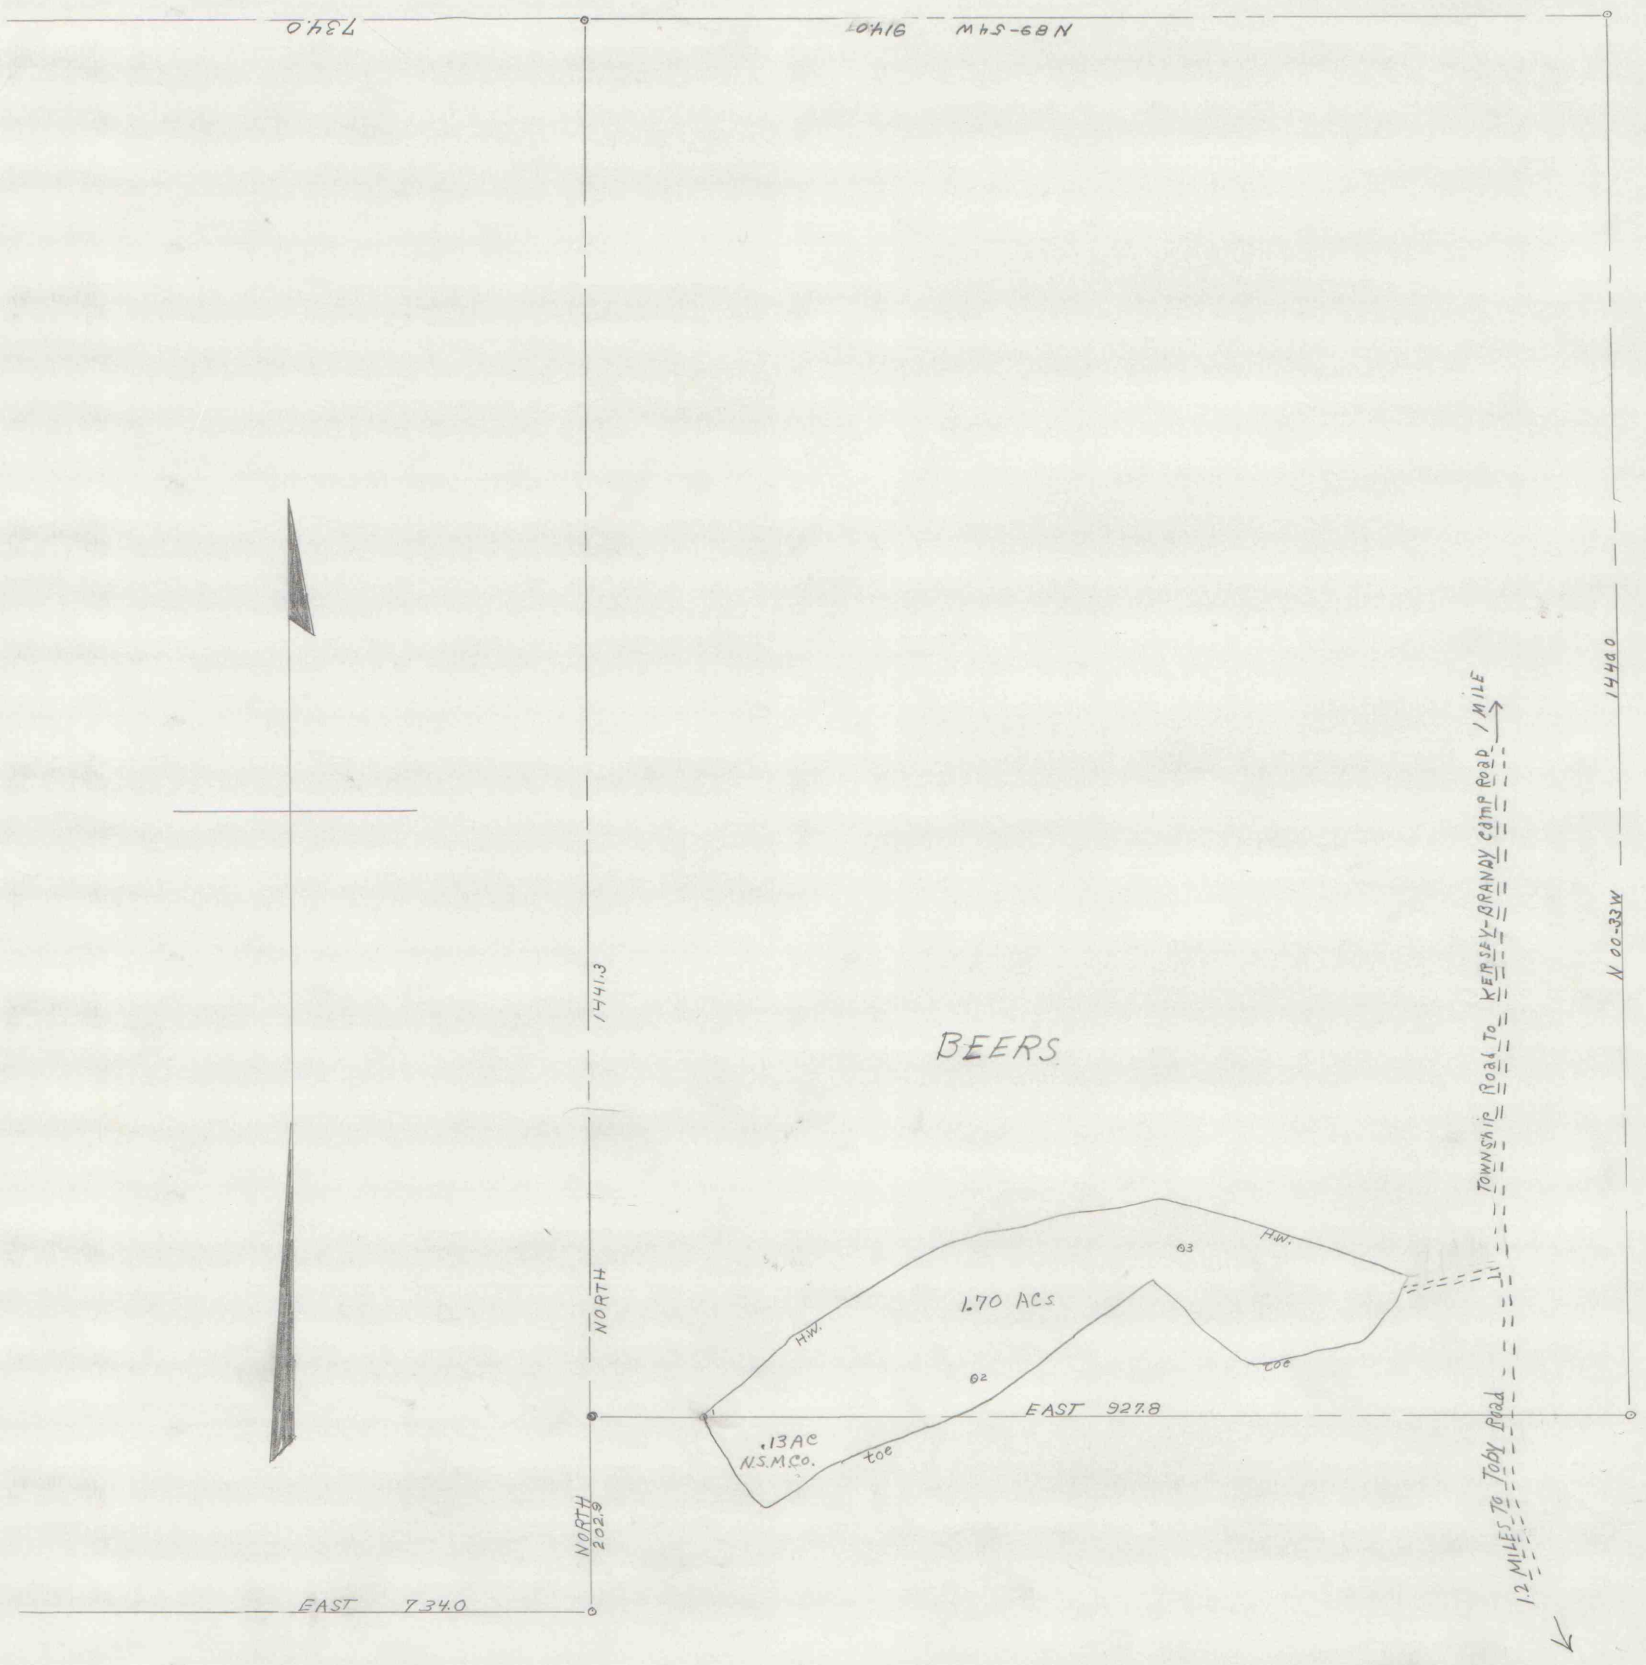

NEW SHAWMUT MINING CO
ST. MARYS, PA.
PLAN OF STRIP CUT-BACK FILL
FOX TOWNSHIP ELK, CO.
SCALE- 1" = 100'
DATE- 9-25-1958
APPROVED BY _____

DRAWN BY *LB*