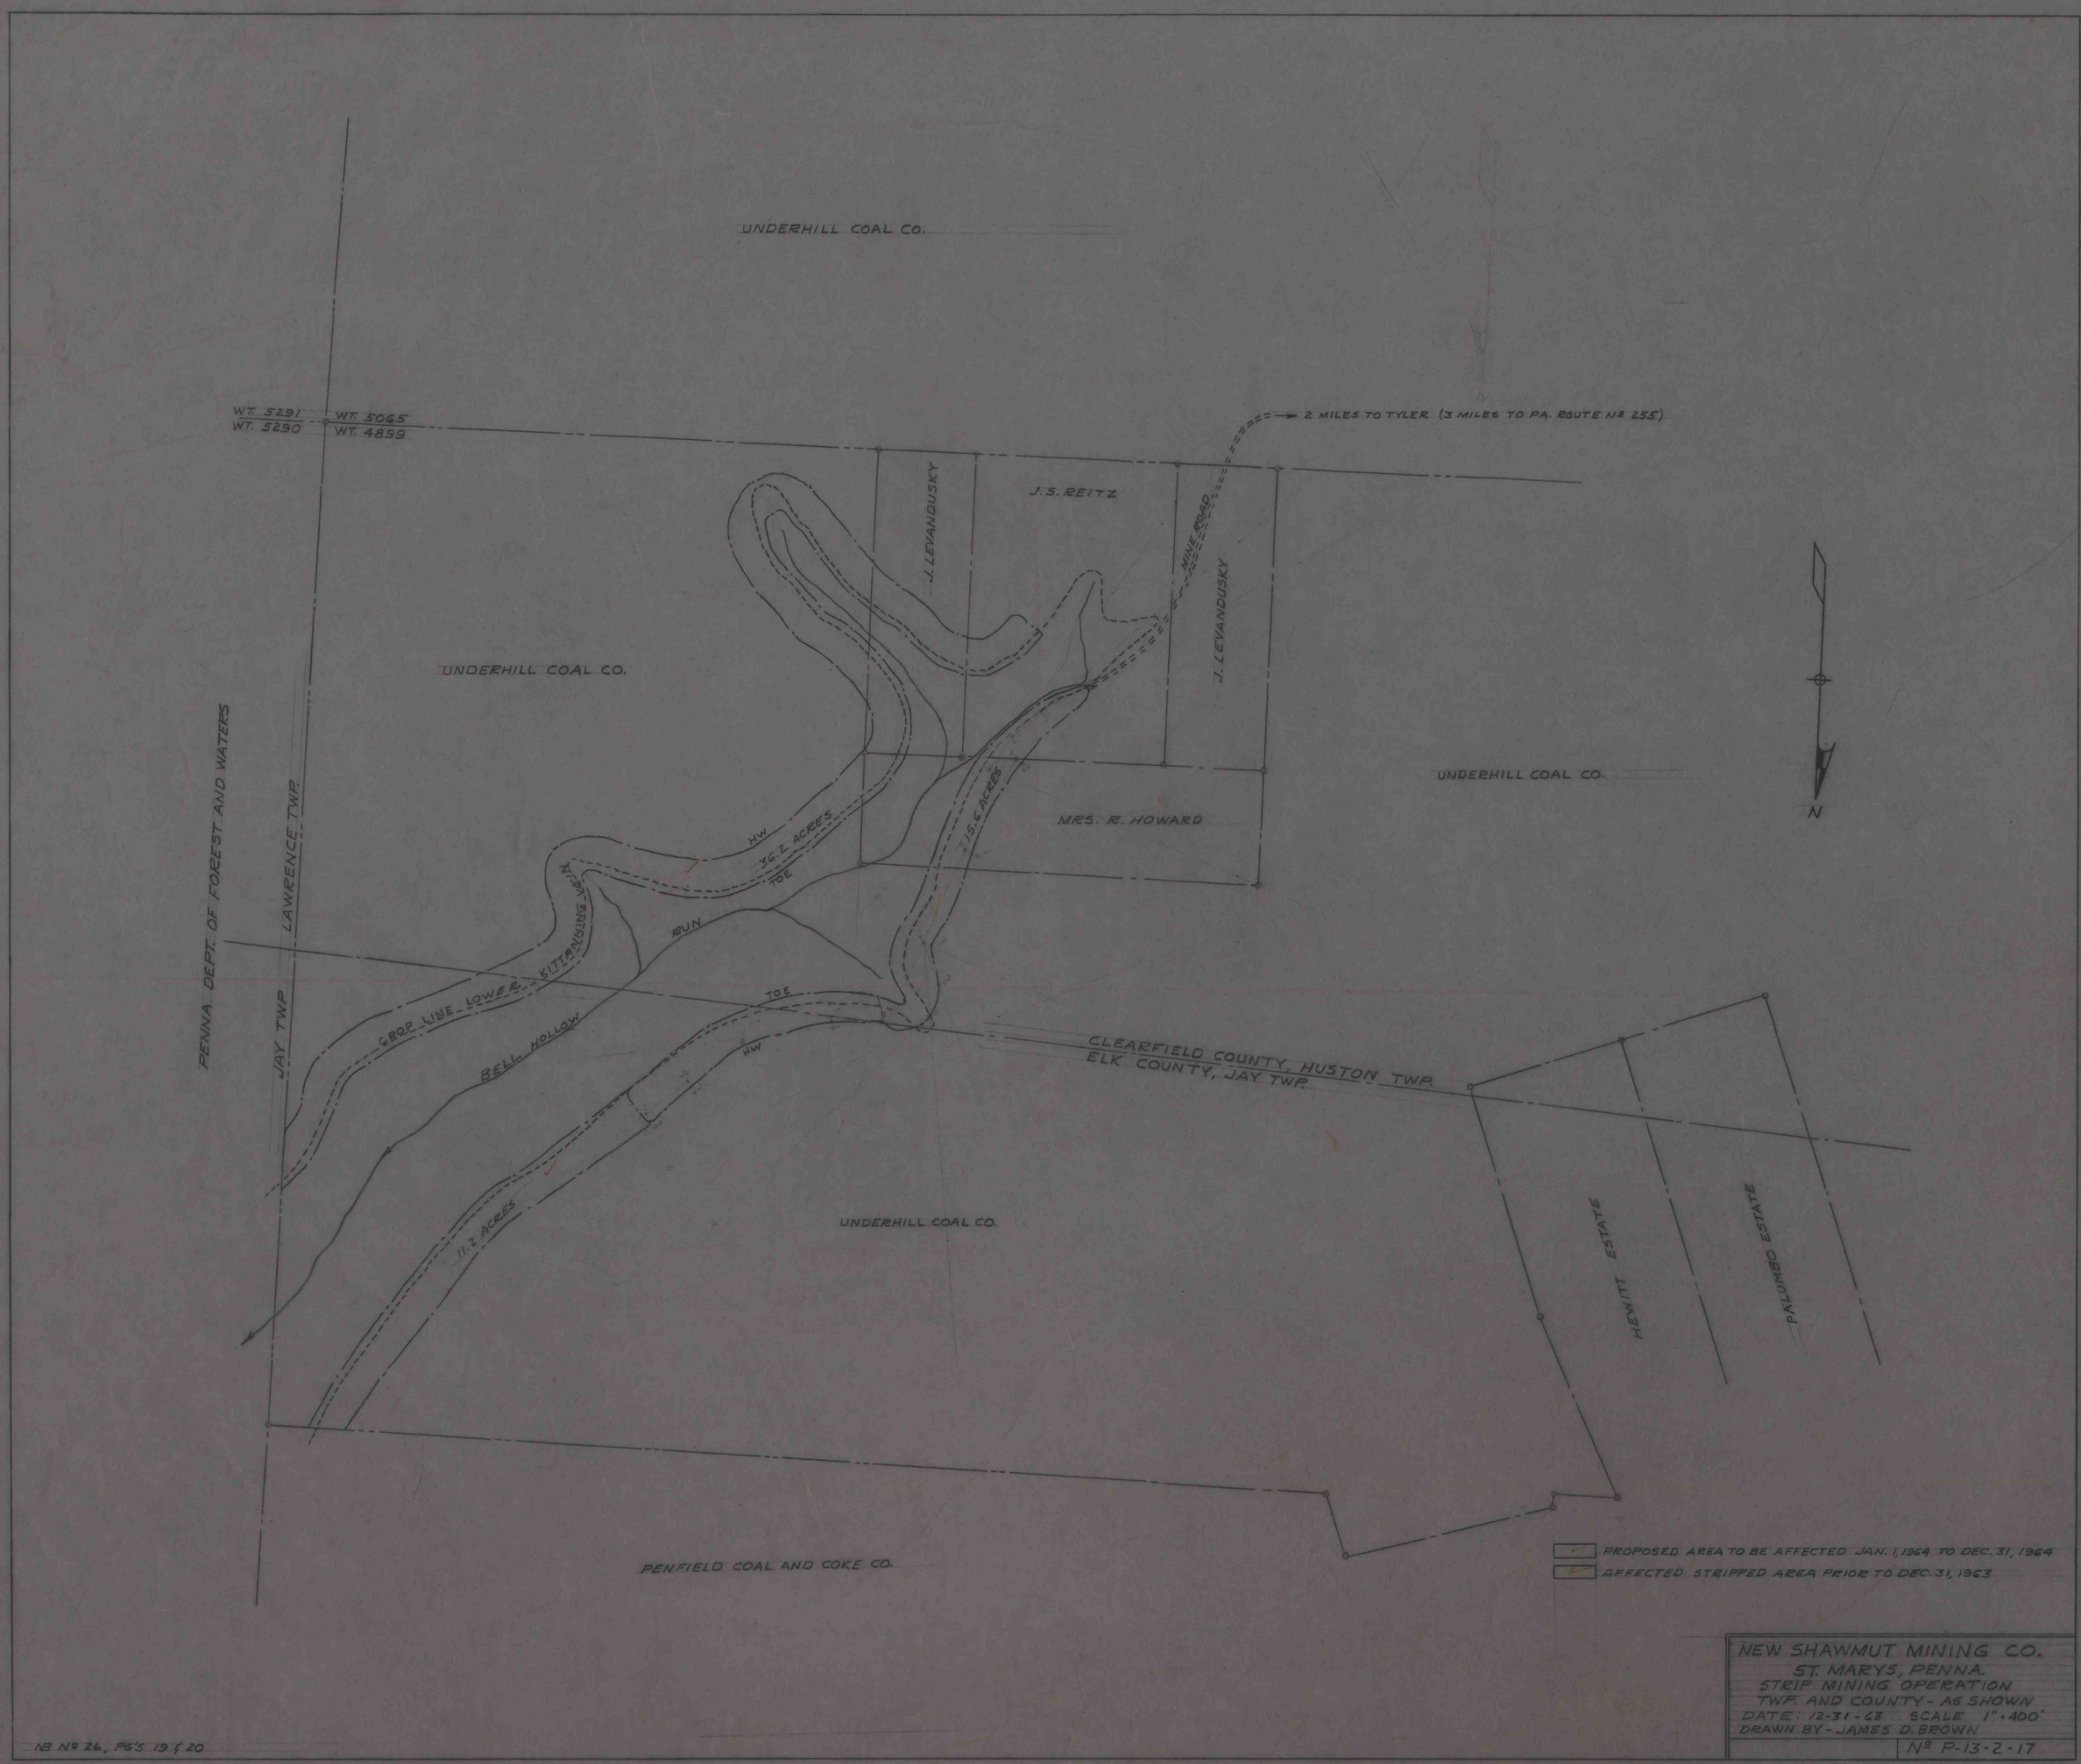

NB Nº 26, PG'S 19 & 20

IMAPS 16347