

TO AD SMITH ROAD

PENFIELD WATER CO - SURF

BENNETTS BRANCH RES - MIN.

PLOT OF STRIP MINE BACK FILL

PA. DEPT. OF FOREST & WATERS - SURF

NEW SHAWMUT MINING CO - MIN.

TOTAL ~ 73.1 ACS.

TO PENFIELD
MILL RUN

MISSION LINE

Back fill
11.57 ACS.
& Penfield
1962

4890
4889

4901
4902

FOX TWP.
HUSTON TWP.

1/4 OM
SKRANSKI'S MINE

ELK COUNTY
CLEARFIELD CO.

MILL RUN


TO MILL RUN
APPROX. 2 MILES
ROUTE 255

DEPT. OF F & W ROAD

TO AD SMITH ROAD

31.0 ACS.

42.1 ACS.

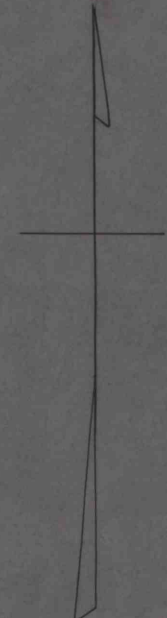

IMAPS #16362

P13-2

NEW SHAWMUT MINING CO.
ST. MARYS, PA.
SCALE - 1" = 400'
DATE - 4-23-63.
SURVEYED BY - L.H. BURCH
APPROVED BY - J.A.D.