


43569
130680

1150/130680

43520
22000
100/65560/655
600
556
500
560

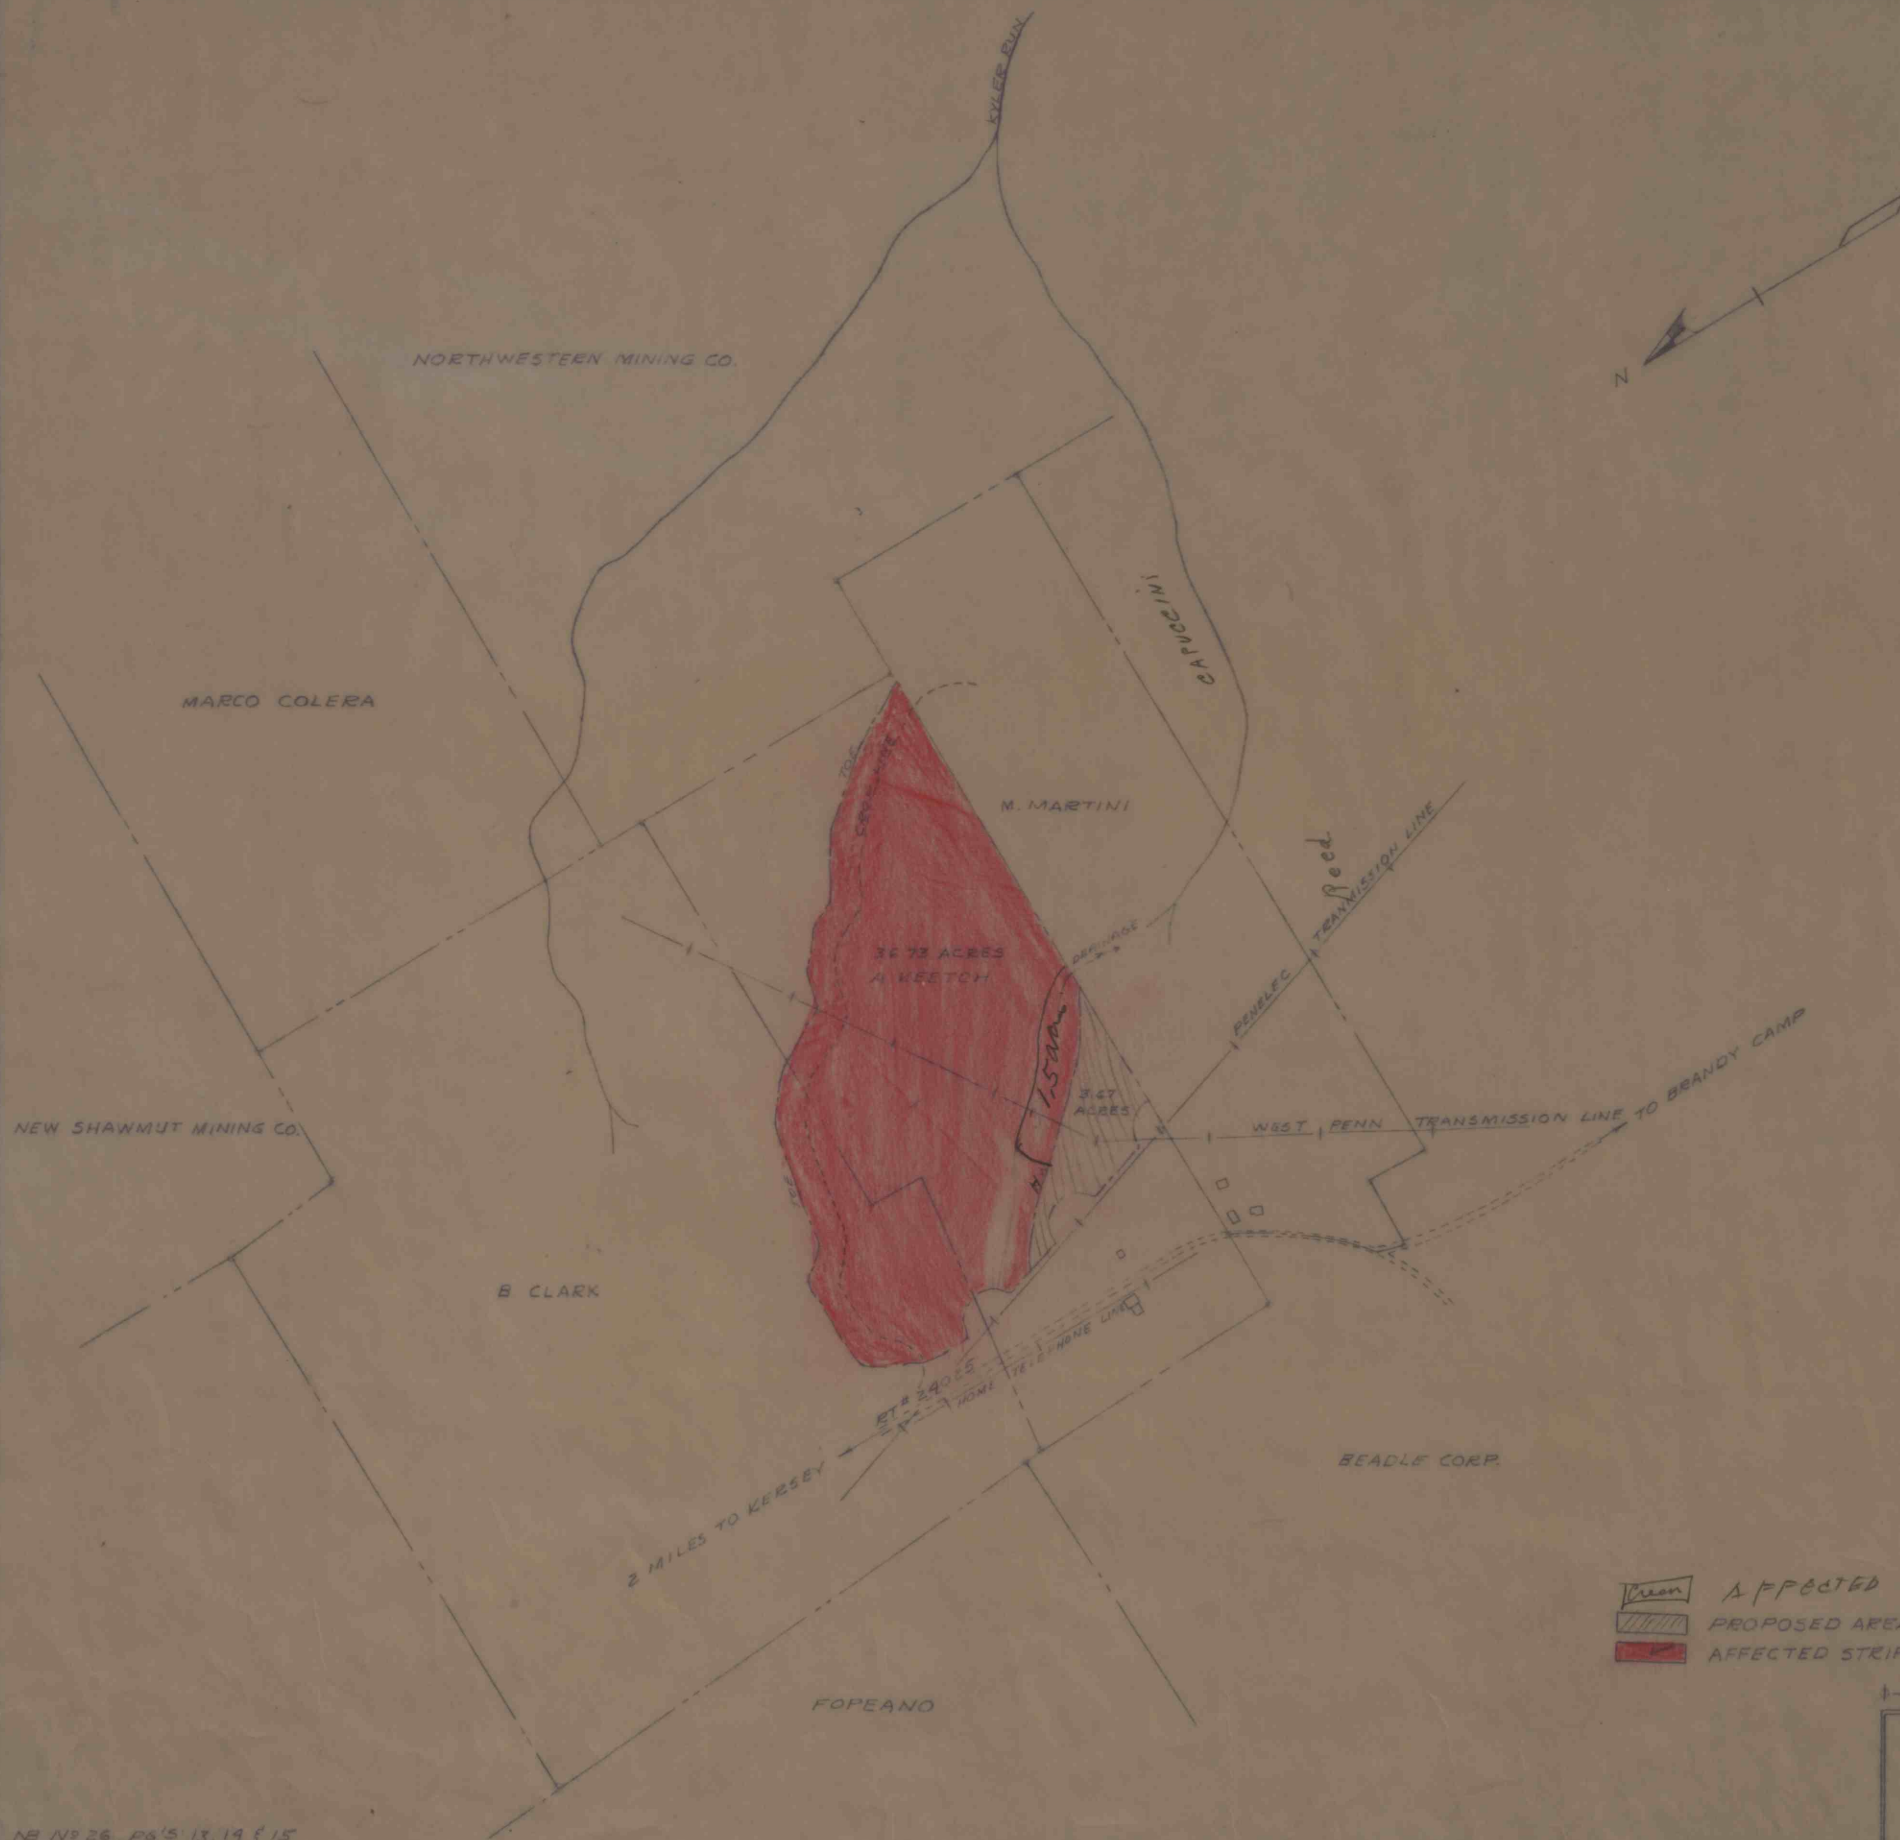

AFFECTED STRIPPED AREA AUG 1 TO DEC 31, 1963.
 PROPOSED AREA TO BE AFFECTED JAN. 1, 1964 TO DEC. 31, 1964
 AFFECTED STRIPPED AREA PRIOR TO DEC. 31, 1963

UTILITY LINES
NEW SHAWMUT MINING CO.
ST. MARYS, PENNA.
STRIP MINING OPERATION
FOX TOWNSHIP, ELK COUNTY
DATE: 12-13-63 SCALE: 1" = 400'
DRAWN BY: JAMES D. BROWN