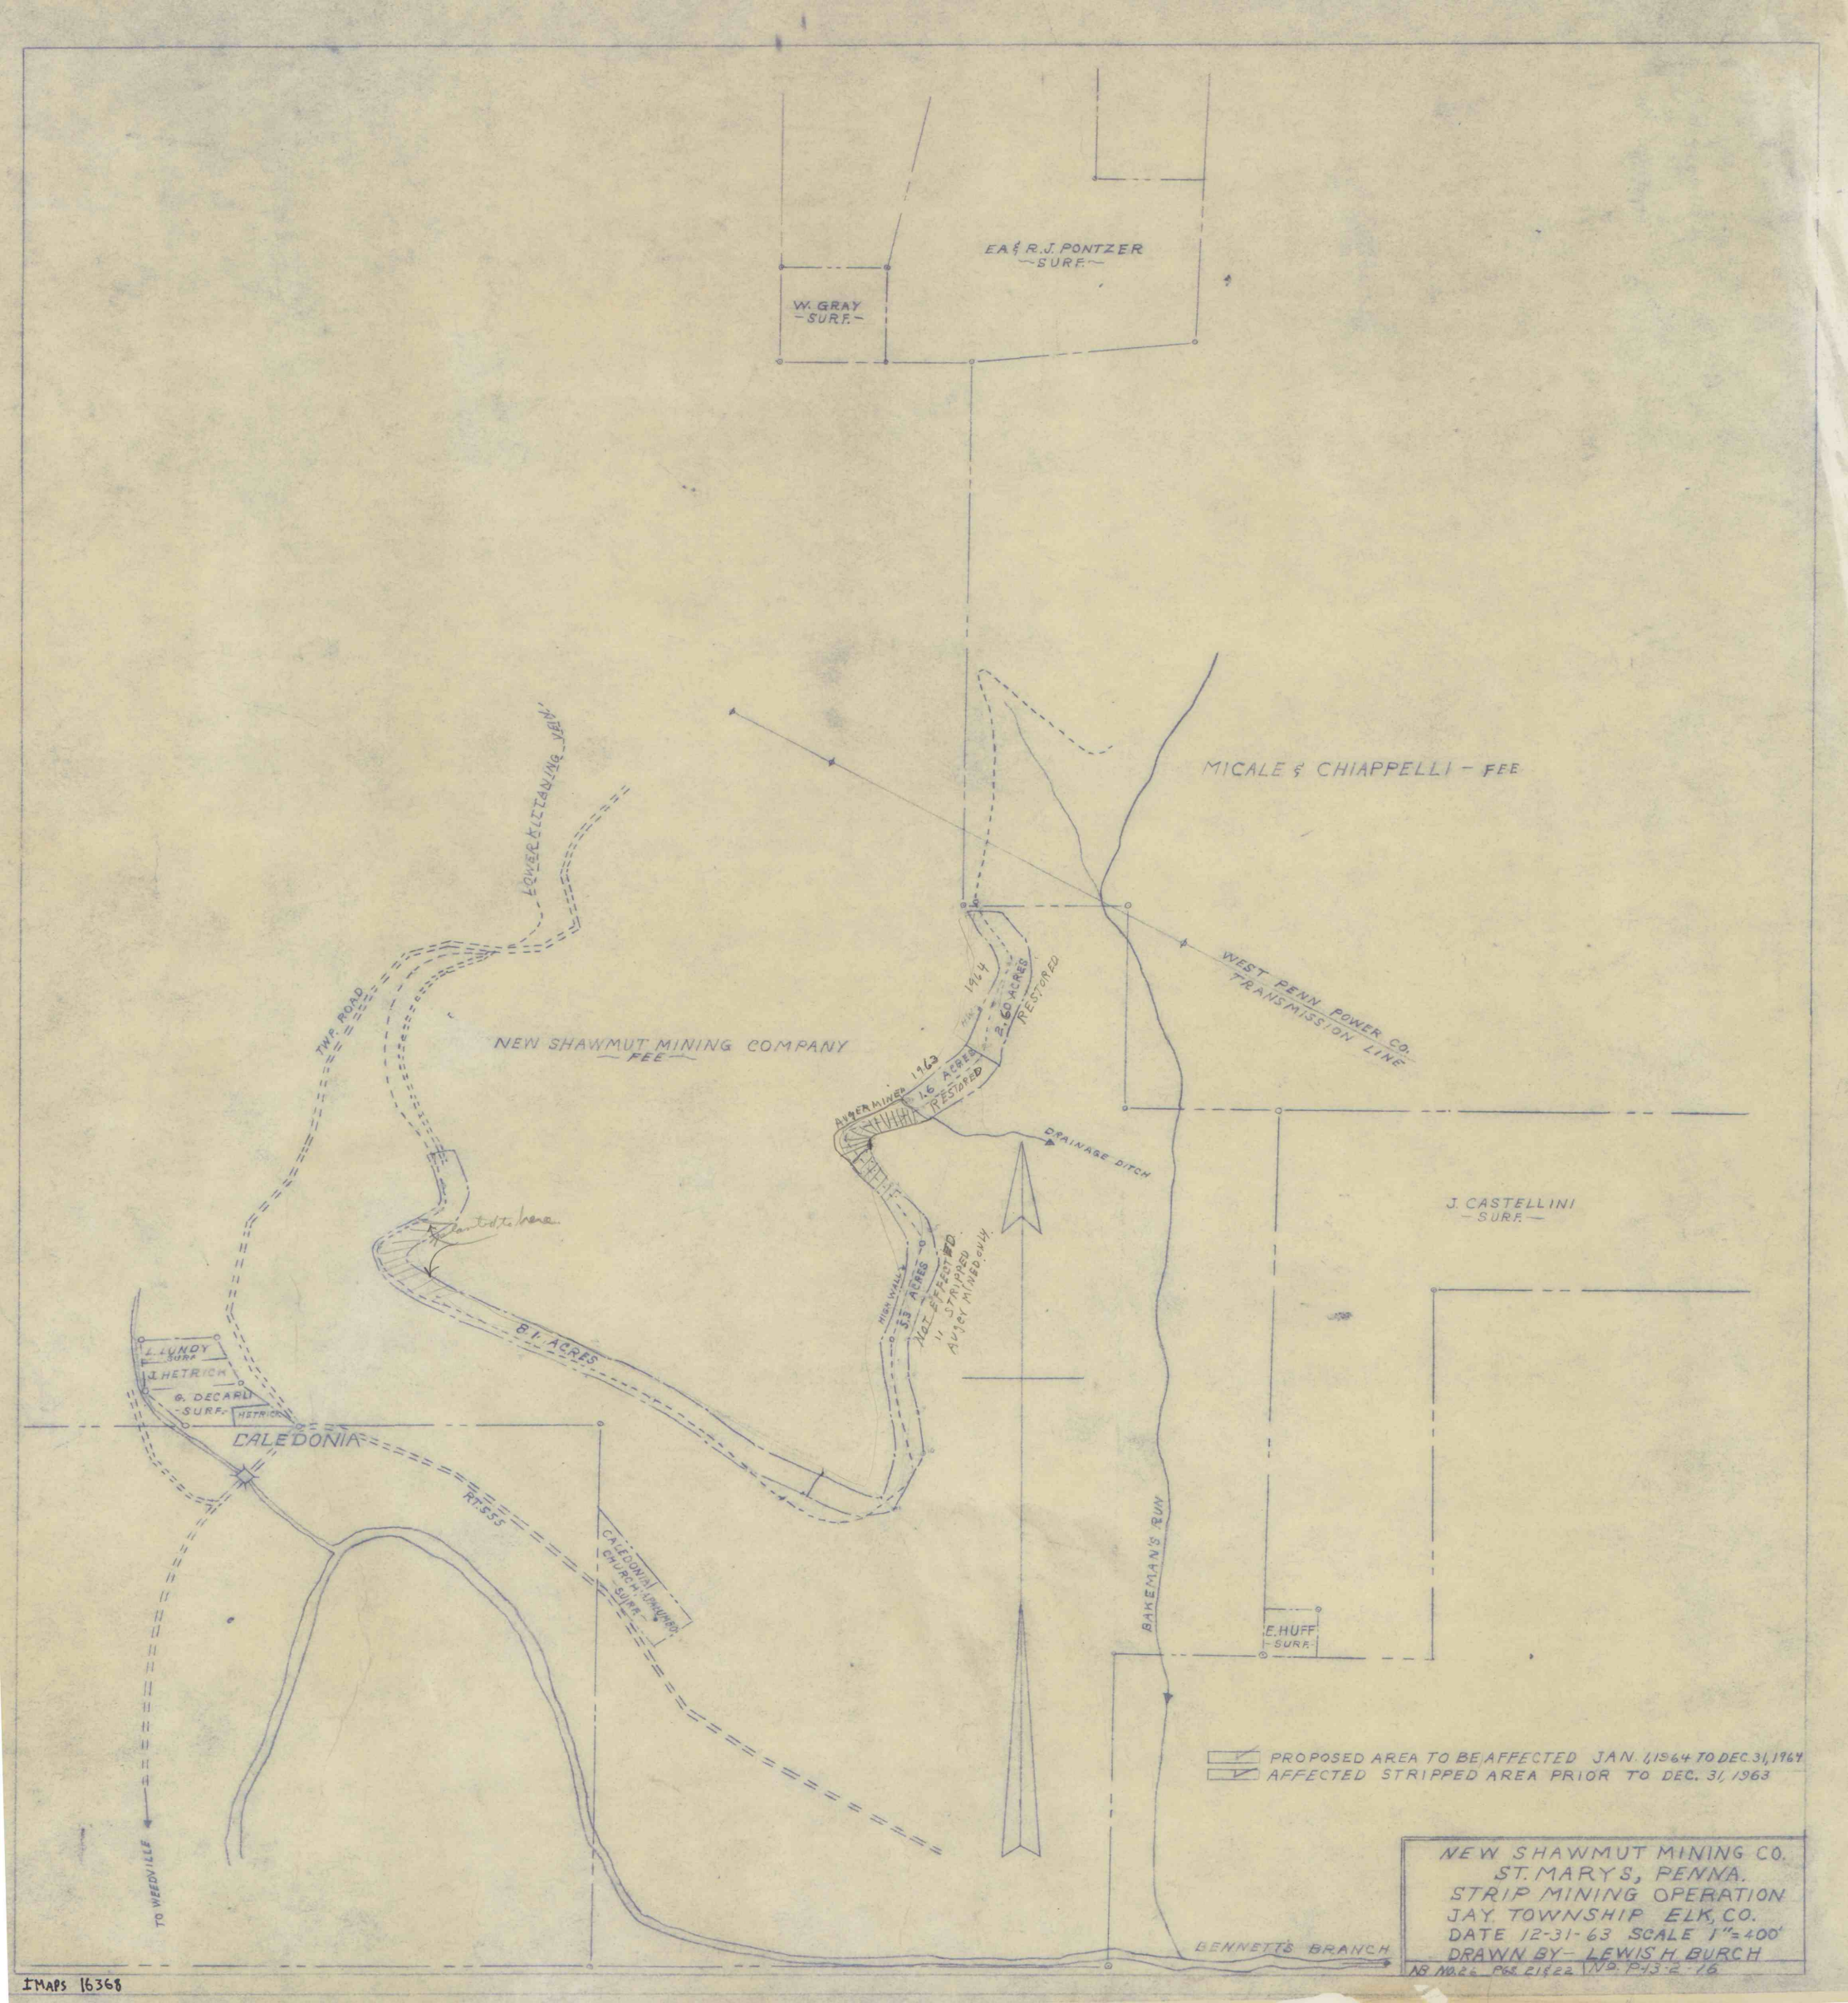
E.A. & R.J. PONTZER
SURF.
W. GRAY
SURF.
MICALE & CHIAPPELLI - FEE
WEST PENN POWER CO.
TRANSMISSION LINE
LOWER KITTANING VEIN
TWP. ROAD
NEW SHAWMUT MINING COMPANY
FEE
1964
2.60 ACRES
RESTORED
AUGER MINED
1963
1.6 ACRES
RESTORED
DRAINAGE DITCH
J. CASTELLINI
SURF.
HIGH WALL
5.5 ACRES
NOT EFFECTED
11 STRIPPED
AUGER MINED ON H.
8.1 ACRES
L. LUNDY
SURF.
J. HETRICH
G. DECARO
SURF.
HETRICH
CALEDONIA
RT. 555
CALEDONIA LUTHERAN CHURCH
SURF.
BAKEMAN'S RUN
E. HUFF
SURF.
PROPOSED AREA TO BE AFFECTED JAN. 1, 1964 TO DEC. 31, 1964
AFFECTED STRIPPED AREA PRIOR TO DEC. 31, 1963
TO WEEDVILLE
BENNETT'S BRANCH
NEW SHAWMUT MINING CO.
ST. MARYS, PENNA.
STRIP MINING OPERATION
JAY TOWNSHIP ELK, CO.
DATE 12-31-63 SCALE 1" = 400'
DRAWN BY - LEWIS H. BURCH
NB NO. 26 PGS. 21 & 22 No. P-13-2-16

IMAPS 16368