


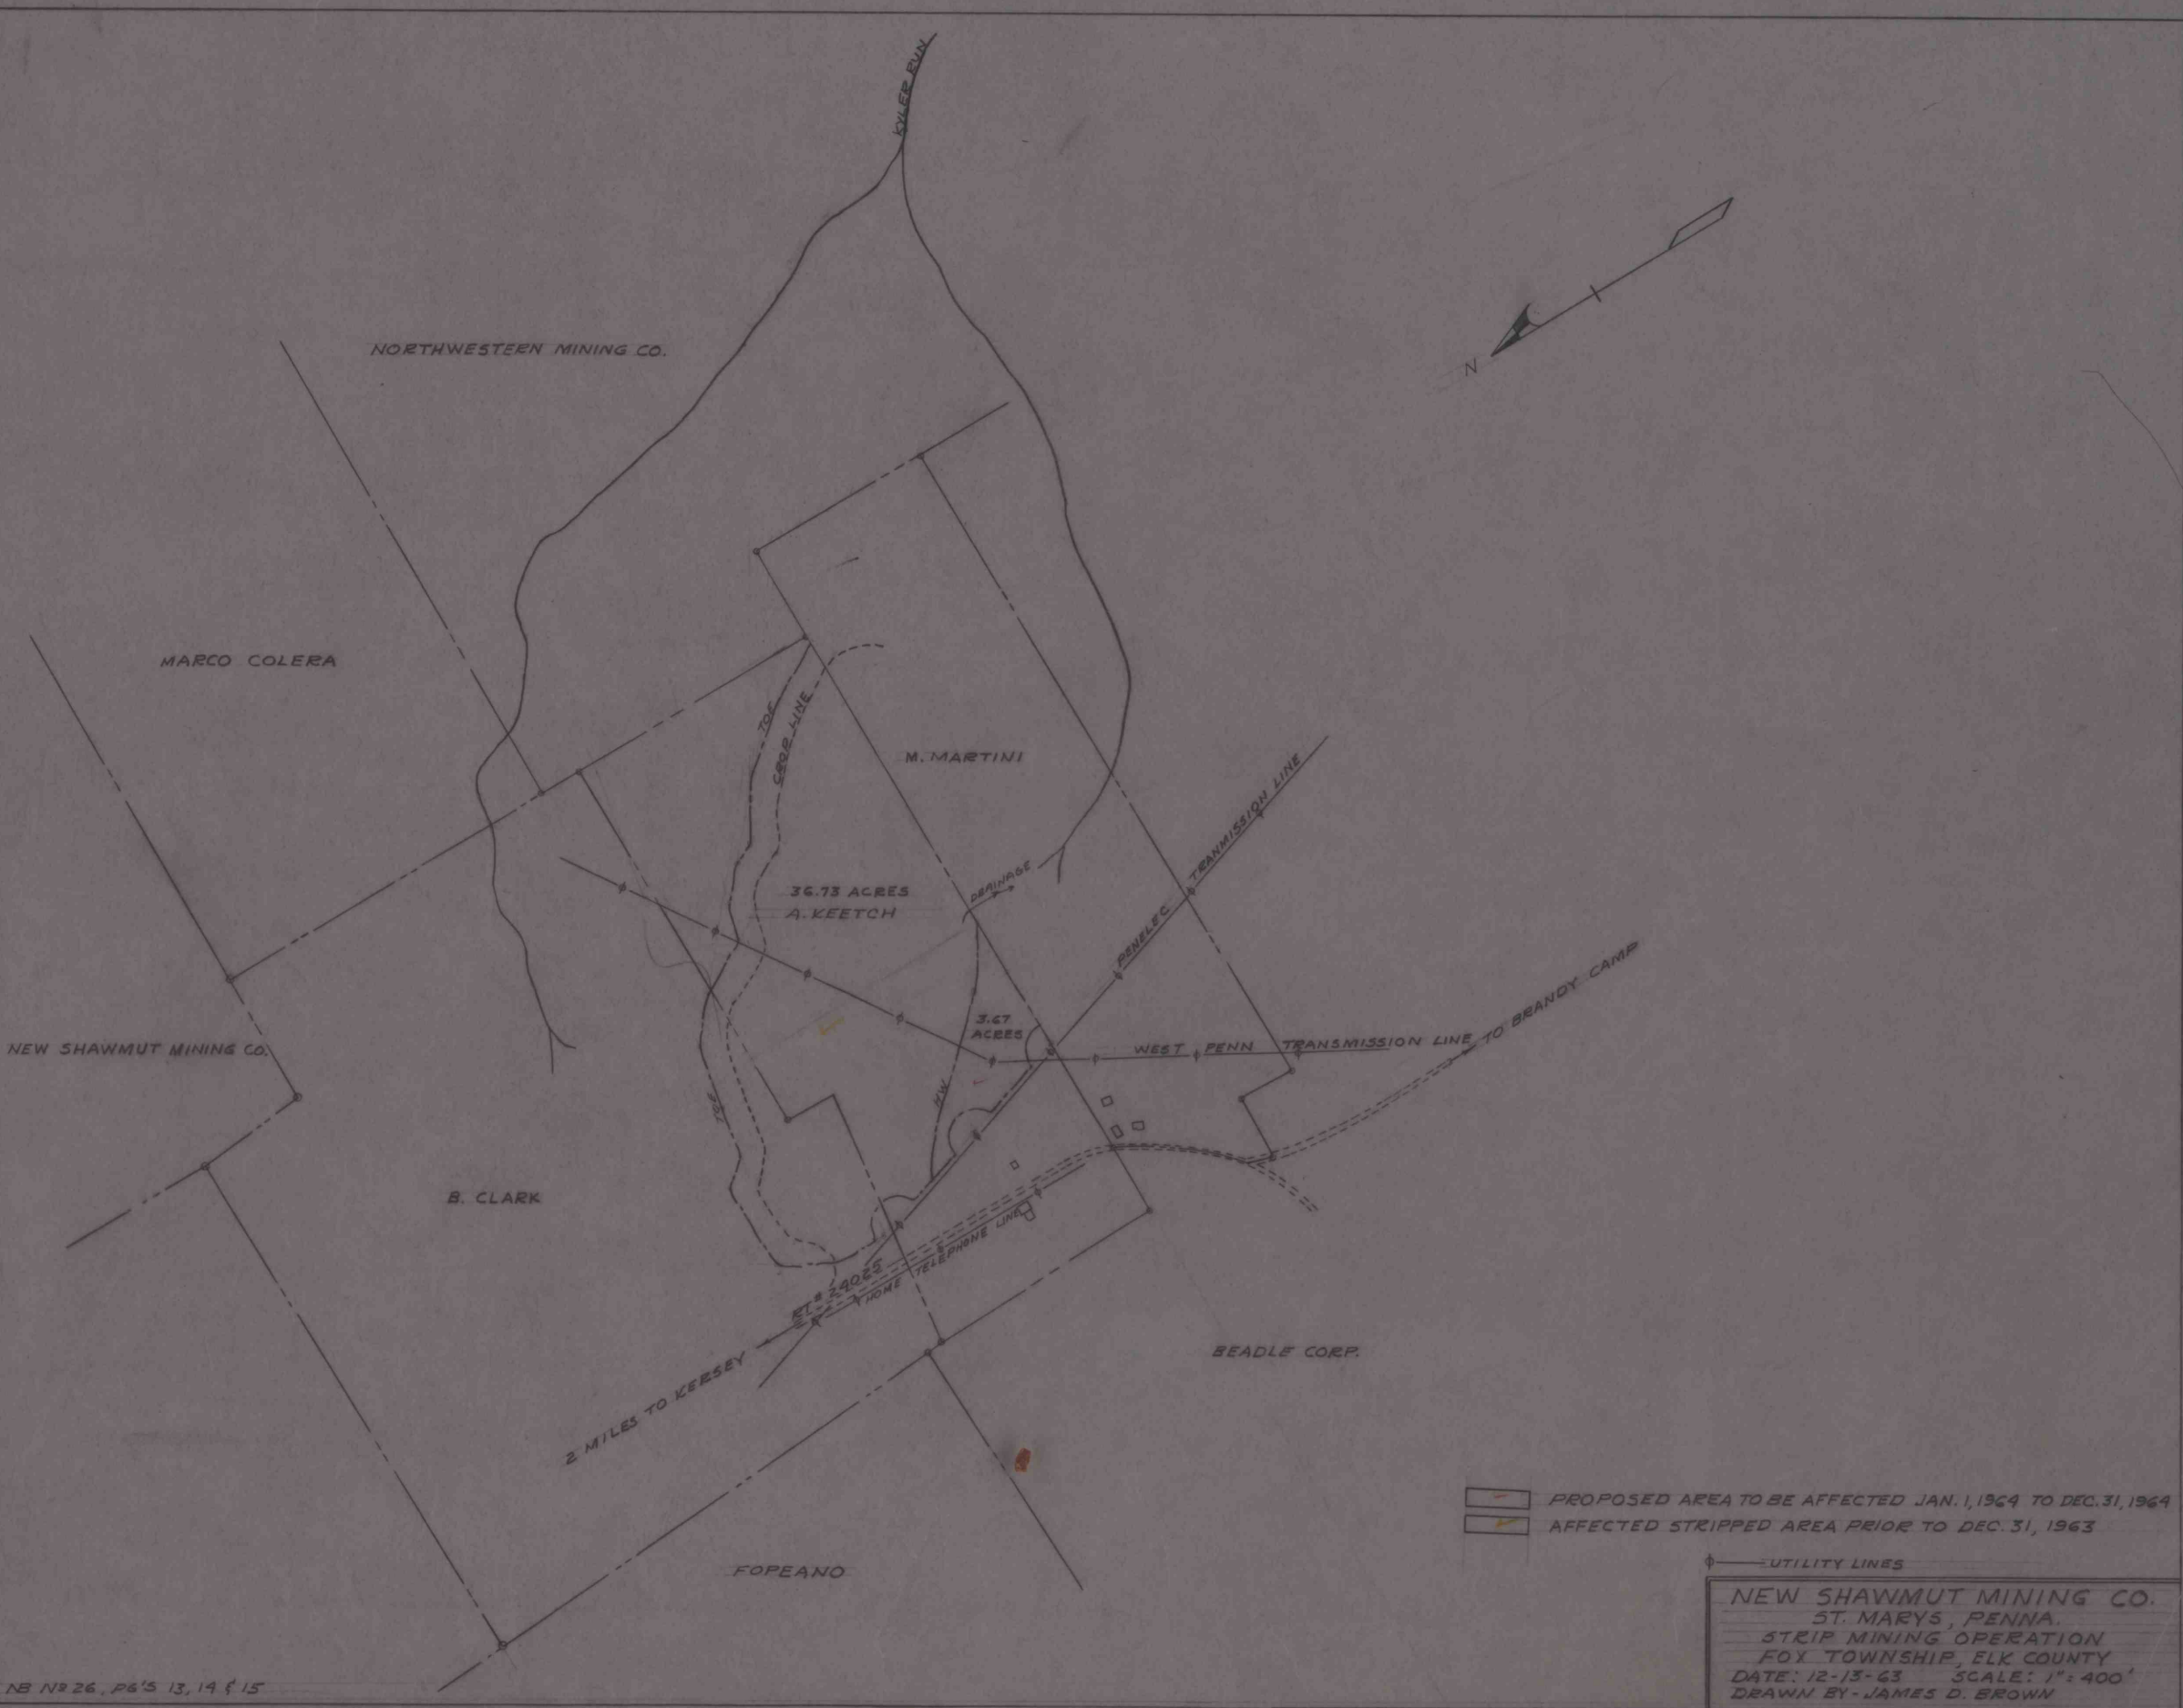

NB N° 26, P6'S 13, 14 & 15

IMAPS 46369 16369

BACK FILL COMPLETED & PLANTED 1964
2 Cym. per planter

N° P-13-2-15