


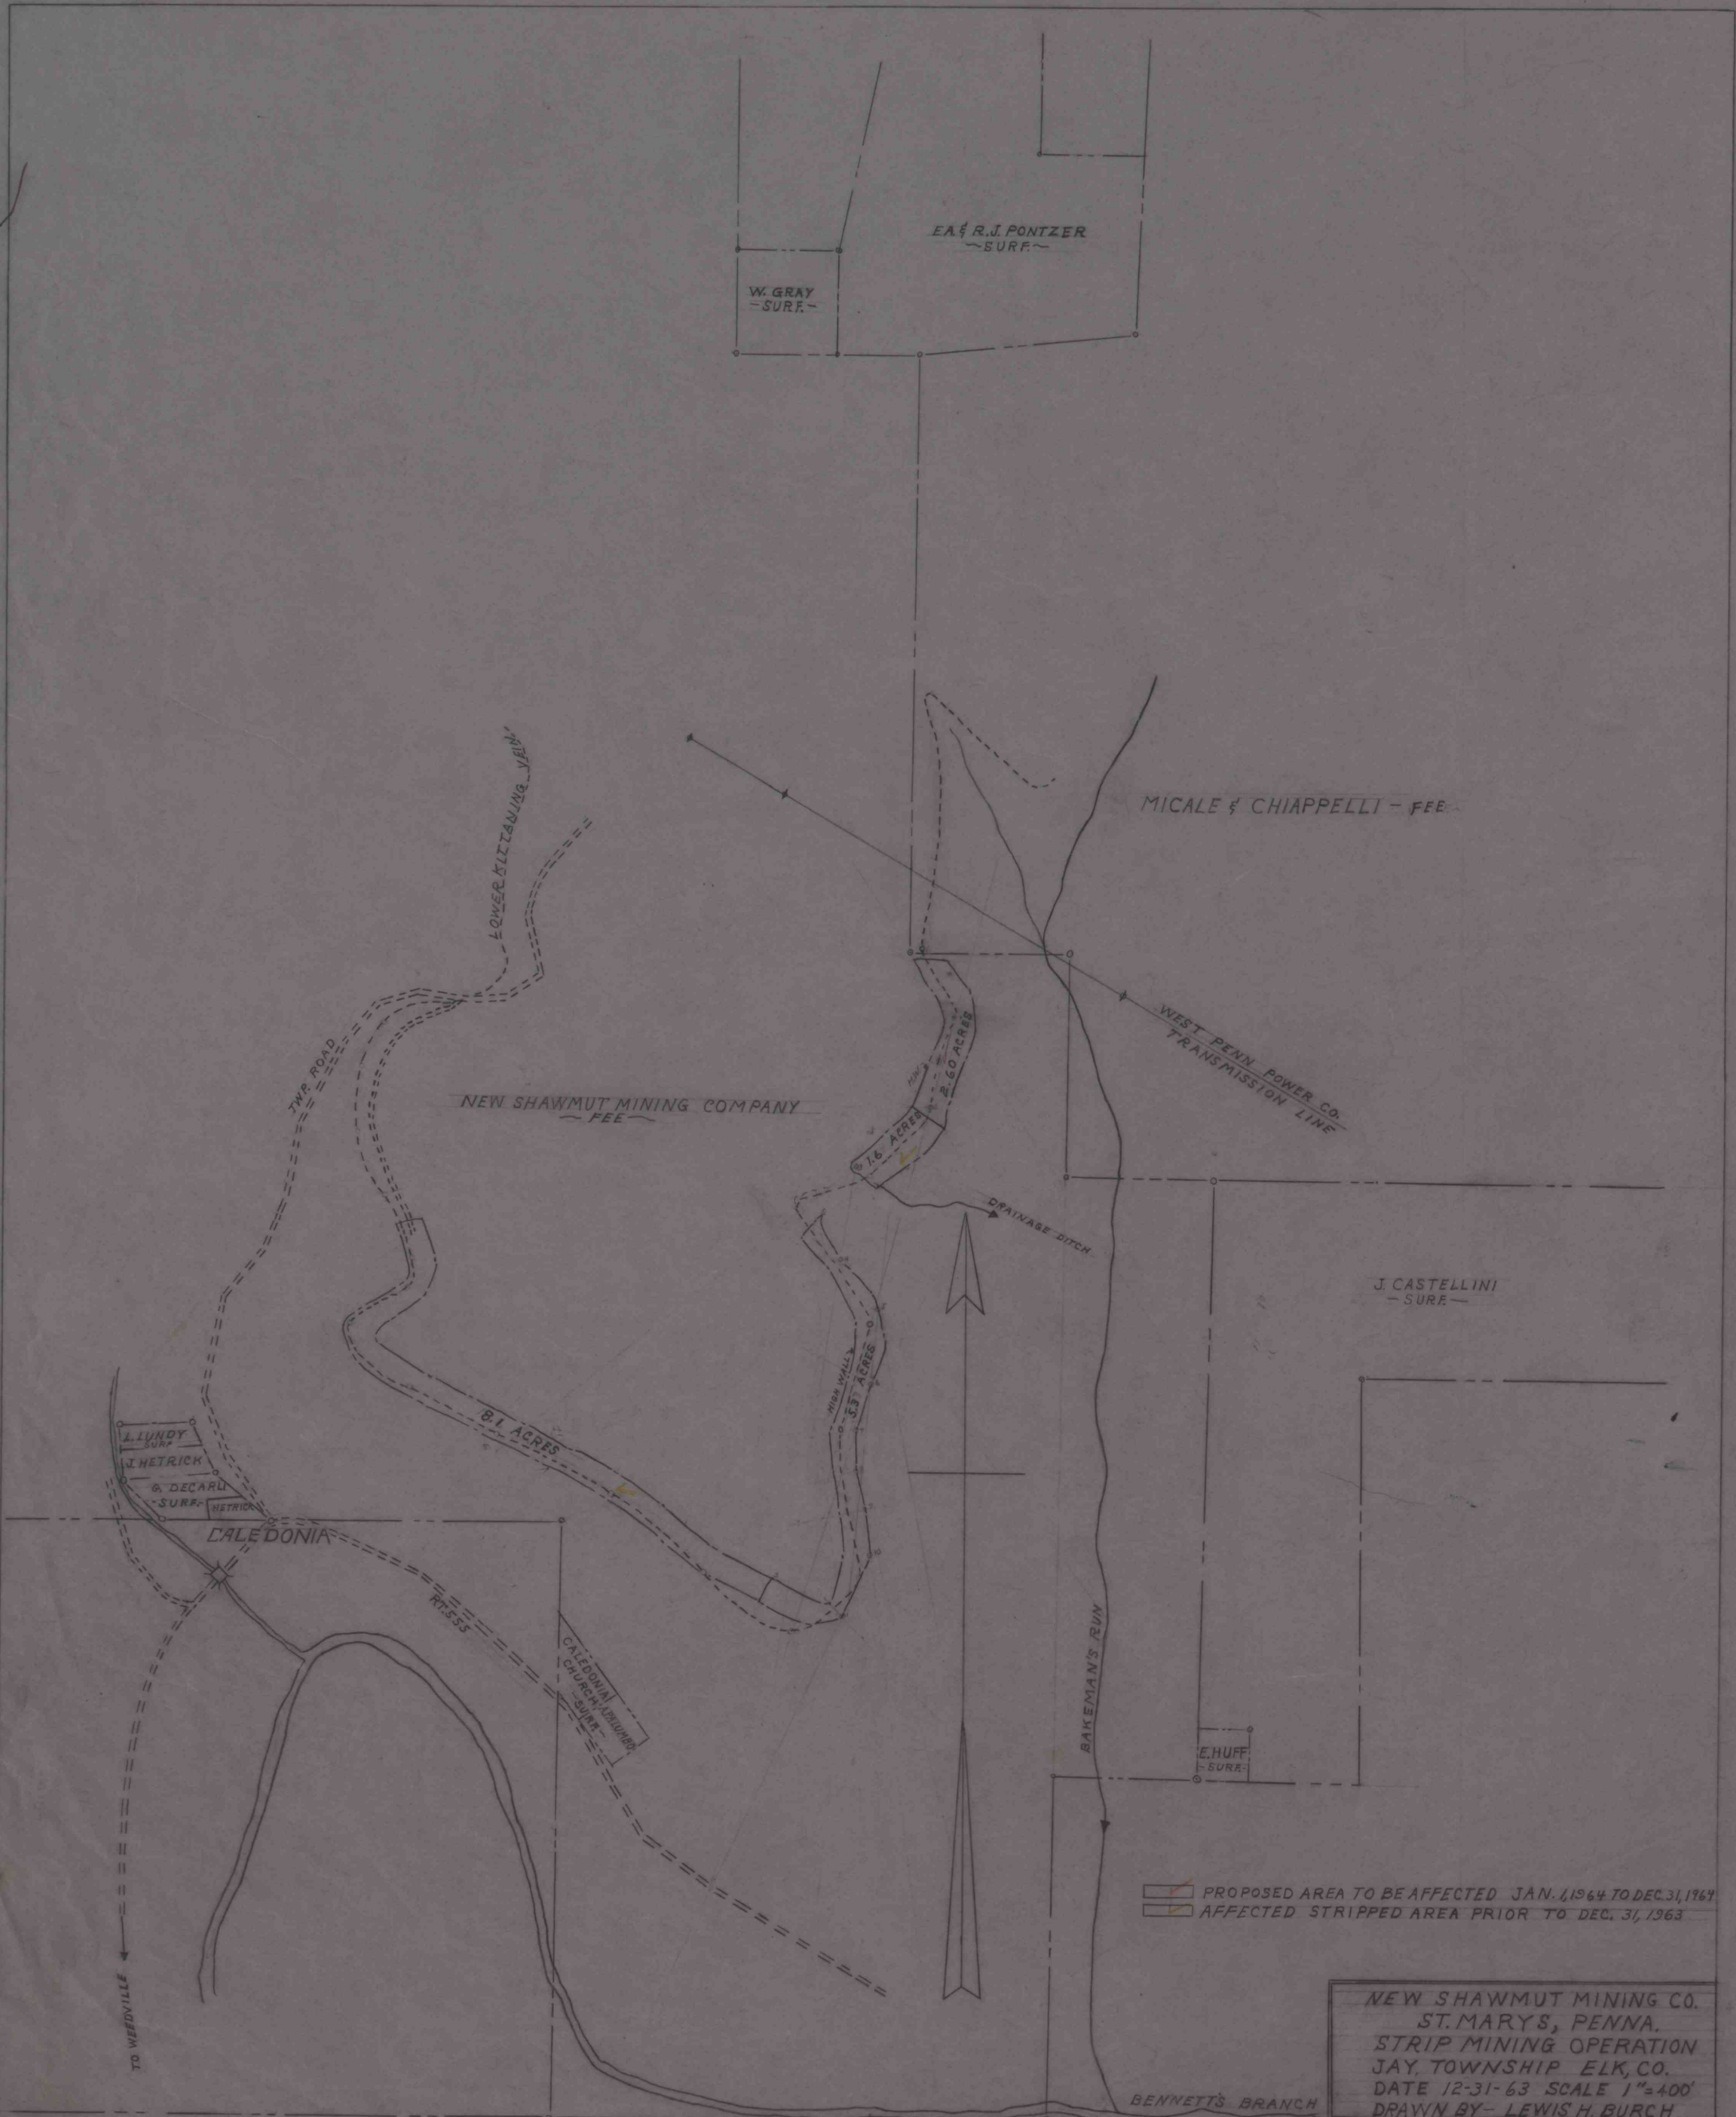

PROPOSED AREA TO BE AFFECTED JAN. 1, 1964 TO DEC. 31, 1964
AFFECTED STRIPPED AREA PRIOR TO DEC. 31, 1963

NEW SHAWMUT MINING CO.
ST. MARYS, PENNA.
STRIP MINING OPERATION
JAY TOWNSHIP ELK CO.
DATE 12-31-63 SCALE 1"=400'
DRAWN BY- LEWIS H. BURCH
AB 10024 Pgs 21 & 22 No. P-13-2-16