


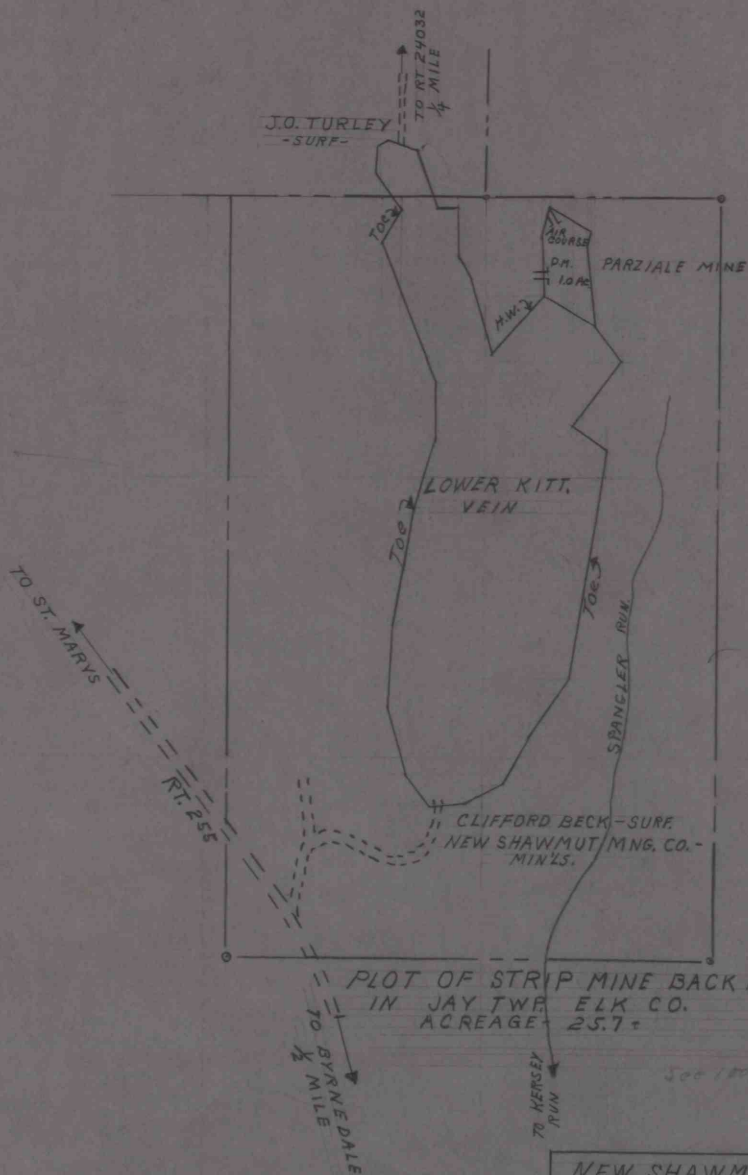

NEW SHAWMUT MINING CO.
 ST. MARYS, PA.
 SCALE - 1/4 inch = 400 ft.
 DATE - SEPT 23, 1963
 DRAWN BY - L.H. BURCH
 APPROVED BY -

F 16-1