
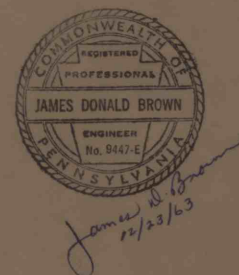


ST #21009
TO KERSEY 4 MILES
CYLERS CORNERS ERIE RR
TOBY CREEK

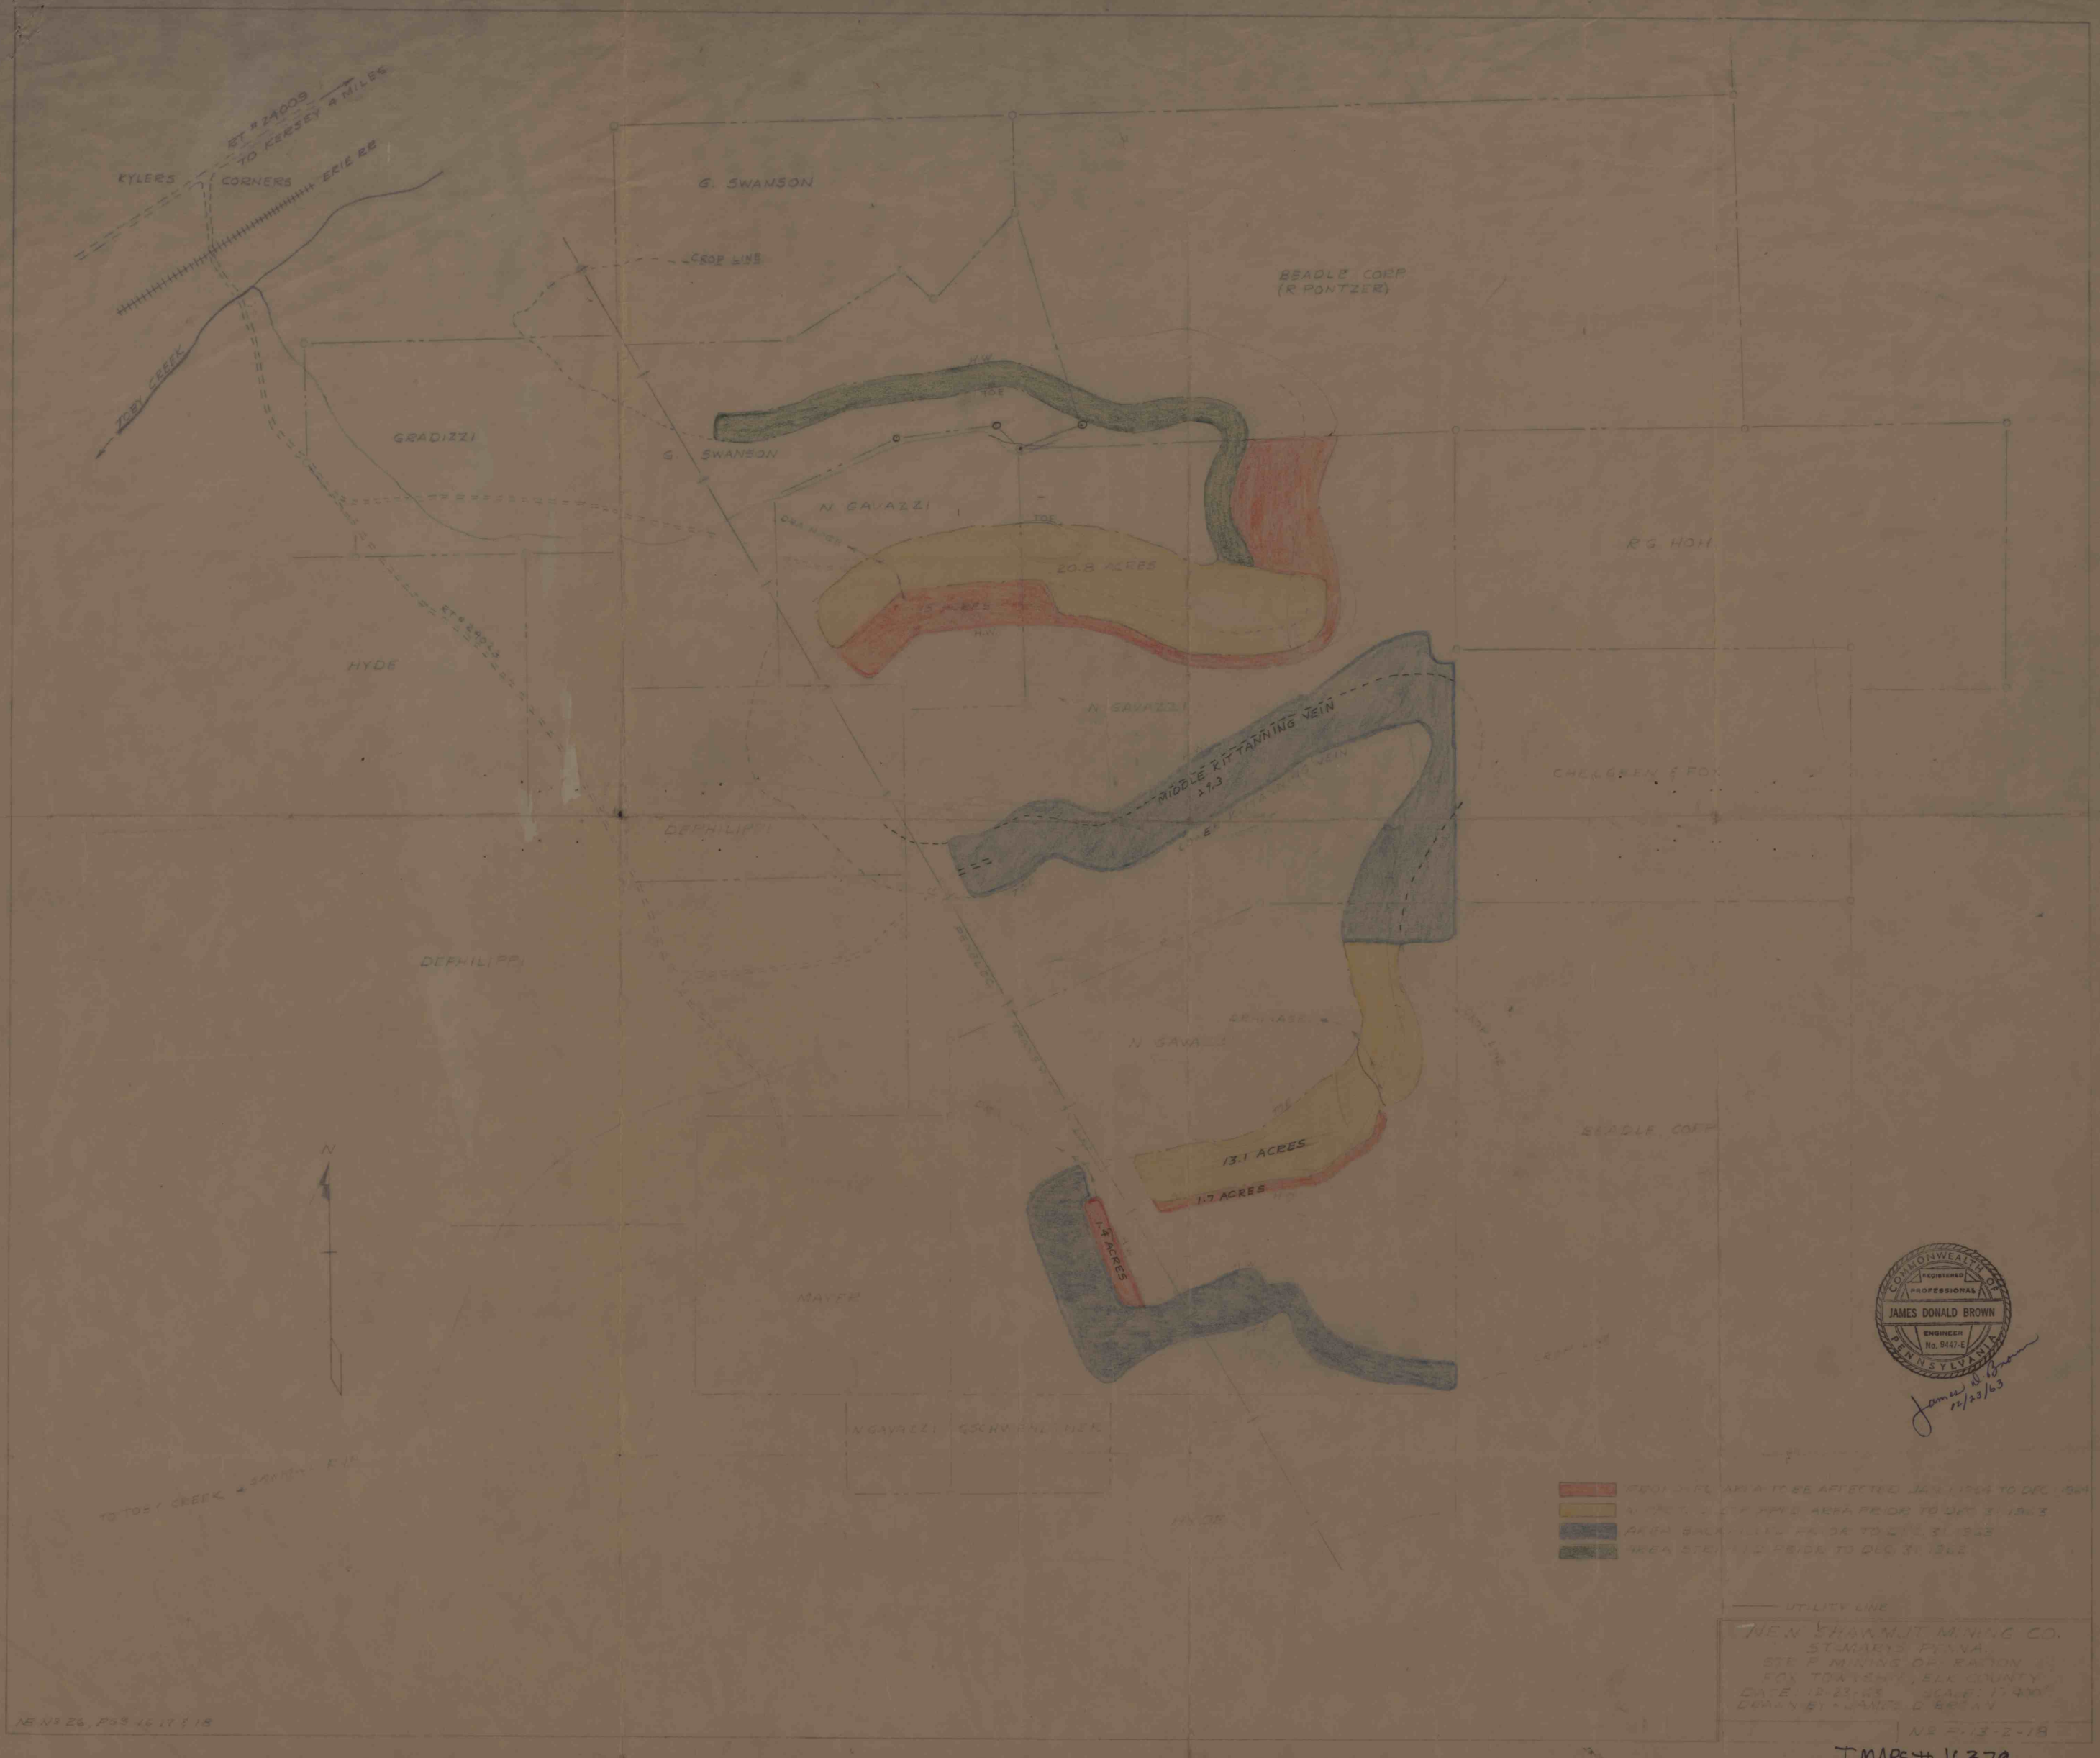


UTILITY LINE
NEW SHANNUT MINING CO.
ST. MARYS, PENN.
STEEL MINING OF EASTON
FOX TOWNSHIP, ELK COUNTY
DATE: 12-23-63 SCALE: 1"=400'
DRAWN BY: JAMES D. BROWN
NS P-13-2-18