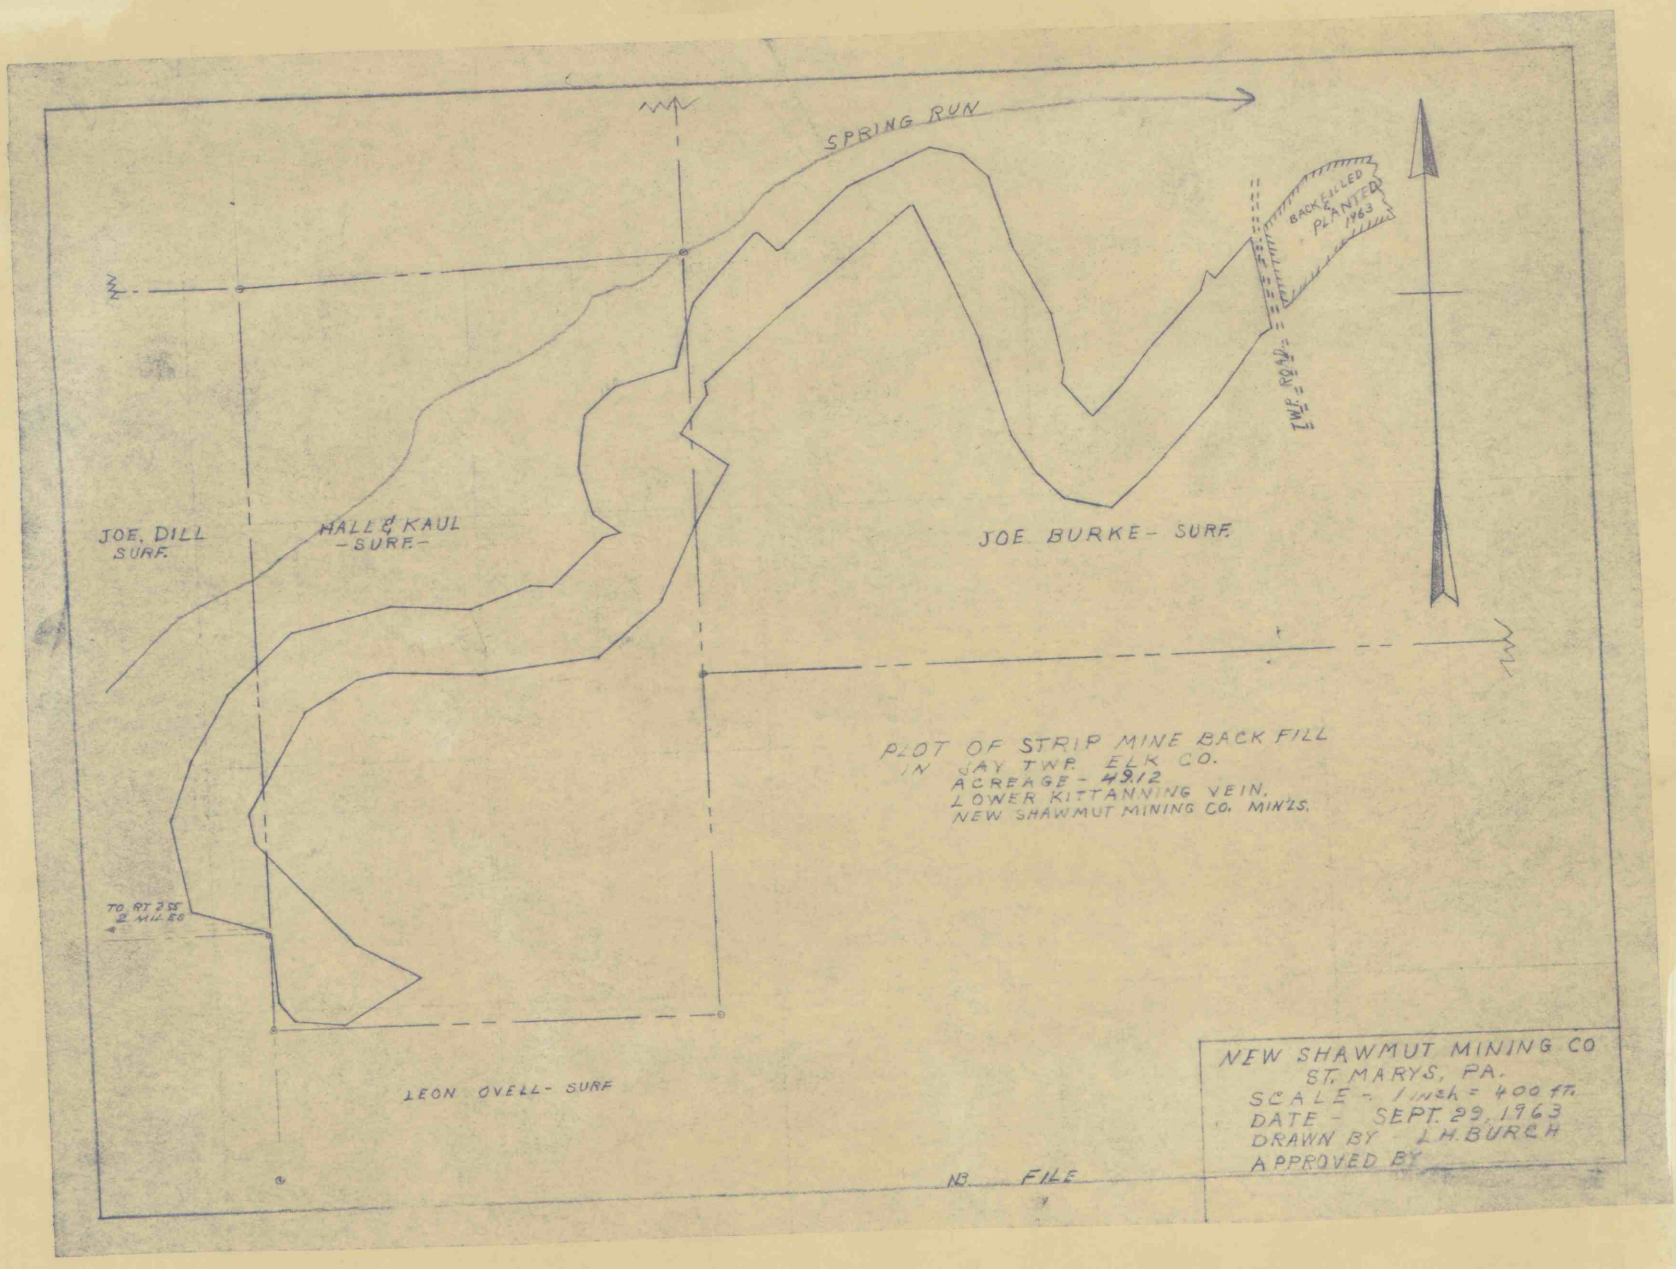
SPRING RUN
BACKFILLED & PLANTED 1963
JOE. DILL SURF.
HALL & KAUL -SURF-
JOE BURKE- SURF.
PLOT OF STRIP MINE BACK FILL
IN JAY TWP. ELK CO.
ACREAGE - 49.2
LOWER KITTANNING VEIN.
NEW SHAWMUT MINING CO. MIN'LS.
TO RT 255 2 MILES
LEON OVELL- SURF
NEW SHAWMUT MINING CO
ST. MARYS, PA.
SCALE - 1 inch = 400 ft.
DATE - SEPT. 29, 1963
DRAWN BY - L.H. BURCH
APPROVED BY
NB. FILE

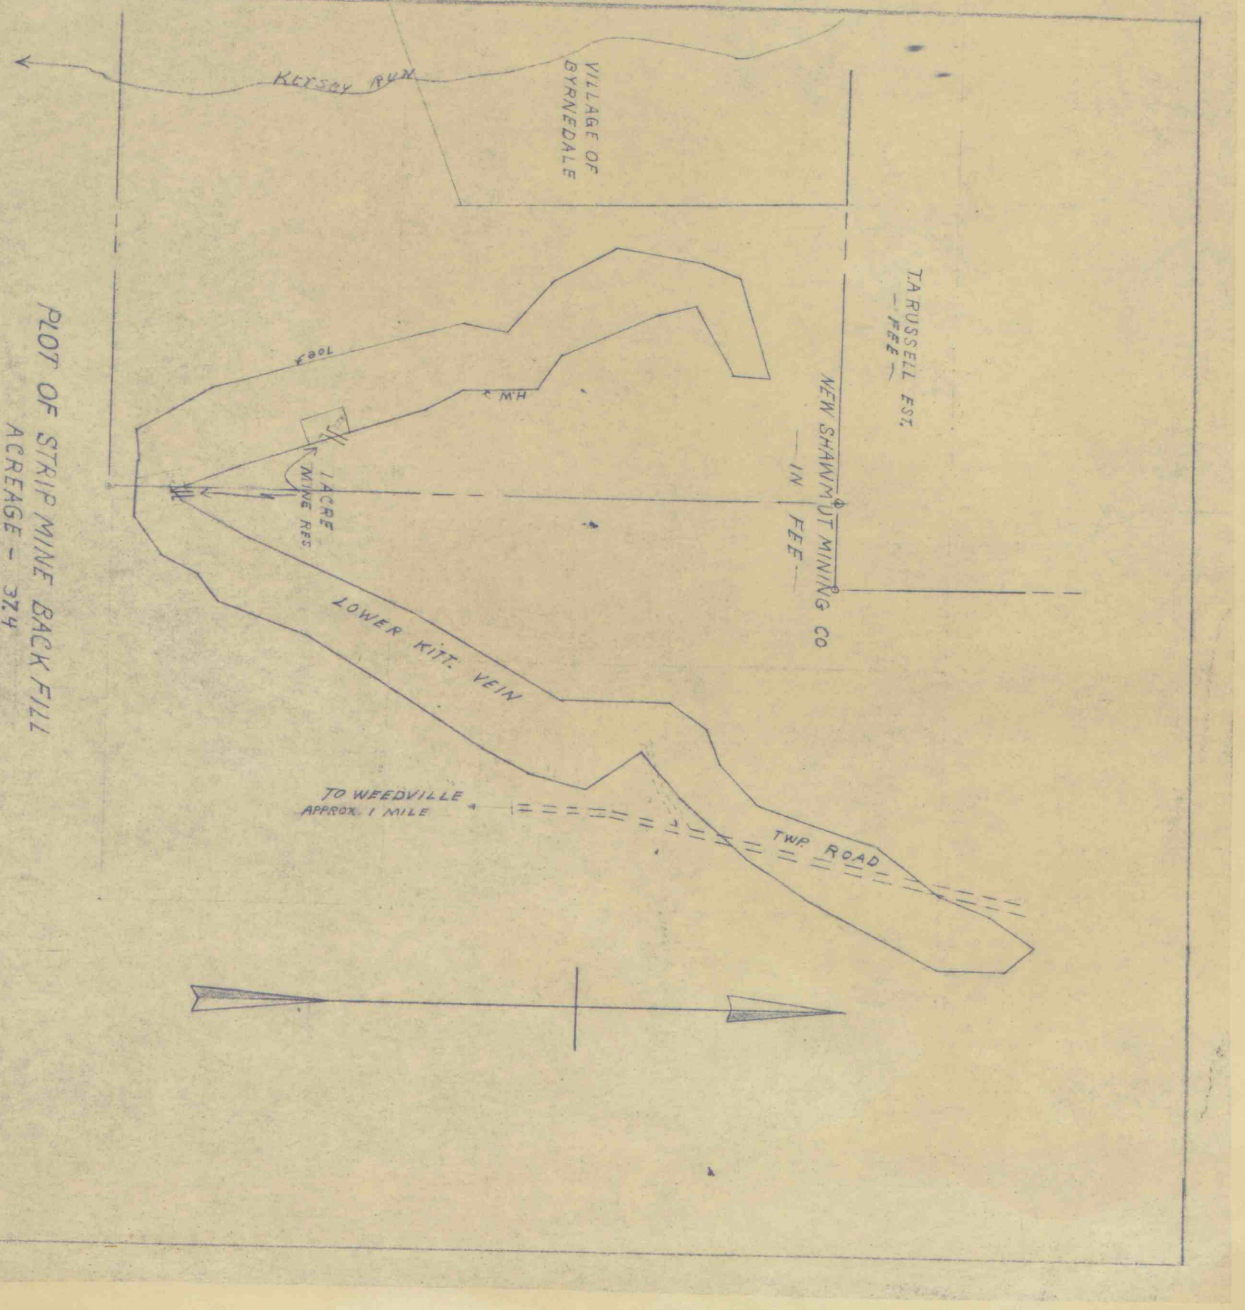
KERSEY RUN
VILLAGE OF BYRNEDALE
TA RUSSELL EST. — FEE —
NEW SHAWMUT MINING CO — IN FEE —
100'
MH
1 ACRE STRIP MINE RES.
LOWER KITT. VEIN
TO WEEDVILLE APPROX. 1 MILE
TWP ROAD
PLOT OF STRIP MINE BACK FILL
ACREAGE - 37.4
NEW SHAWMUT MINING CO.
ST. MARYS, PA.
STRIP MINE IN JAY TWP.
ELK COUNTY
SCALE 1" = 400'
DATE SEPT. 29 1963
DRAWN BY L.H BURCH
APPROVED BY

IMAPs 16381