


BRANDY CAMP
PA
BRANDY CAMP
PA
BRANDY CAMP
PA

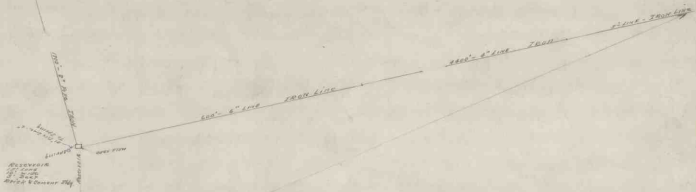

VILLAGE OF BRANDY CAMP
ELK CO. PA

SCALE 1 INCH = 100 FEET 4-8-28