


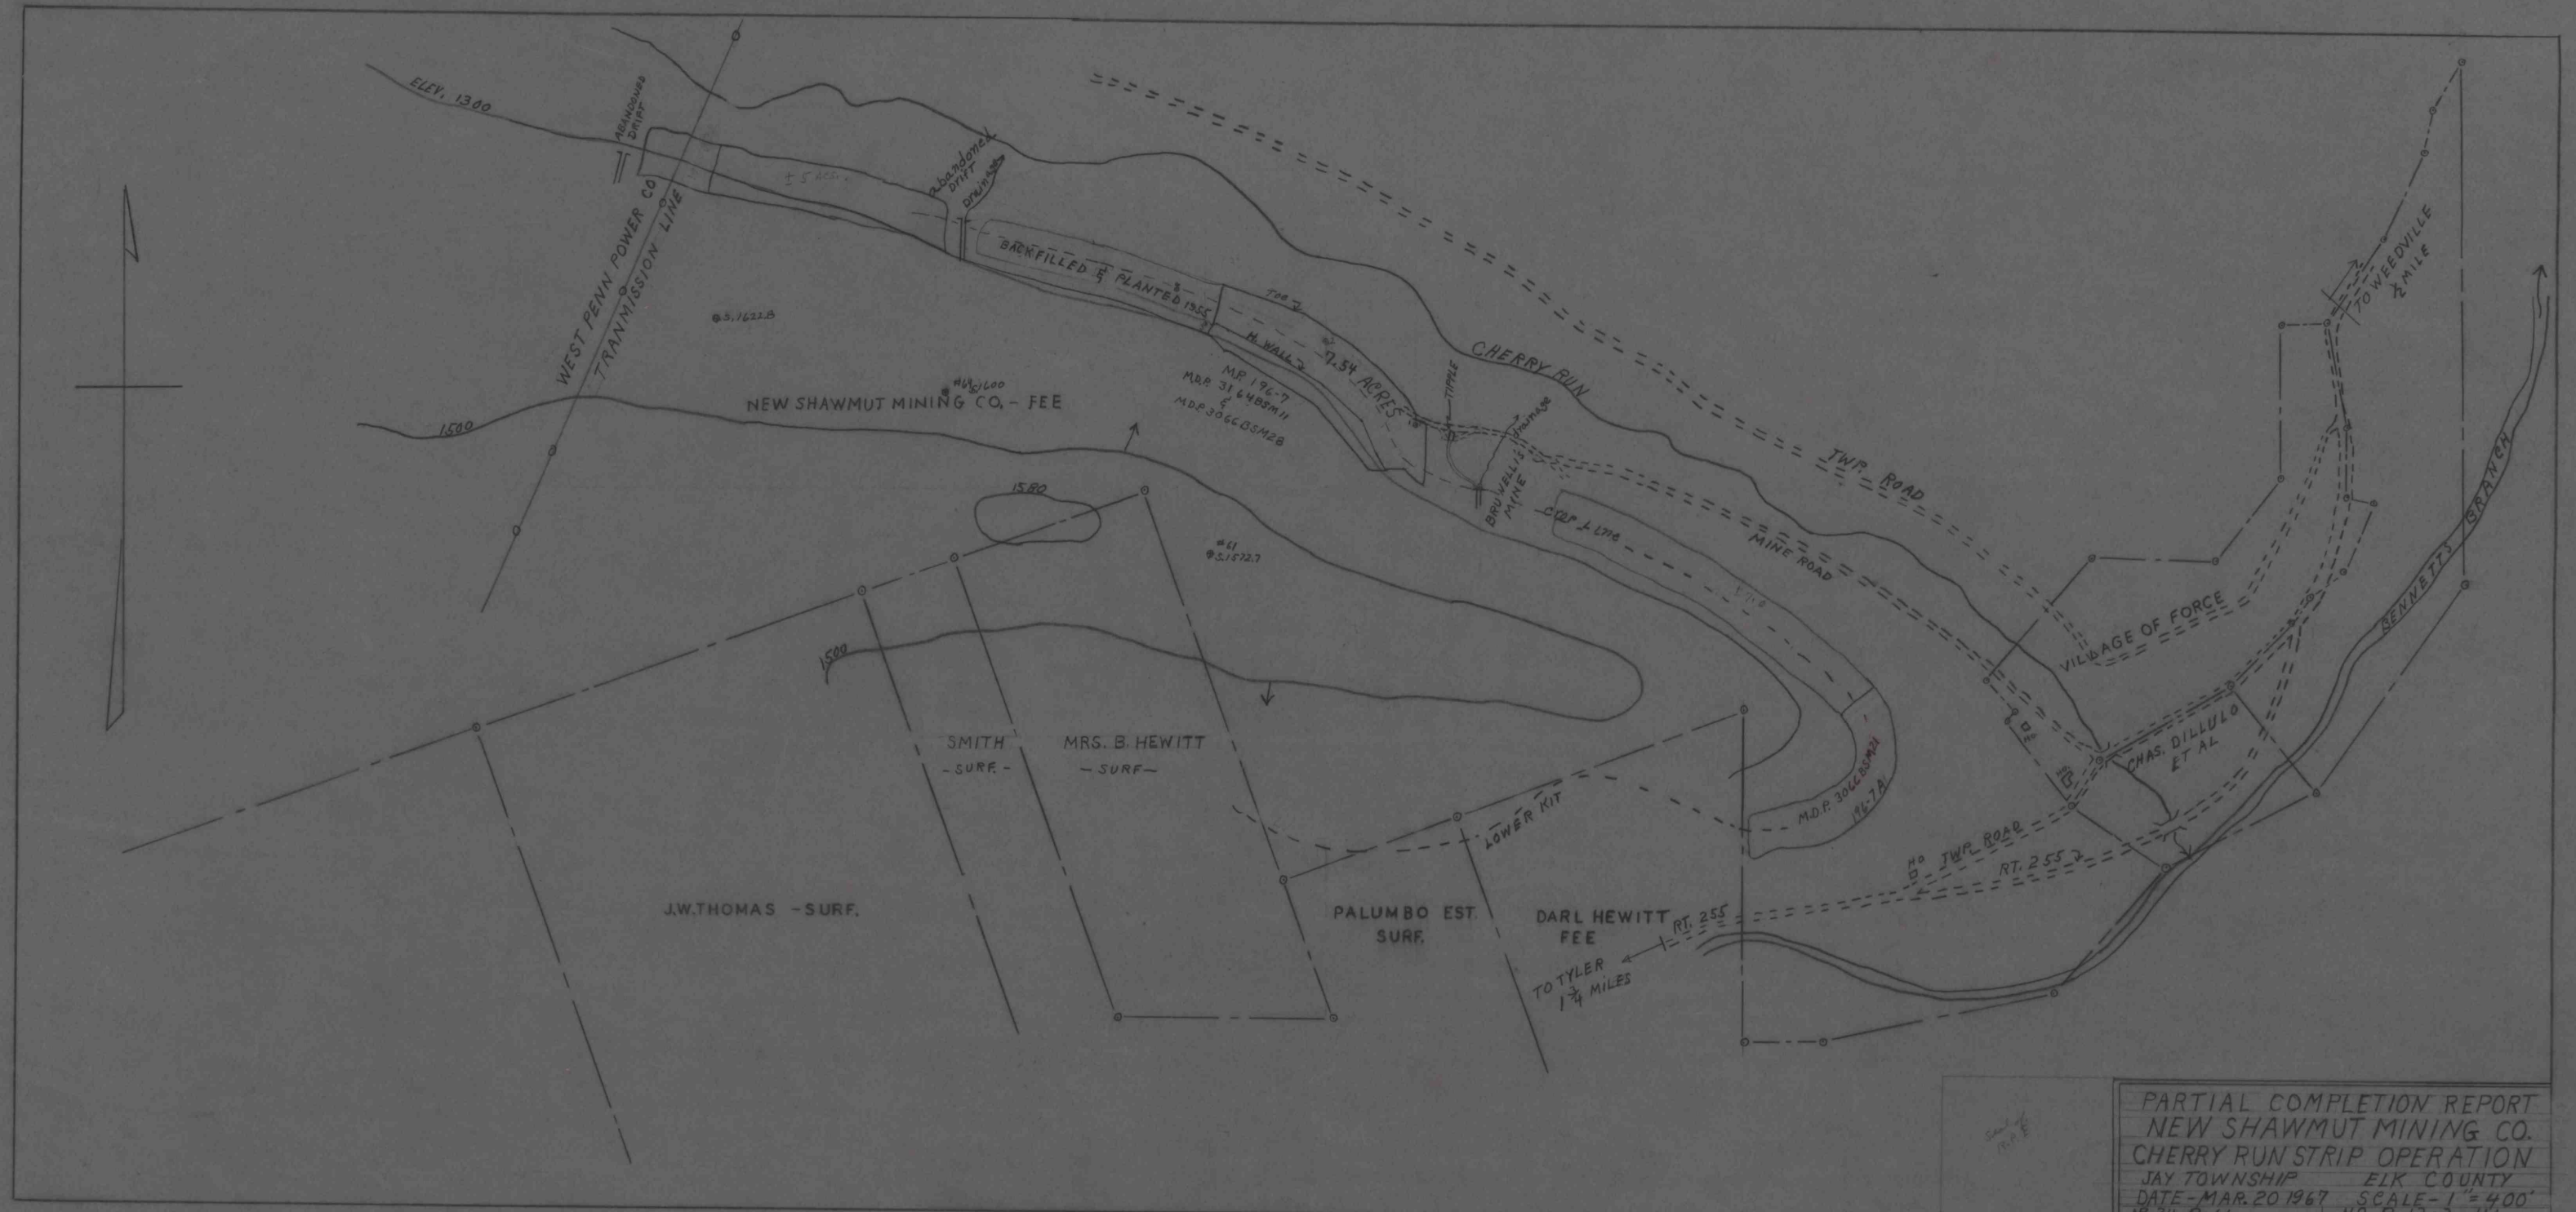

PARTIAL COMPLETION REPORT
 NEW SHAWMUT MINING CO.
 CHERRY RUN STRIP OPERATION
 JAY TOWNSHIP ELK COUNTY
 DATE - MAR. 20 1967 SCALE - 1" = 400'
 NS 24 P-61 NS P 13-2-41

INAPS 16424

Copy made by BS-428