


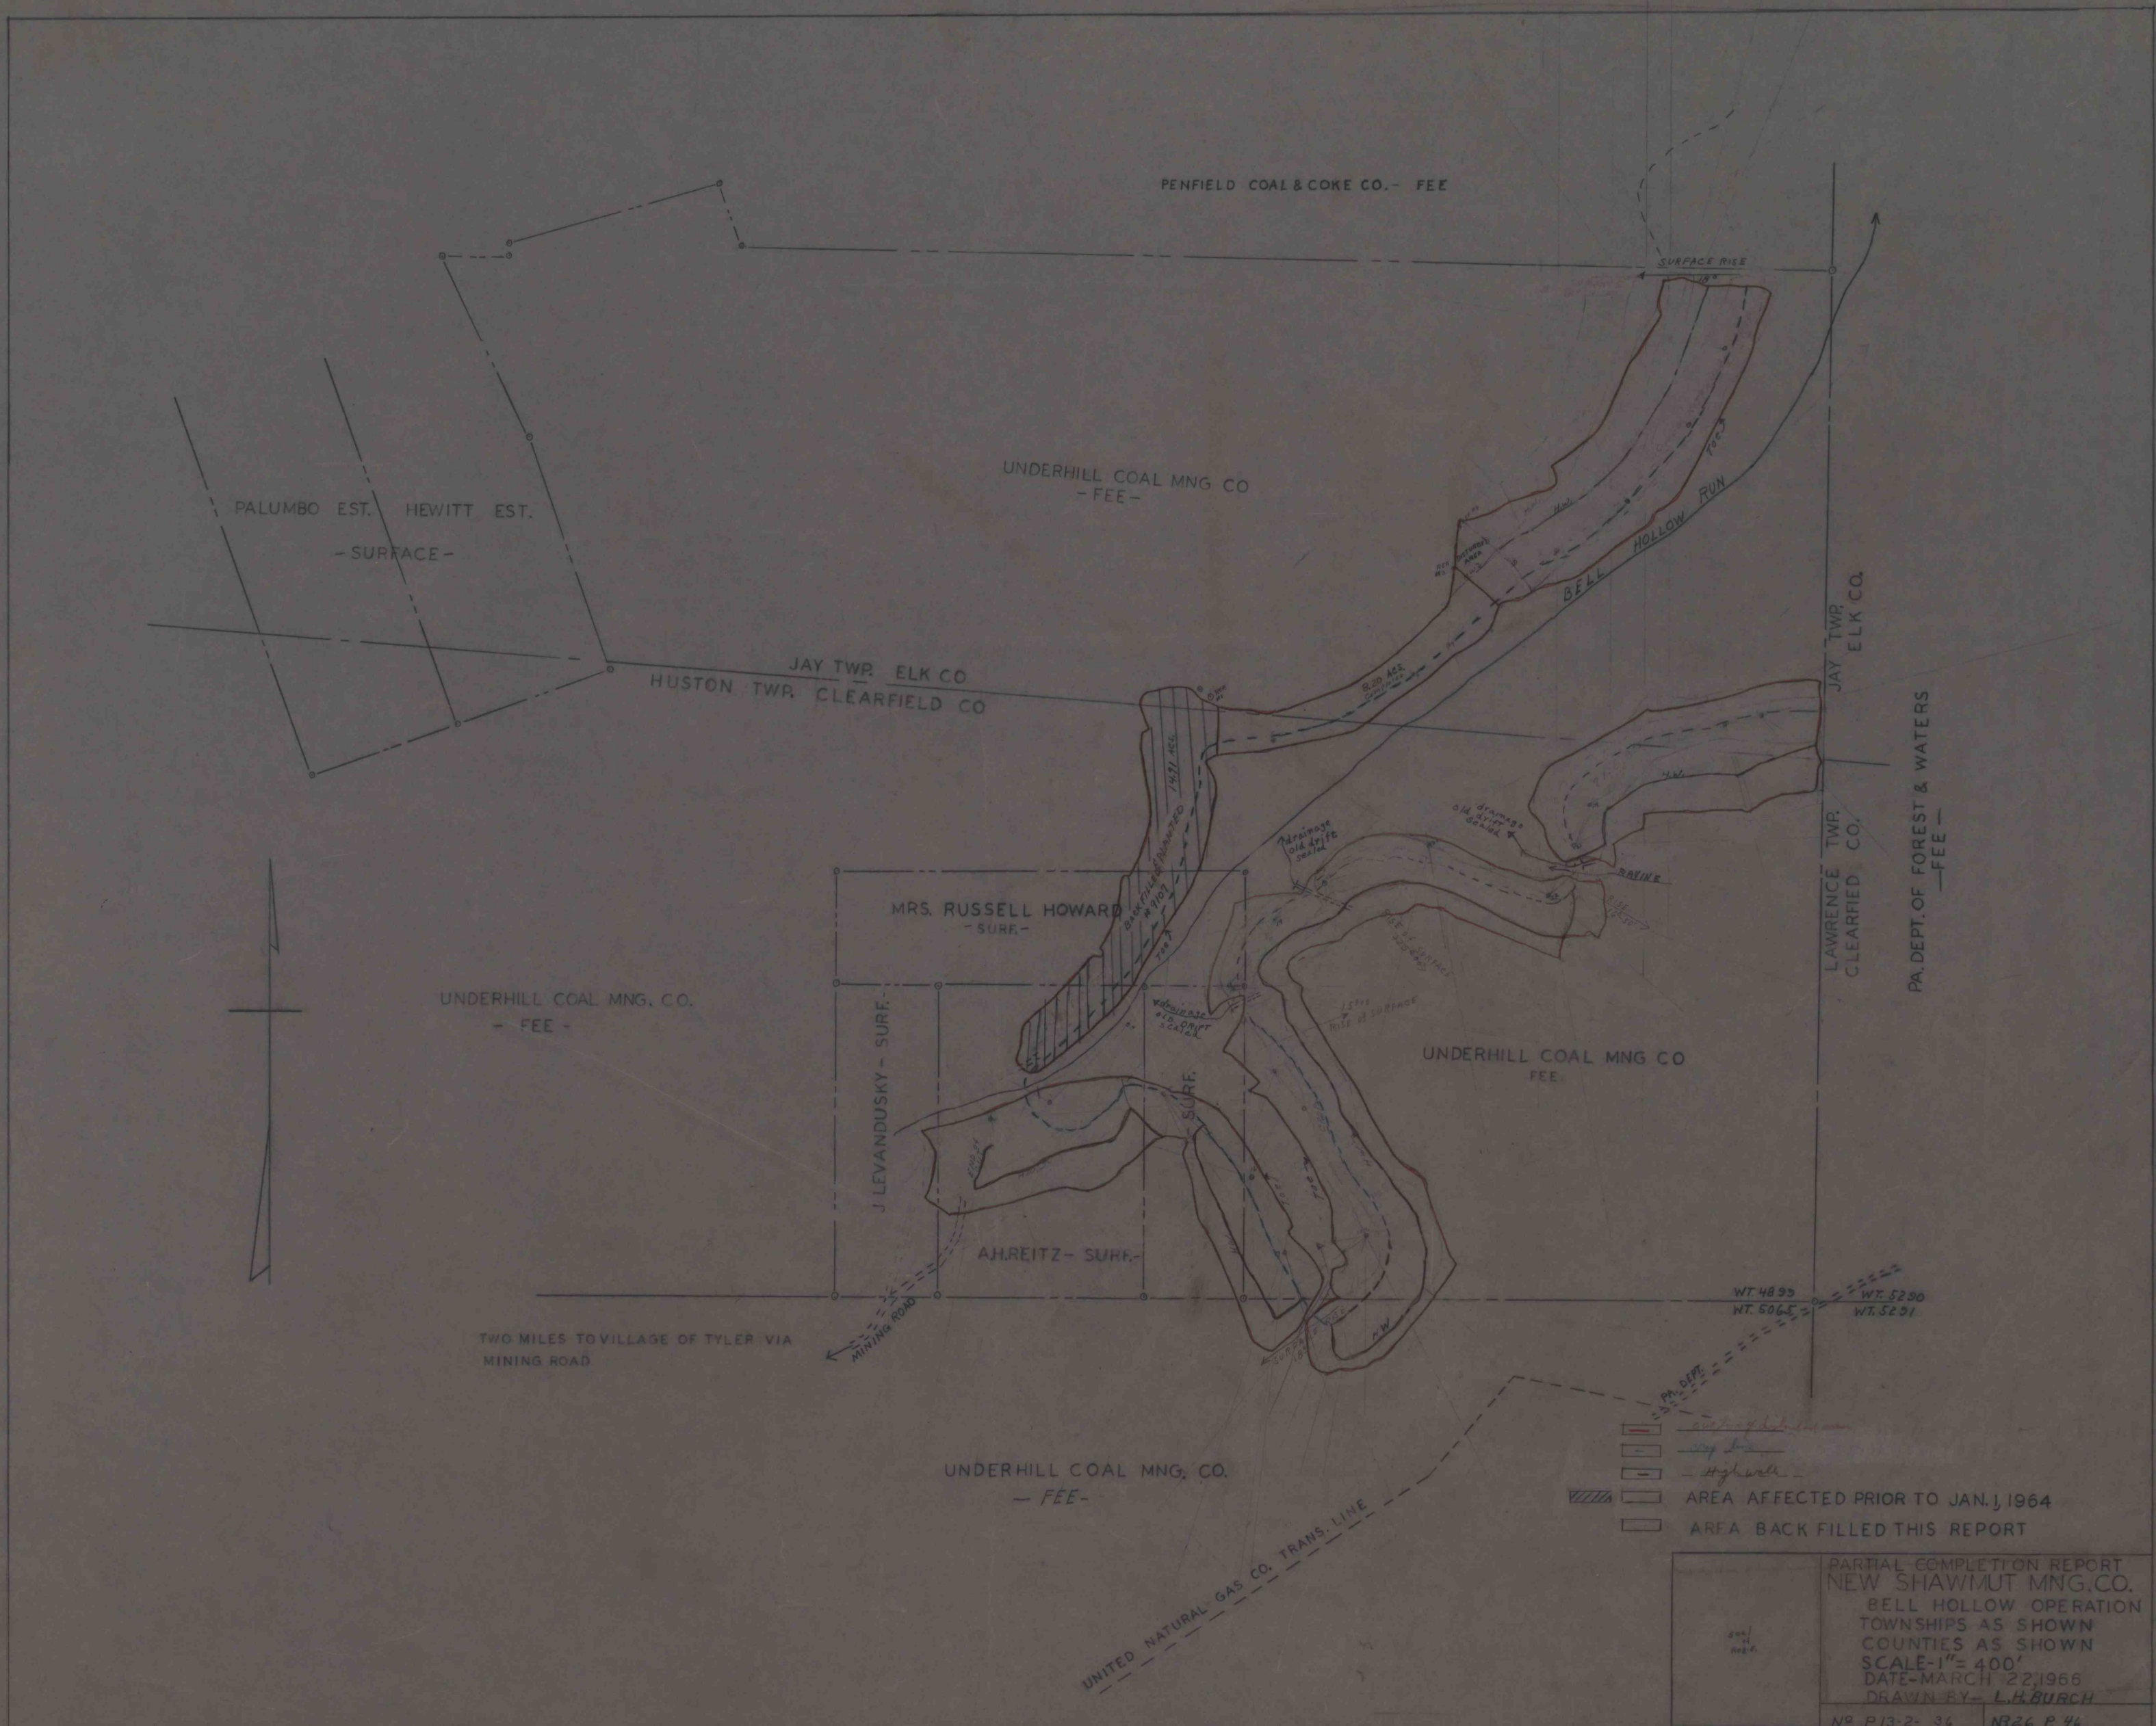

IMAPS# 16425