


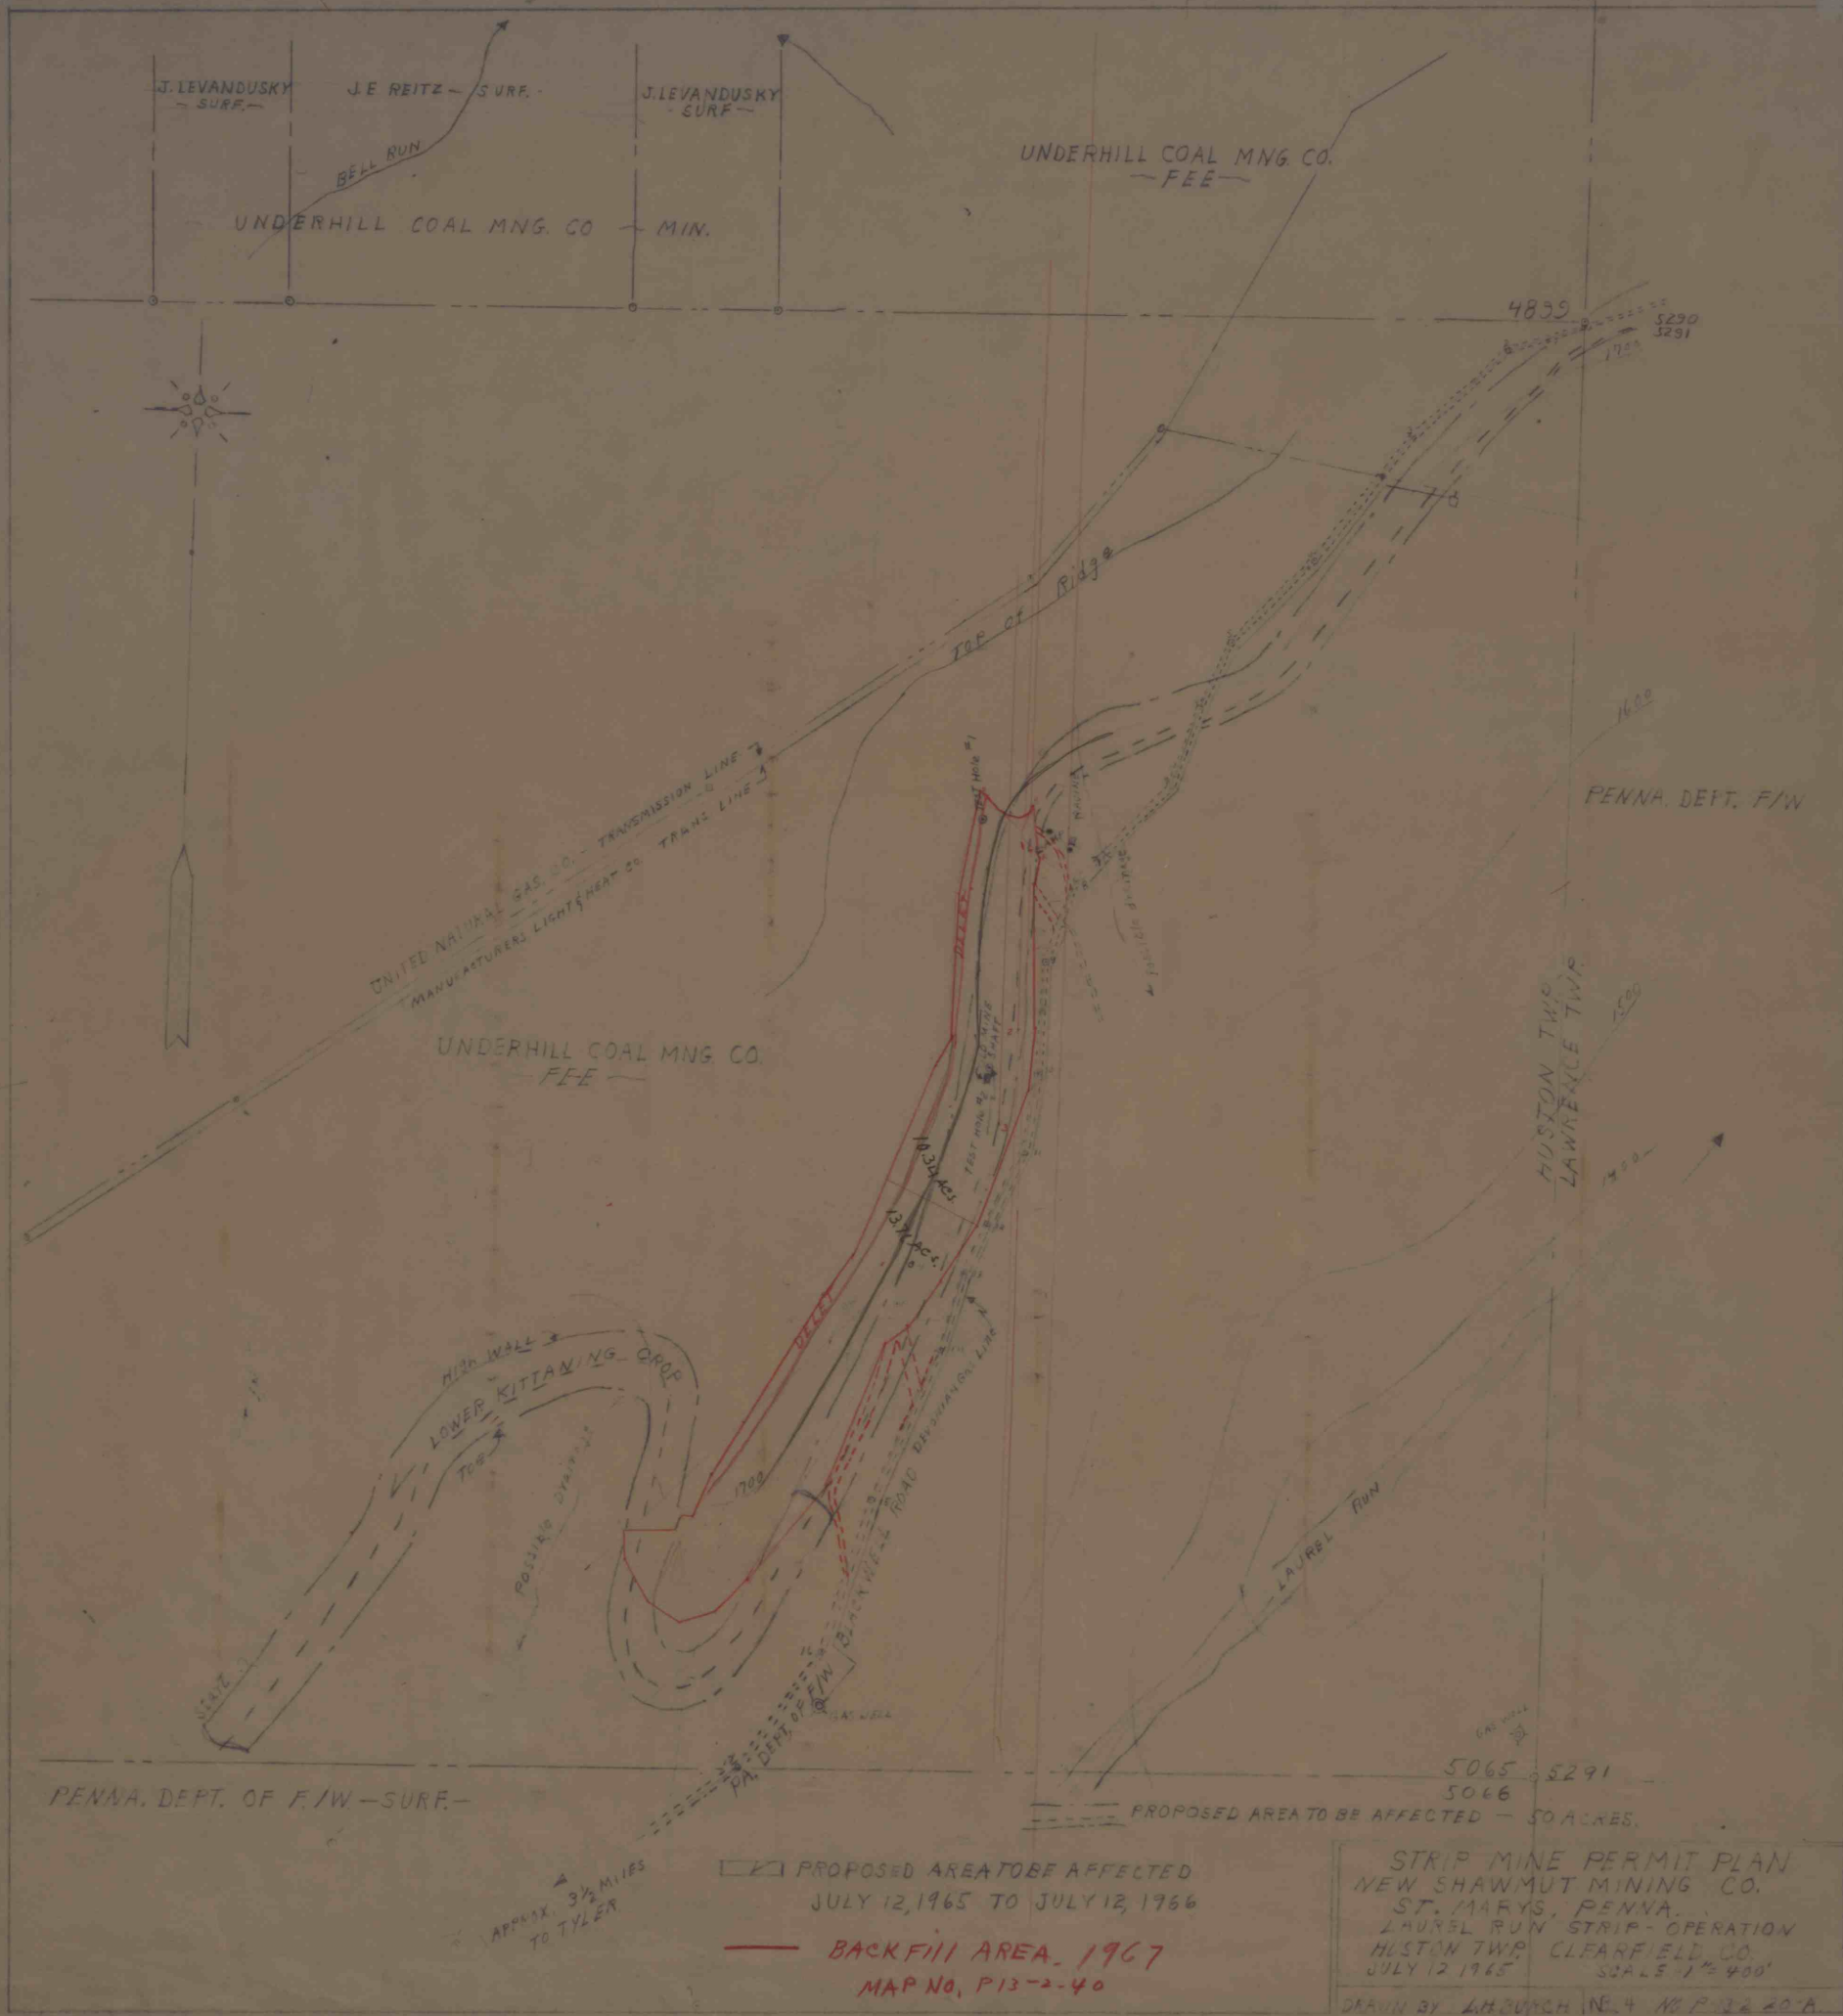

PROPOSED AREA TO BE AFFECTED
JULY 12, 1965 TO JULY 12, 1966

BACKFILL AREA, 1967
MAP NO. P13-2-40

APPROX. 3 1/2 MILES
TO TYLER