


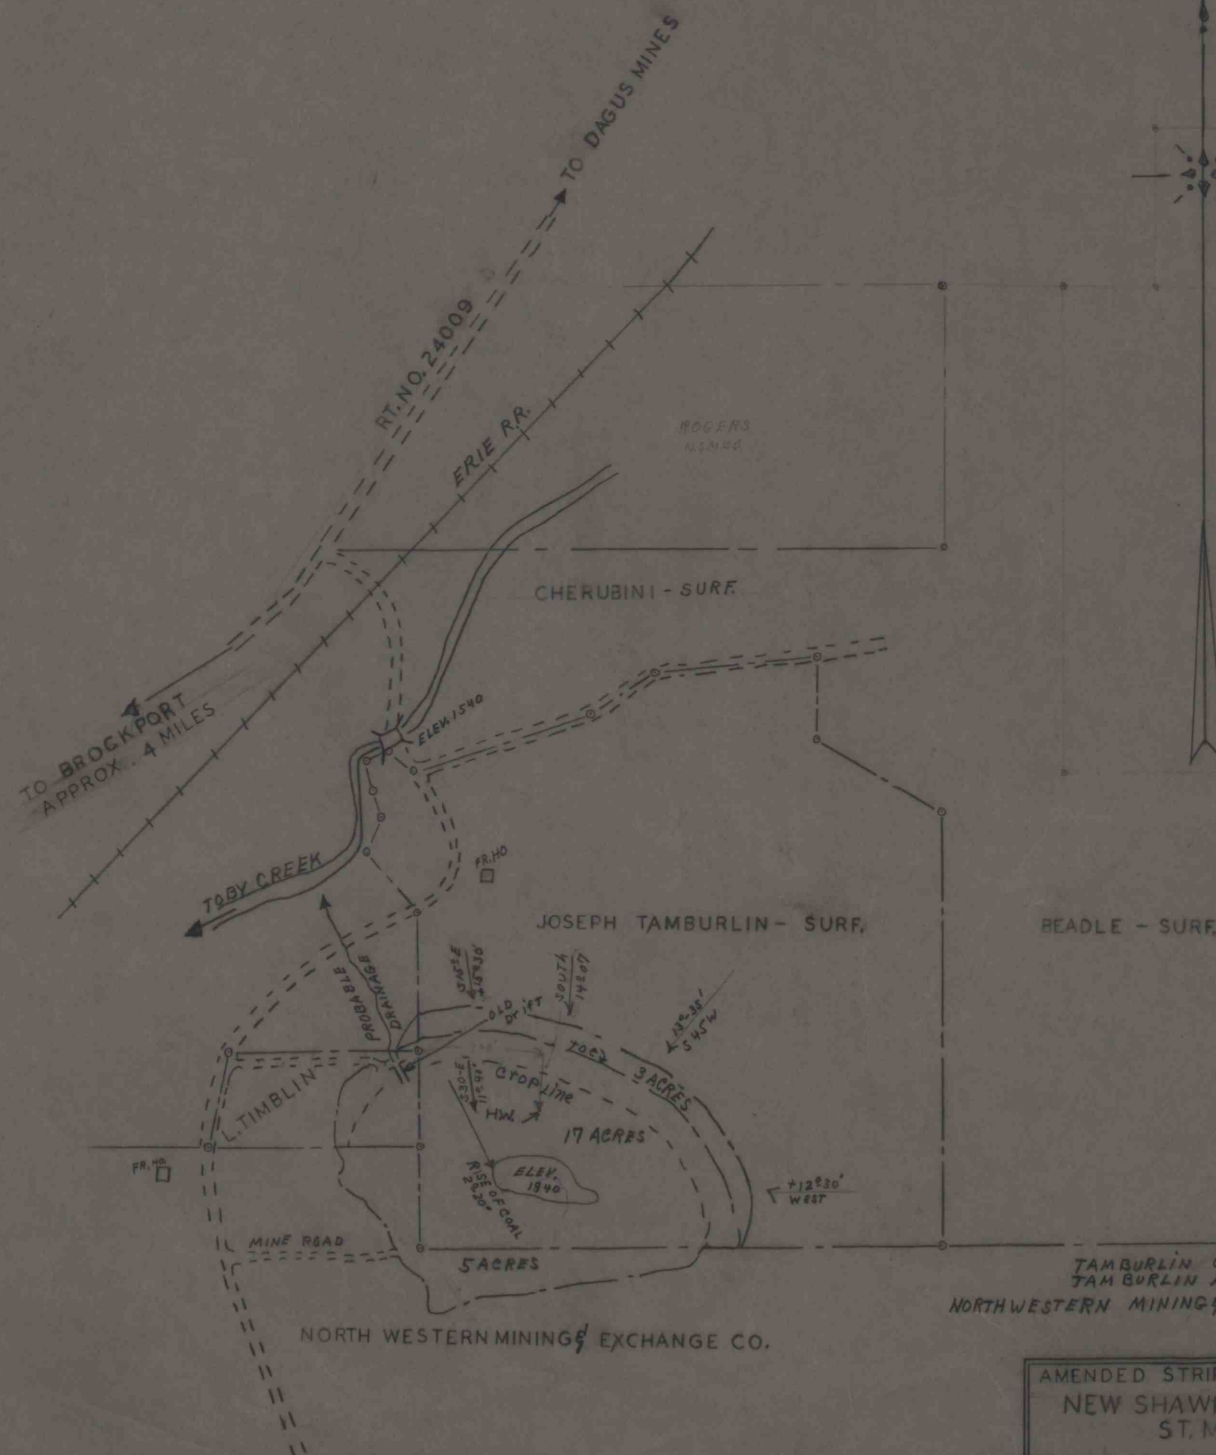

TAMBURLIN ORIGINAL PERMIT 17 ACRES
TAM BURLIN AMENDED PERMIT 3 ACRES
NORTH WESTERN MINING & EX. CO. AMENDED 5 ACRES
TOTAL 25 ACRES

AMENDED STRIP MINING PERMIT PLAN
NEW SHAWMUT MINING COMPANY
ST. MARYS, PA

TAMBURLIN STRIP OPERATION
FOX TOWNSHIP ELK COUNTY
DATE FEB. 24, 1966 SCALE 1"=400'

NB 1424 PG. 50 NO. P13-2 22 A-1

INAPS 16436

DRAWN BY L.H. BURCH

SLOPE
MEASUREMENTS
OBTAINED FOR
BY V. VETTER,
DEPT. OF MINES

See letter
in state
regarding
strip mining
