


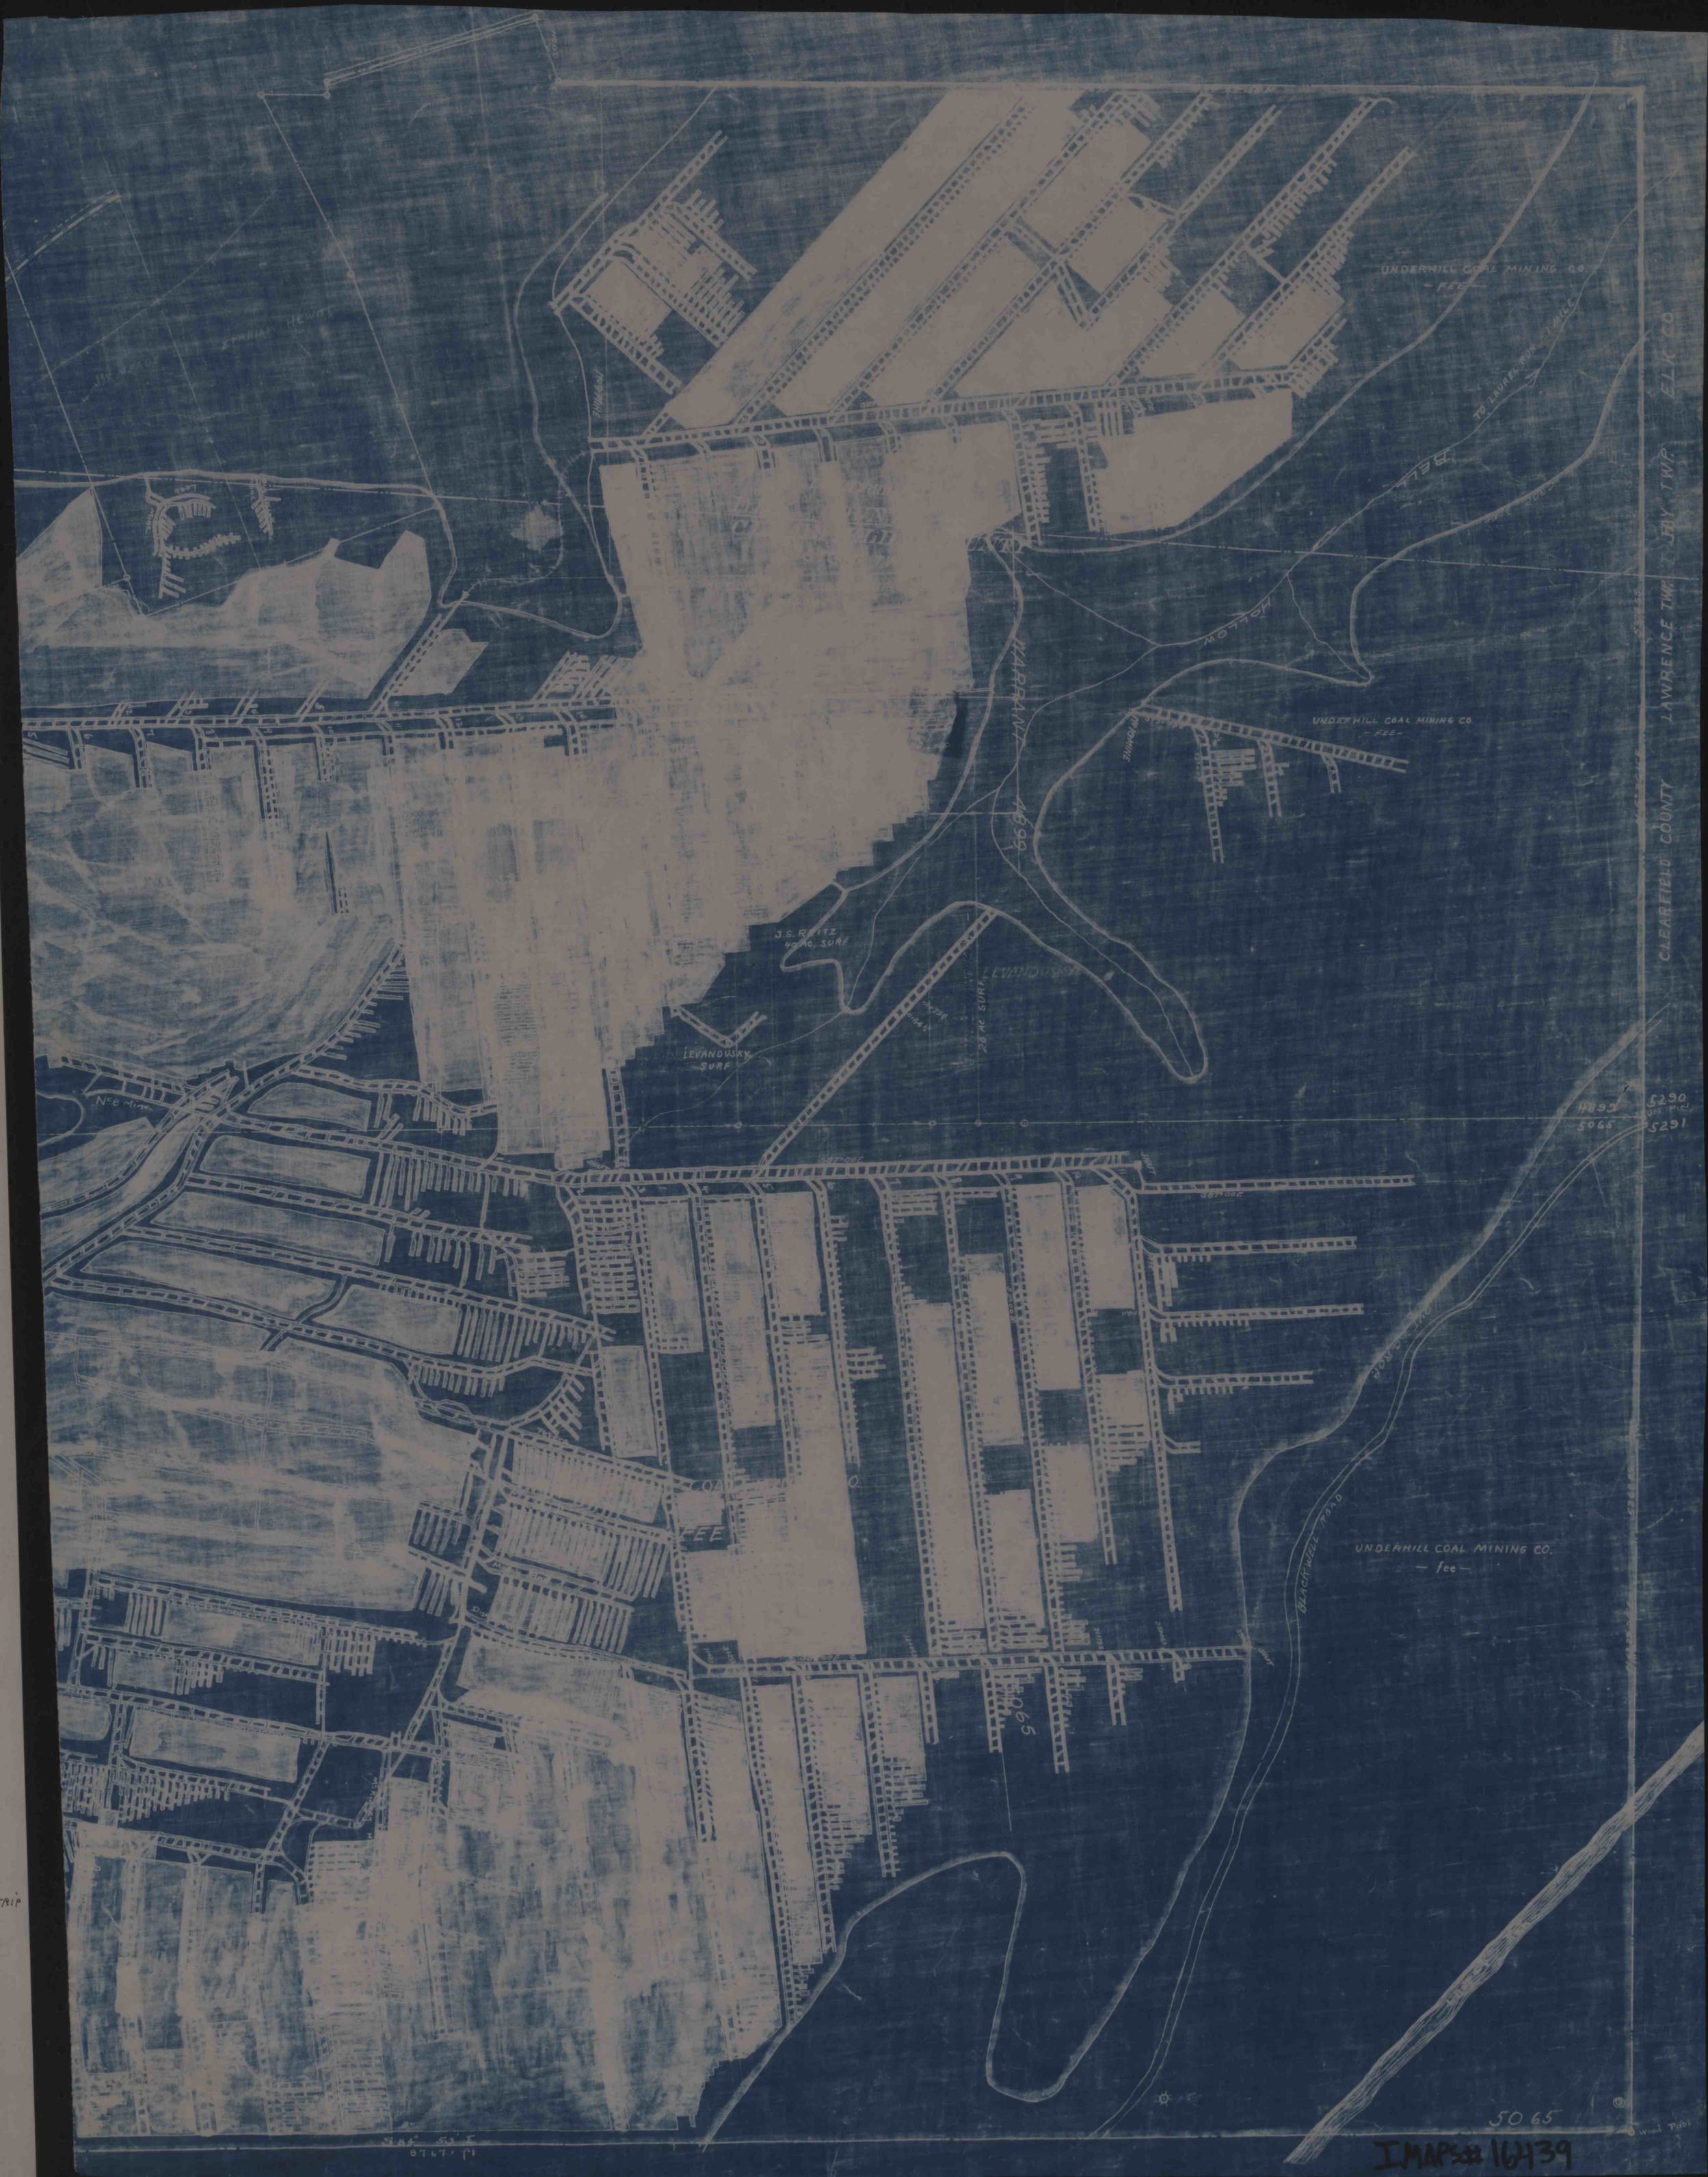

UNDERHILL COAL MINING CO.
- fee -

UNDERHILL COAL MINING CO.
- fee -

J.S. RITZ
40 AC SURF

LEVANDUSKY
SURF

LEVANDUSKY
20 AC SURF

WARRANT
1899

UNDERHILL COAL MINING CO.
- fee -

ELK CO.
LAWRENCE TWP.
CLEARFIELD COUNTY

5290
5291
5065
5066

5065

IMAP# 16439