


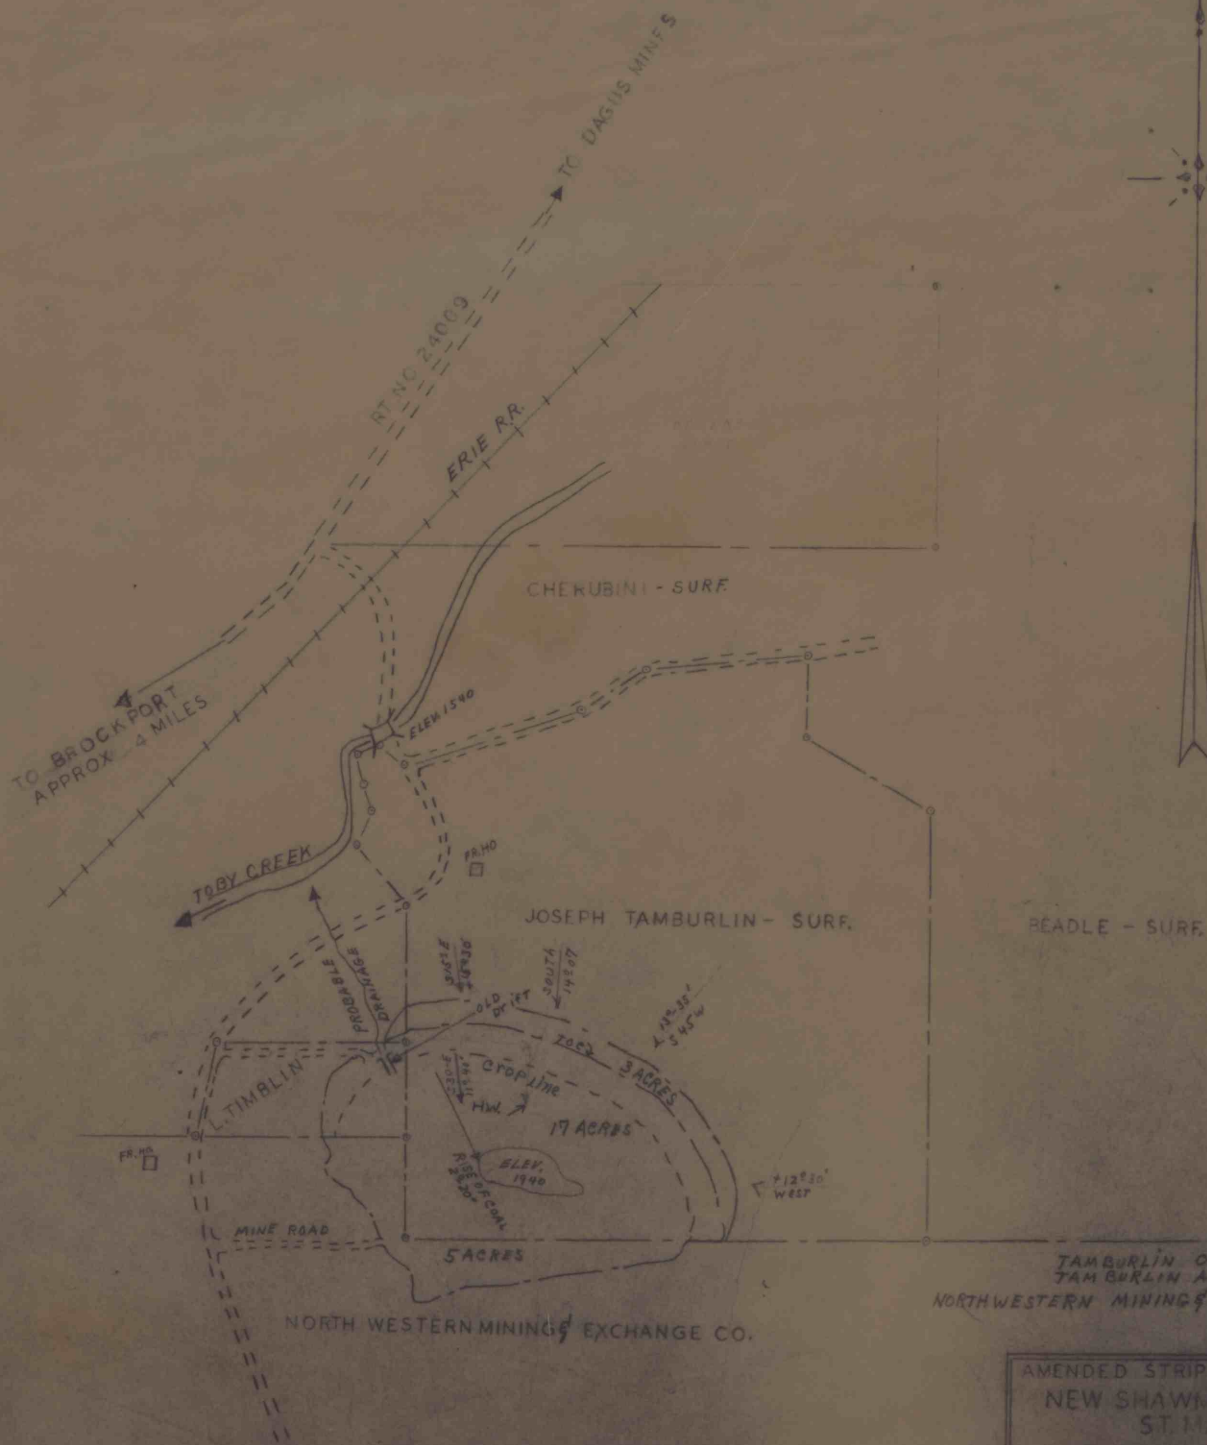

TAMBURLIN ORIGINAL PERMIT 17 ACRES
 TAMBURLIN AMENDED PERMIT 3 ACRES
 NORTHWESTERN MINING & EX. CO. AMENDED 5 ACRES

NORTH WESTERN MINING & EXCHANGE CO.

AMENDED STRIP MINING PERMIT PLAN
 NEW SHAWMUT MINING COMPANY
 ST. MARYS, PA

TAMBURLIN STRIP OPERATION
 FOX TOWNSHIP ELK COUNTY
 DATE FEB. 24, 1966 SCALE 1"=400'

DRAWN BY L.H. BURCH

NB 1024 1050 NO. P13-2 22 A-1

IMAPS 1644-1