


plus change made
Test Hole #2 added

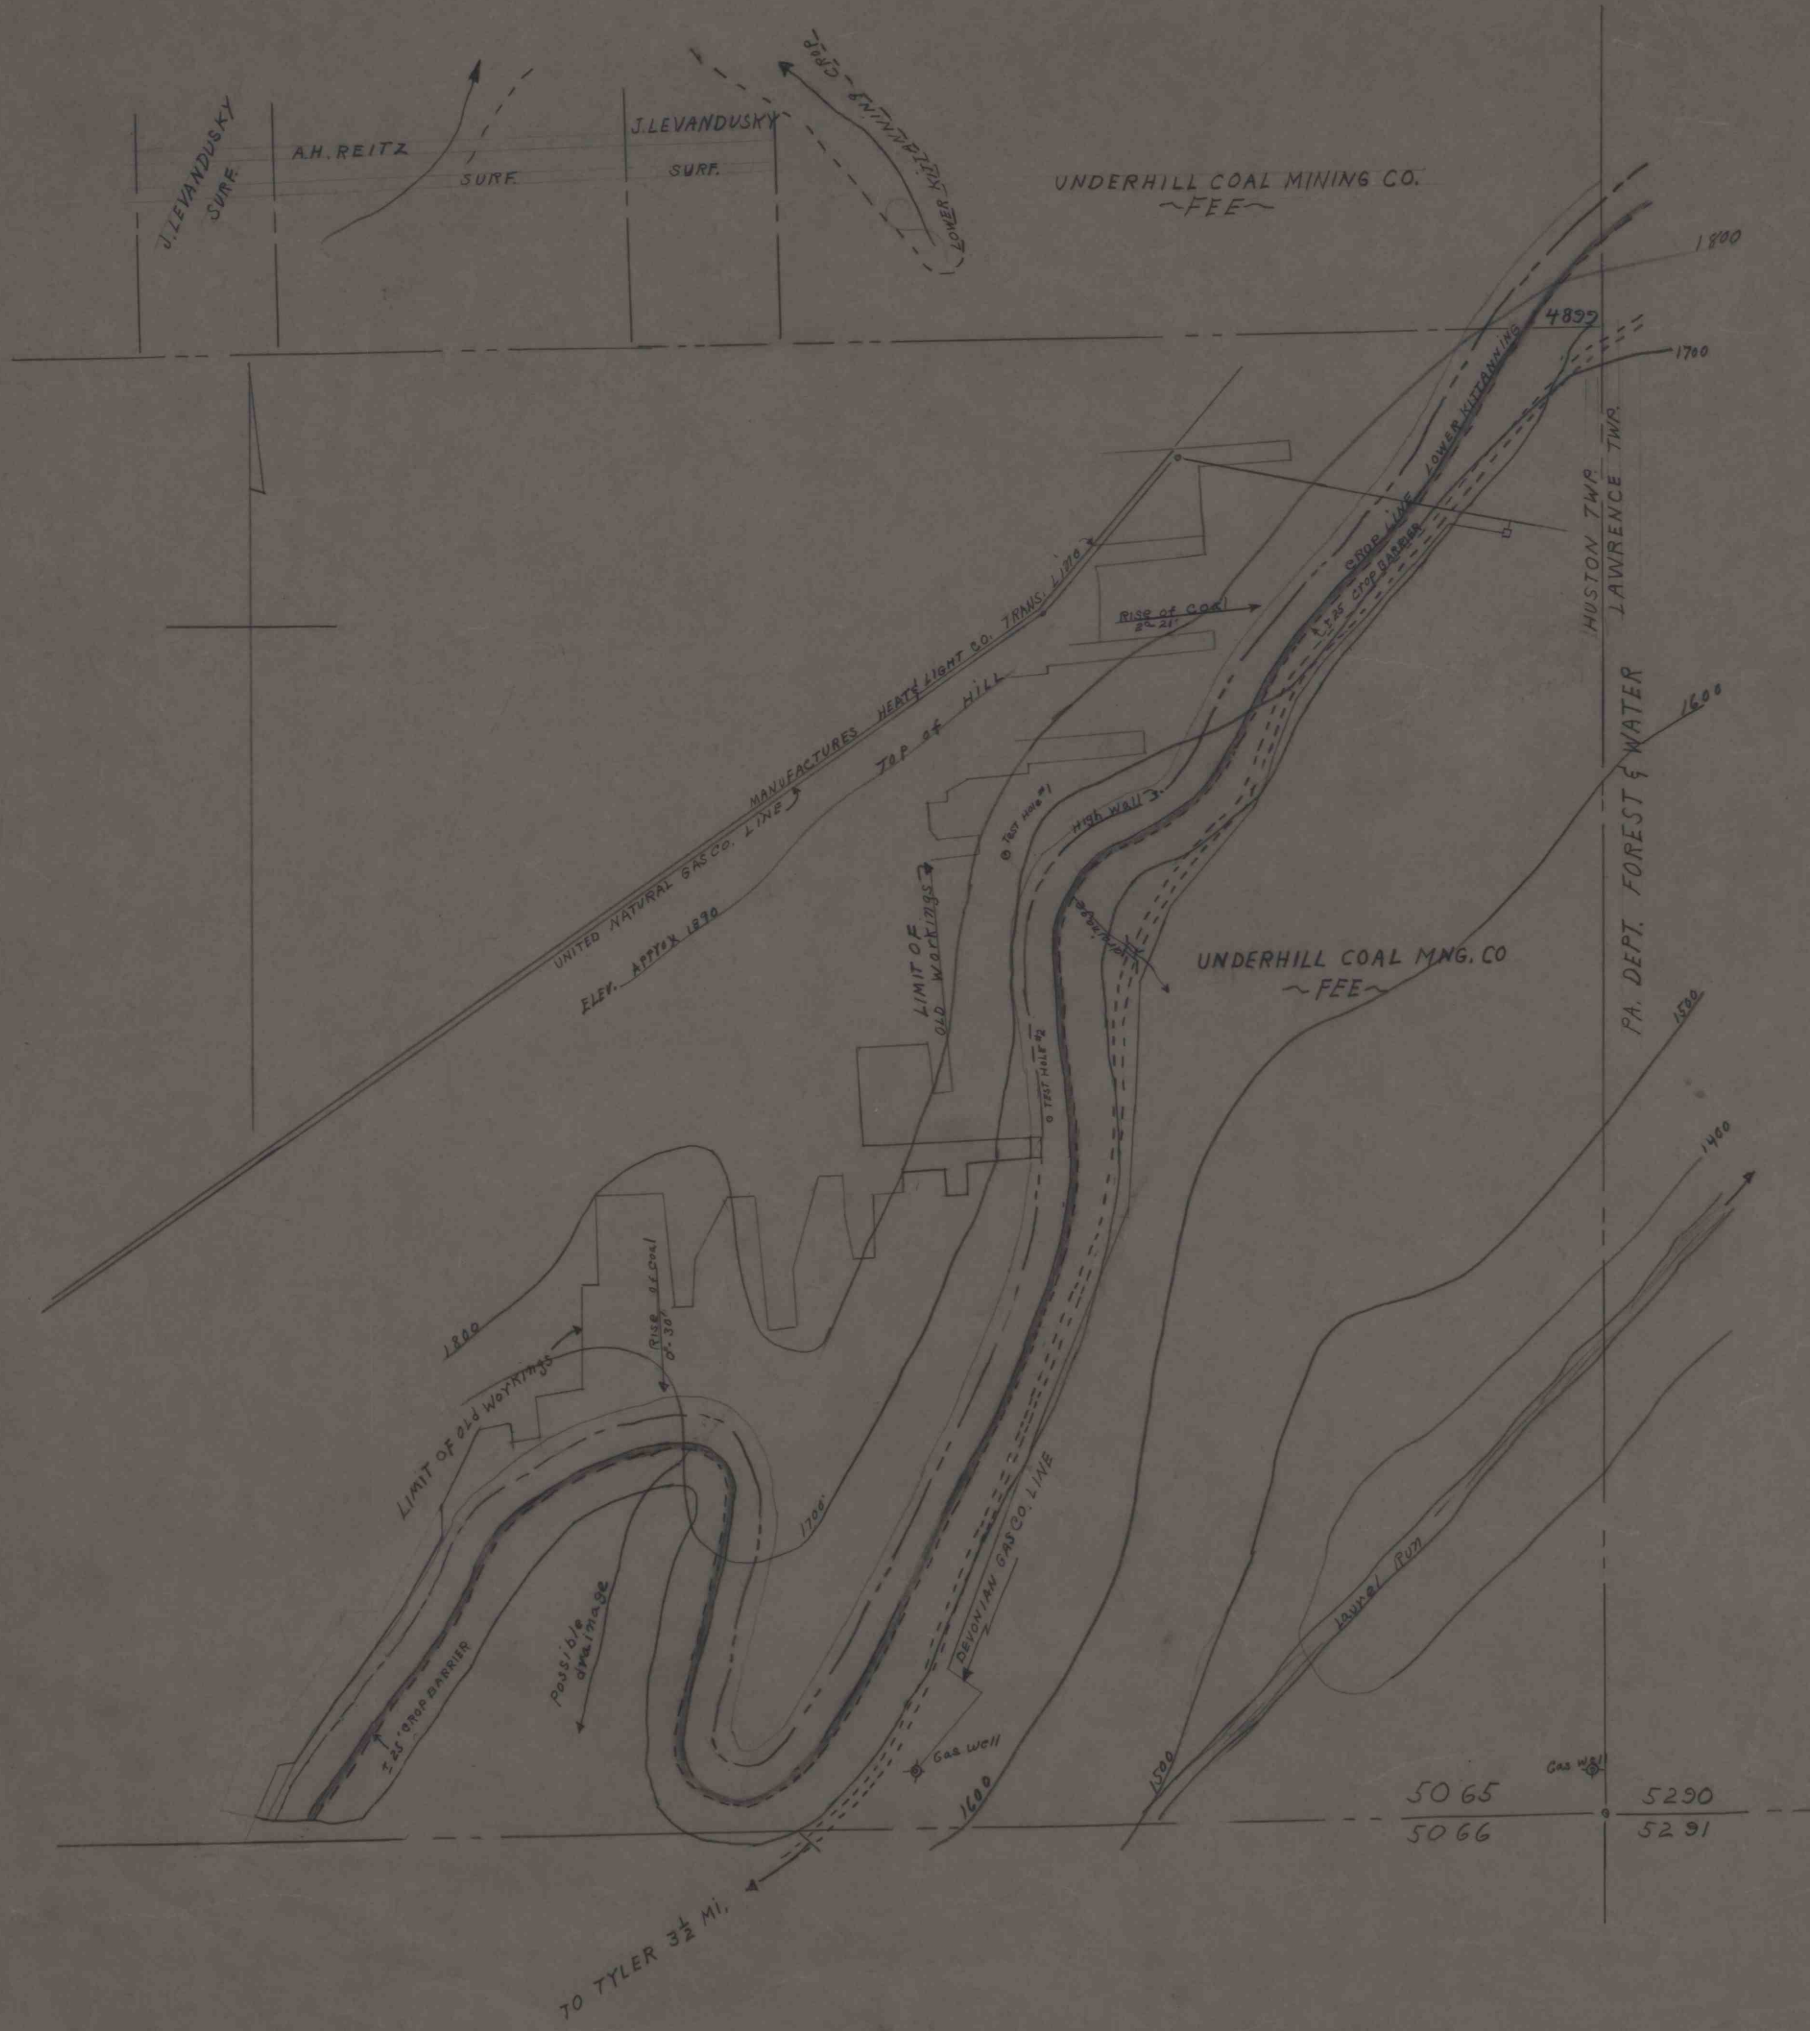

STRIP MINE PERMIT PLAN
NEW SHAWMUT MNG. CO.
LAUREL RUN OPERATION
HUSTON TWP CLEARFIELD CO.
JUNE 27, 1966 SCALE 1"=400'
DRAWN BY L.H. BURCH

IMaps 16443