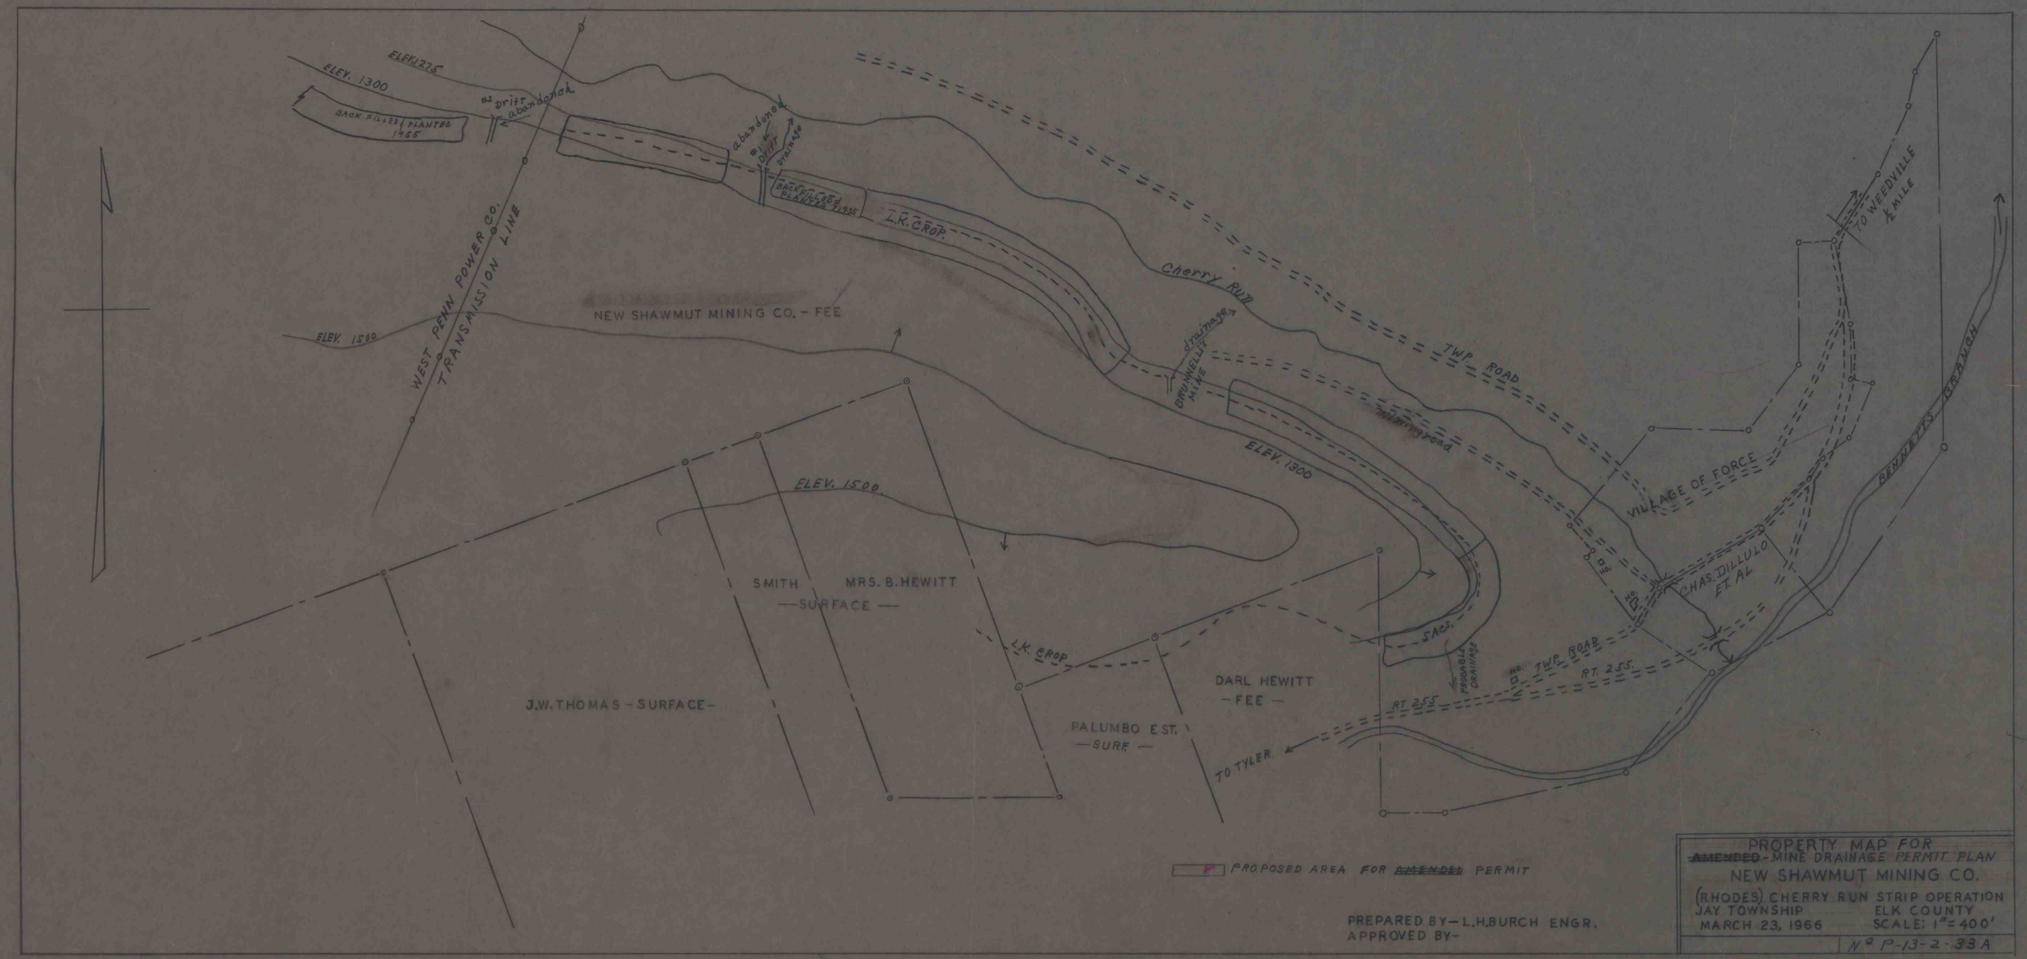

PROPERTY MAP FOR
~~AMENDED~~ - MINE DRAINAGE PERMIT PLAN
NEW SHAWMUT MINING CO.
(RHODES) CHERRY RUN STRIP OPERATION
JAY TOWNSHIP ELK COUNTY
MARCH 23, 1966 SCALE: 1" = 400'
No P-13-2-33A

PREPARED BY—L.H. BURCH ENGR.
APPROVED BY—

IMAPS 16844

addition of same.

3

PROPERTY MAP
FOR MINE DRAINAGE PERMIT
N.S.M.Co.
Cherry RUN OPERATION
JAY TWP. ELK Co.
MAR. 26, 1966 Scale 1" = 400'
PREPARED BY L.H. BURCH
APPROVED BY -----

NOTE:
This same map No was changed from (32A. MINE PERMIT PLAN) TO 33A. MINE Drainage PERMIT PLAN