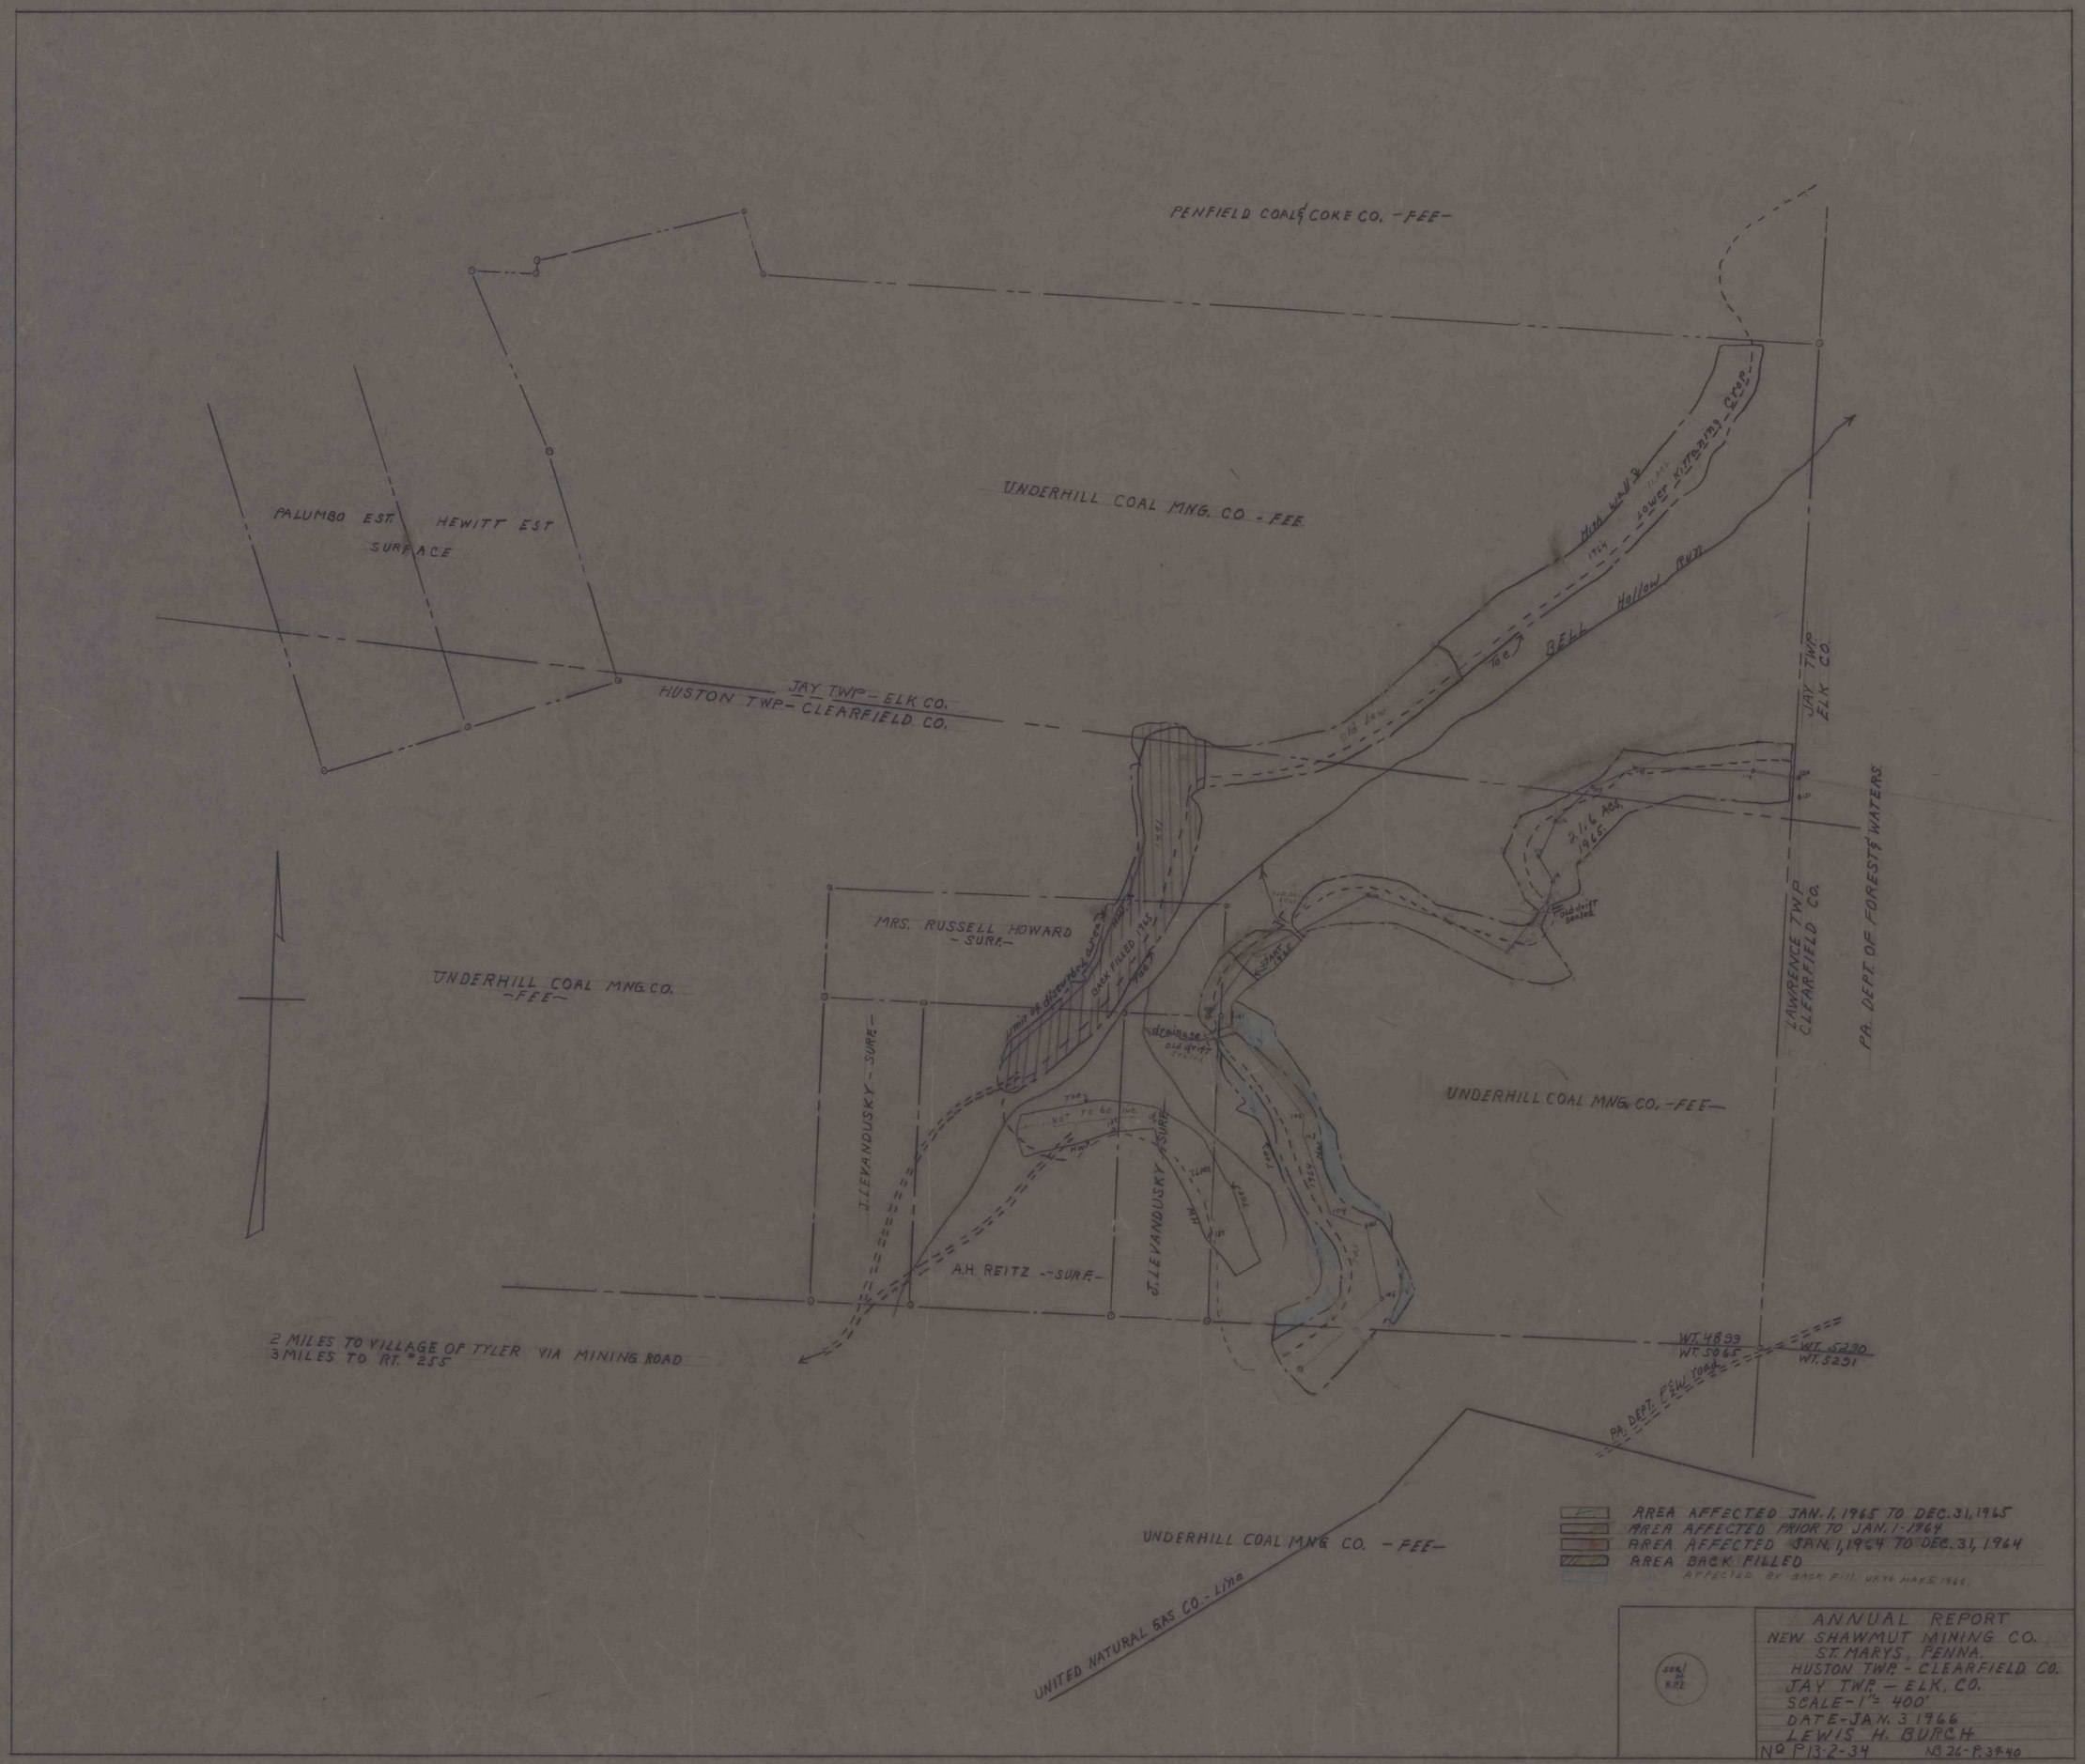
PENFIELD COAL & COKE CO. -FEE-
UNDERHILL COAL MNG. CO. -FEE
PALUMBO EST.
HEWITT EST
SURFACE
JAY TWP - ELK CO.
HUSTON TWP - CLEARFIELD CO.
Hell Hollow Run
Lower Kittanning Crop
JAY TWP
ELK CO.
LAWRENCE TWP
CLEARFIELD CO.
PA. DEPT OF FORESTS & WATERS
MRS. RUSSELL HOWARD
-SURF.-
UNDERHILL COAL MNG. CO.
-FEE-
J. LEVANDUSKY -SURF.-
A.H. REITZ -SURF.-
UNDERHILL COAL MNG. CO. -FEE-
2 MILES TO VILLAGE OF TYLER VIA MINING ROAD
3 MILES TO RT. #255
WT. 4899
WT. 5065
WT. 5230
WT. 5231
PA. DEPT. F&W. road
UNDERHILL COAL MNG. CO. -FEE-
UNITED NATURAL GAS CO. - Line
AREA AFFECTED JAN. 1, 1965 TO DEC. 31, 1965
AREA AFFECTED PRIOR TO JAN. 1-1964
AREA AFFECTED JAN. 1, 1964 TO DEC. 31, 1964
AREA BACK FILLED
AFFECTED BY BACK FILL. VERIF. MAY 5, 1966.
ANNUAL REPORT
NEW SHAWMUT MINING CO.
ST. MARYS, PENNA.
HUSTON TWP. - CLEARFIELD CO.
JAY TWP. — ELK. CO.
SCALE - 1" = 400'
DATE - JAN. 3 1966
LEWIS H. BURCH
No P13-2-34 NB 26-P. 39-40

IMAPS# 16446